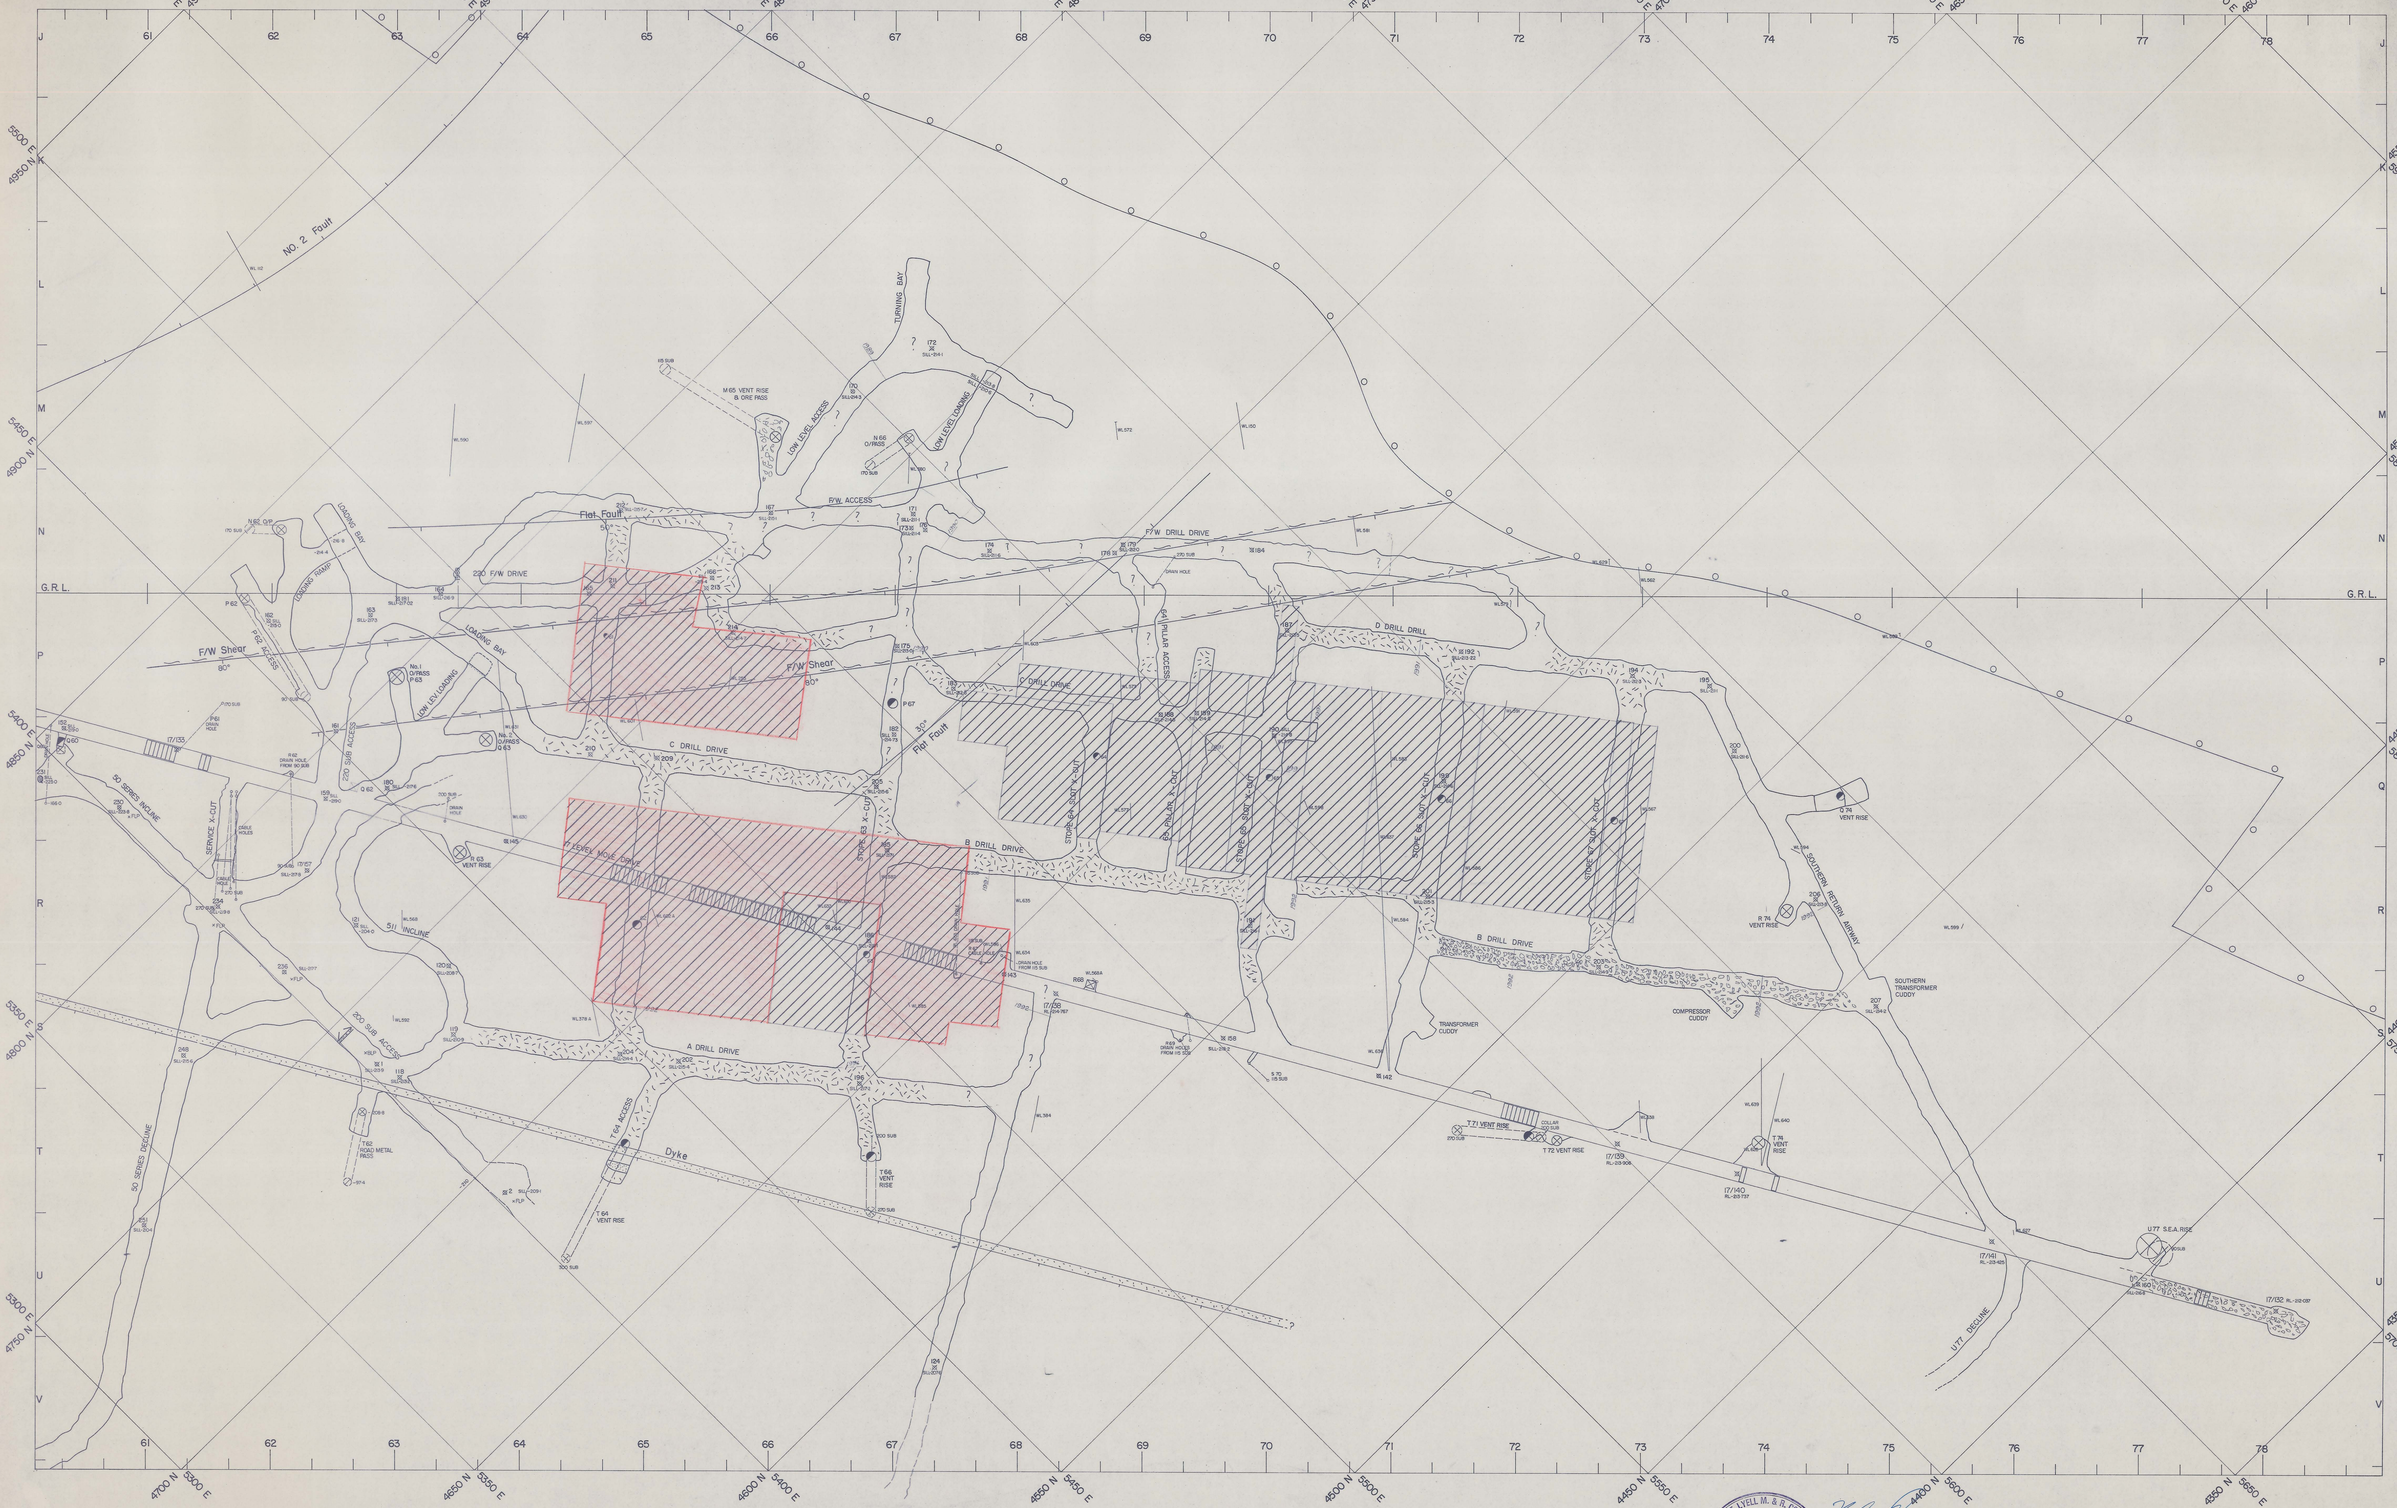

THE MT. LYELL M. & R. CO. LTD.
Incorporated in Victoria
ACN 004 052 457
QUEENSTOWN, TAS. 7467

23 JAN 1995

Resources Manager

UPDATED 21-12-93

5 cm

JAN – DEC 1994 DRG. NO. AO-601 SUPERSEDES AO-77a

THE MOUNT LYELL M.& R. CO. LTD.	DRAWN	APPROVED
	CHECKED	APPROVED
DATE: SCALE: 1:500	CHECKED	APPROVED
PRINCE LYELL MINE 220 SUB-LEVEL 60 SERIES	DRAWING NUMBER AO-601	
	SHEET NUMBER —	

0381 - 024