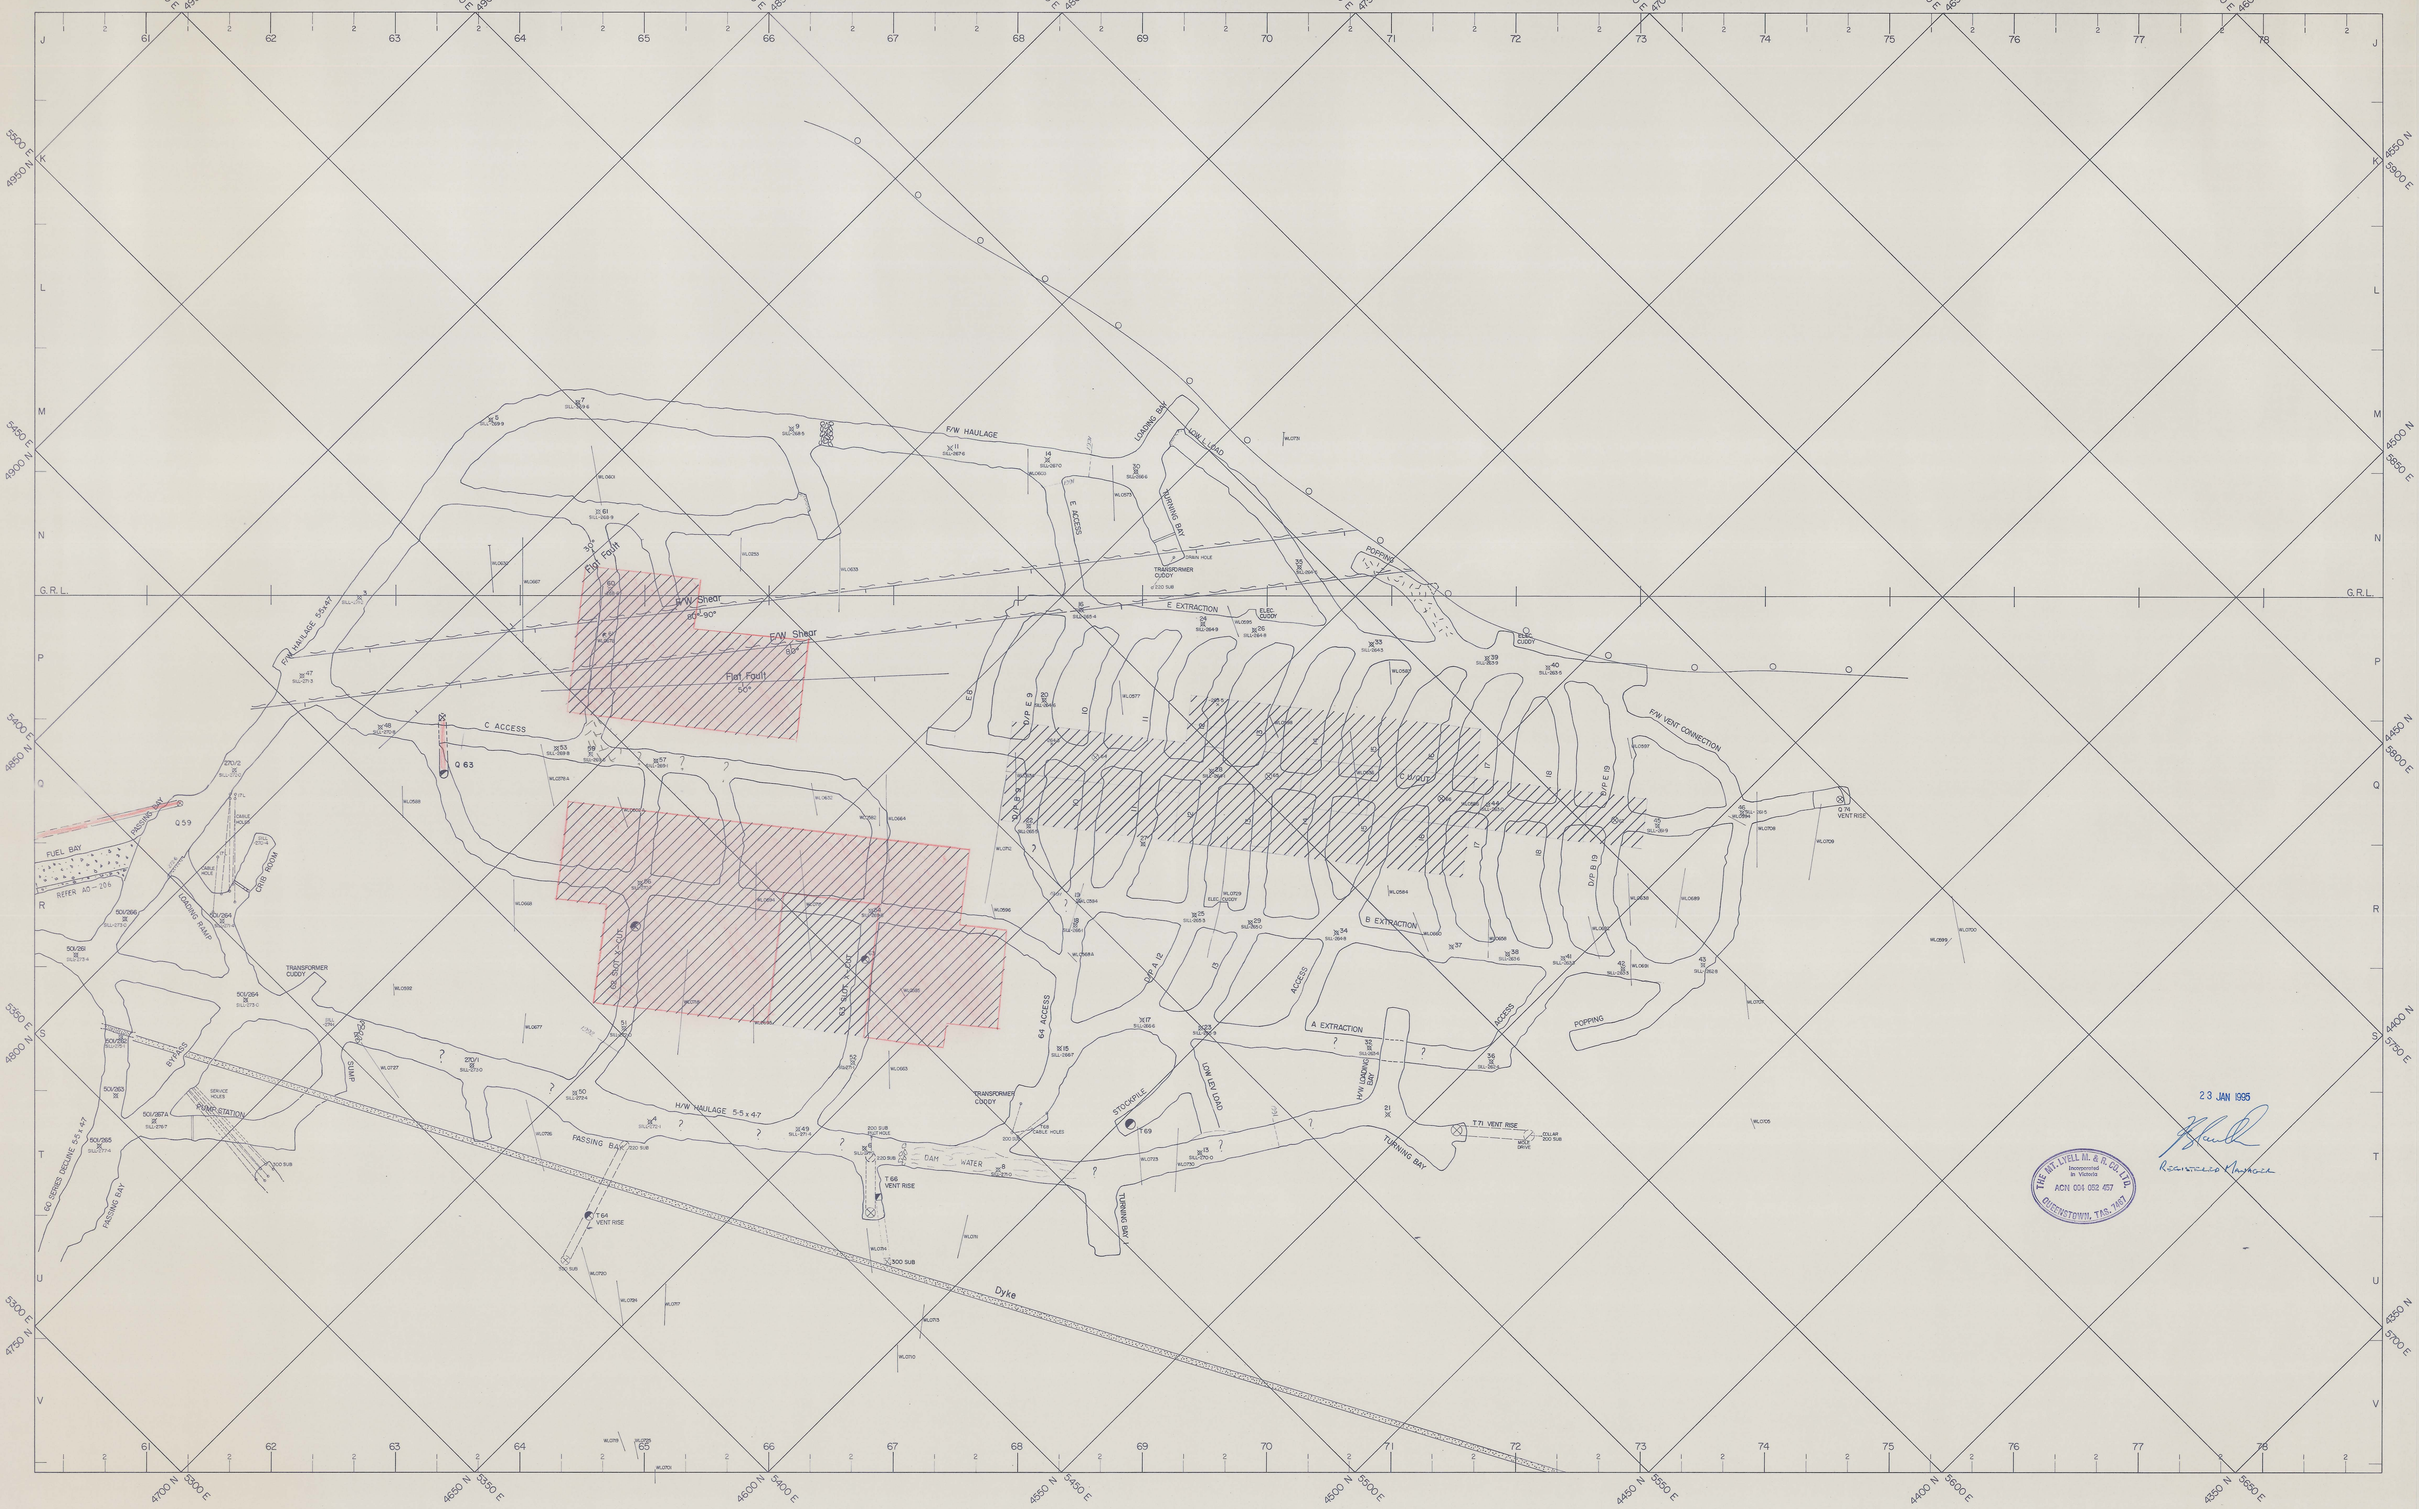

23 JAN 1995

THE MT. LYELL M. & R. CO. LTD.
Incorporated in Victoria
ACN 004 052 457
QUEENSTOWN, TAS. 7467

Survey station, Line pegs FLP, BLP
Rise – down
Rise – through
Rise – up
Sets
Ore outline
Conglomerate contact
Fault zone
Cable hole
Diamond drill hole collar
Diamond drill hole intersection
Diamond drill hole, end of hole
Shear
Lamprophyre Dyke

JAN - DEC 1994

UPDATED 31/6/95

5 cm

THE MOUNT LYELL M. & R. CO. LTD.		DRAWN	APPROVED
		CHECKED	APPROVED
DATE: OCT. 1991	SCALE: 1:500	CHECKED	APPROVED
PRINCE LYELL MINE 270 SUB-LEVEL 60 SERIES		DRAWING NUMBER AO-602	
		SHEET NUMBER —	

0381-025