


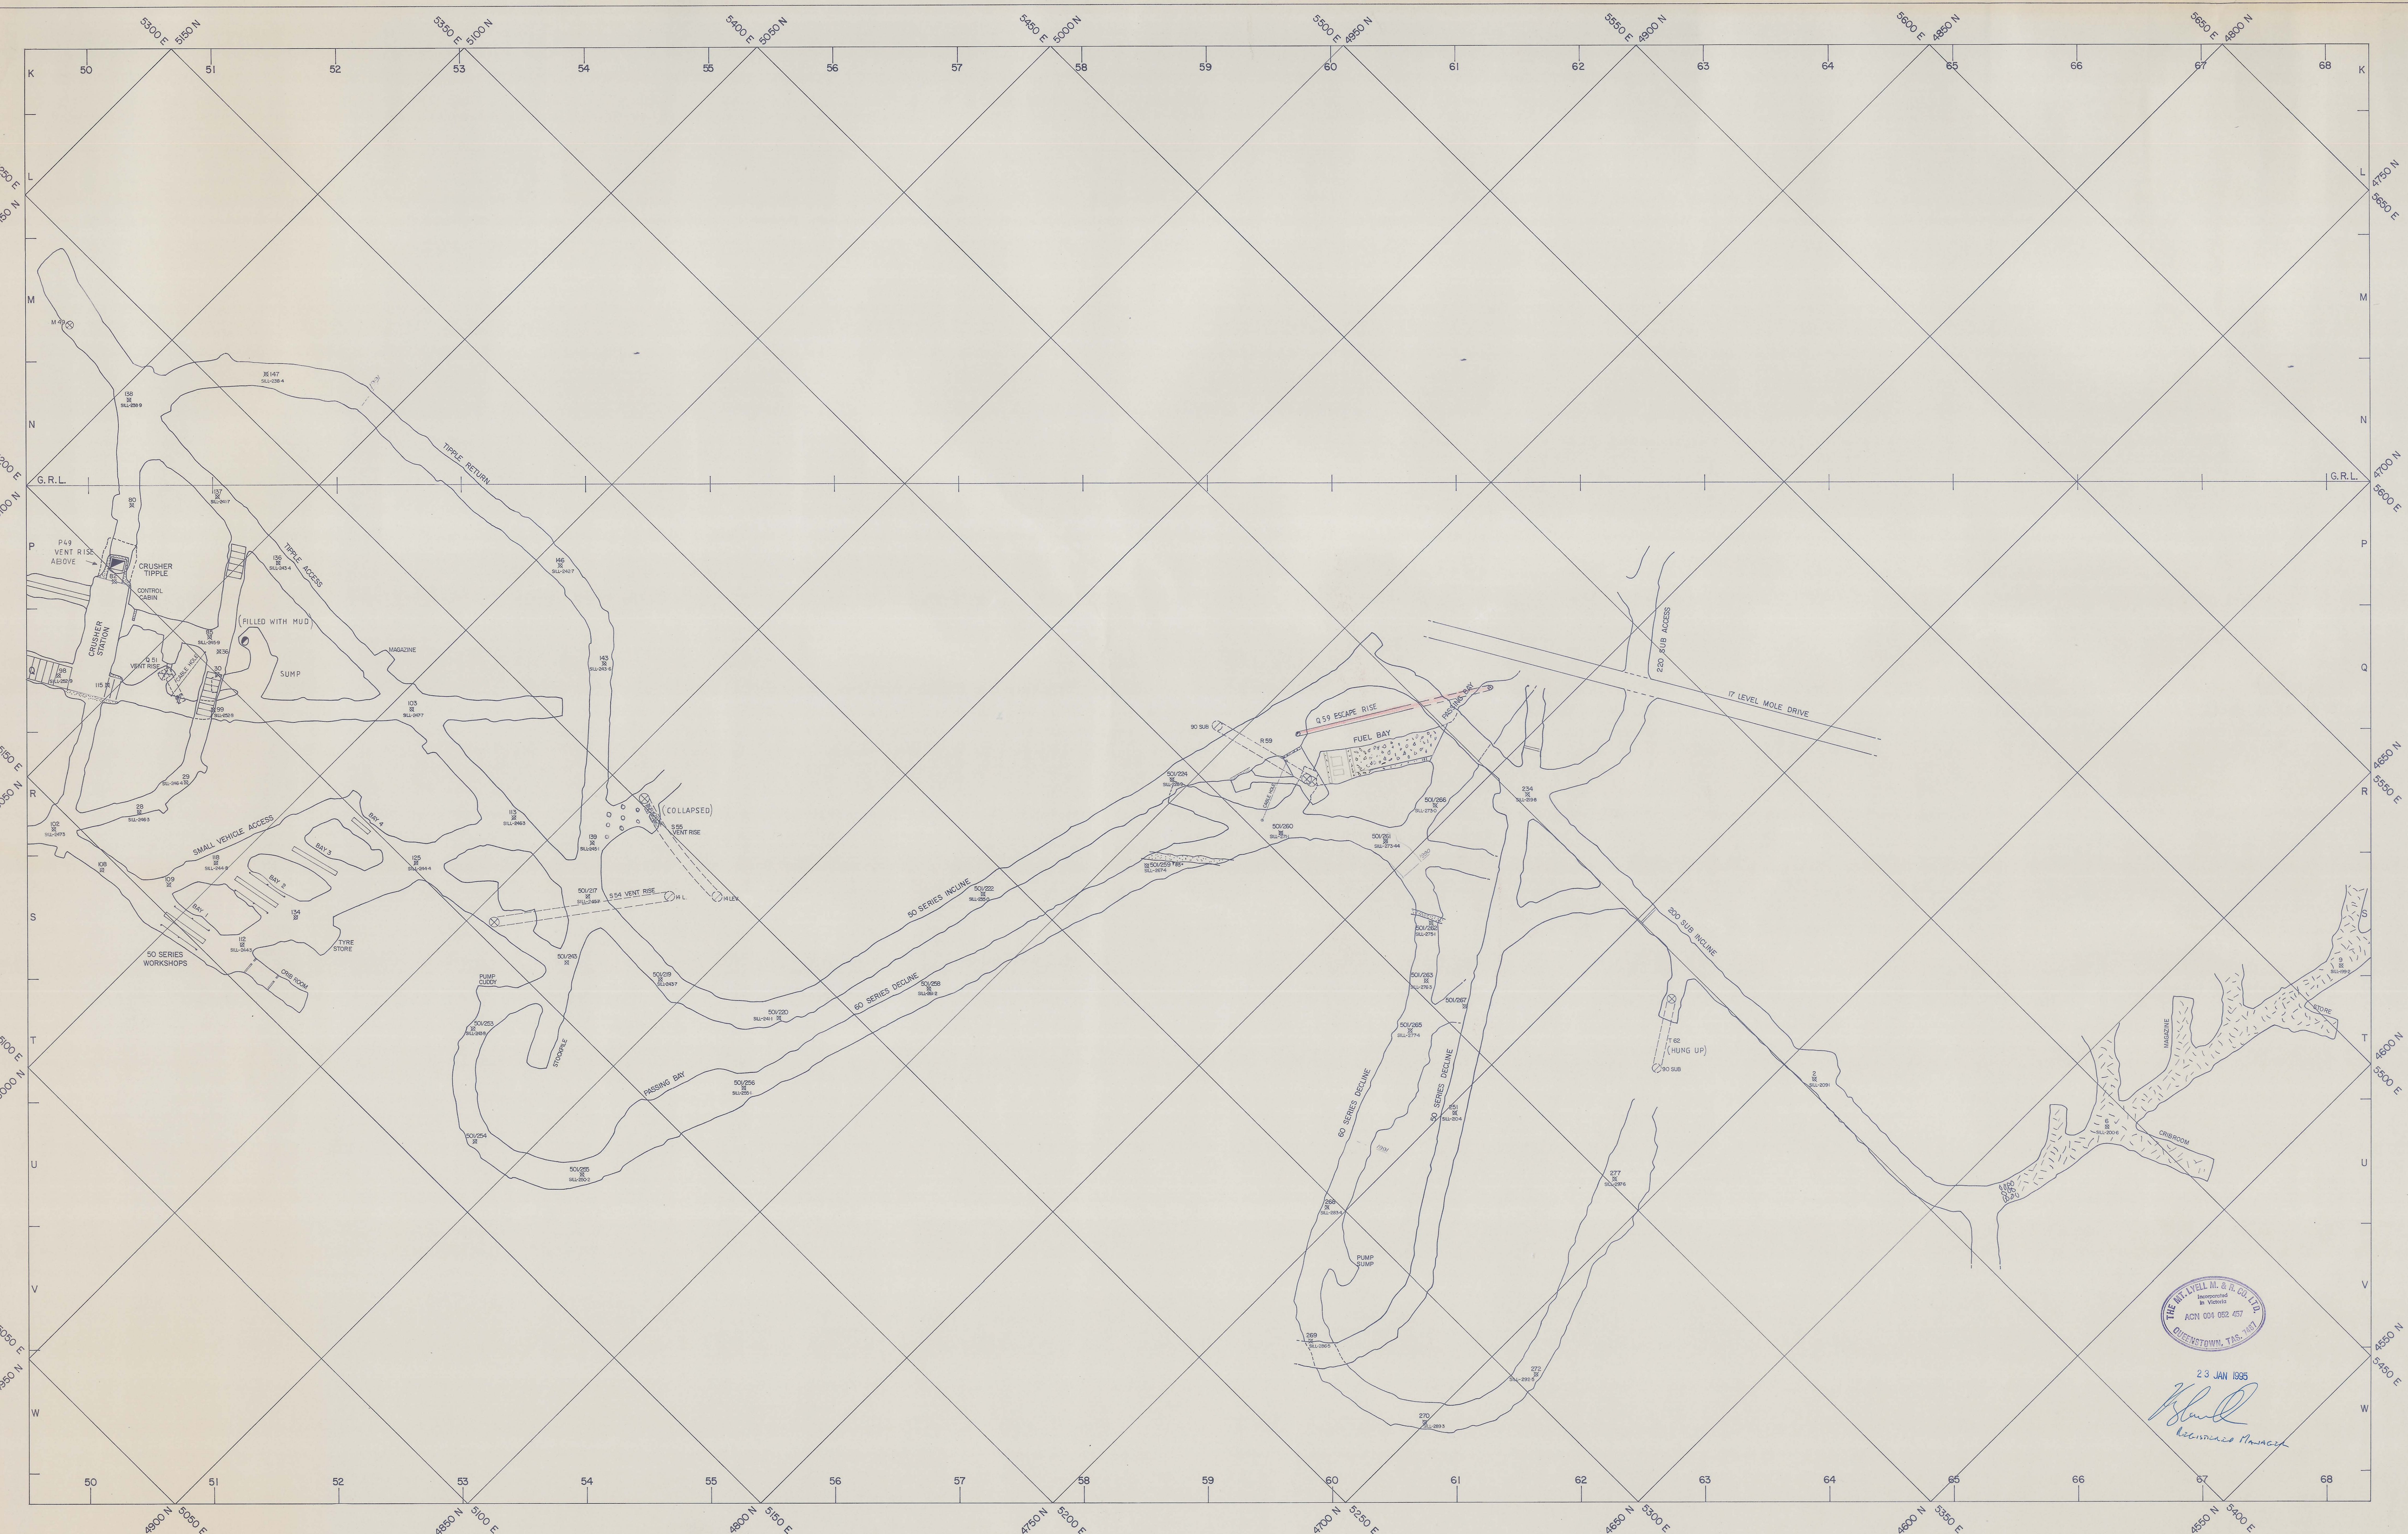

- | | | | | |
|-------------------------------------|---|---|---|---|
| Survey station, Line pegs, FLP, BLR | + | + | + | + |
| Rise - down | ▣ | ▣ | ▣ | ▣ |
| Rise - through | ▣ | ▣ | ▣ | ▣ |
| Rise - up | ▣ | ▣ | ▣ | ▣ |
| Sets | ▣ | ▣ | ▣ | ▣ |
| Ore outline | ▣ | ▣ | ▣ | ▣ |
| Conglomerate contact | ▣ | ▣ | ▣ | ▣ |
| Fault zone | ▣ | ▣ | ▣ | ▣ |
| Cable hole | ▣ | ▣ | ▣ | ▣ |
| Diamond drill hole collar | ▣ | ▣ | ▣ | ▣ |
| Diamond drill hole intersection | ▣ | ▣ | ▣ | ▣ |
| Diamond drill hole, end of hole | ▣ | ▣ | ▣ | ▣ |
| Shear | ▣ | ▣ | ▣ | ▣ |
| Lamprophyre Dyke | ▣ | ▣ | ▣ | ▣ |
| Collapsed ground | ▣ | ▣ | ▣ | ▣ |

THE MOUNT LYELL M. & R. CO. LTD.
Incorporated in Victoria
ACN 004 052 457
23 JAN 1995
Handwritten signature

JAN - DEC 1994

THE MOUNT LYELL M. & R. CO. LTD.	
DATE: NOV. 1990	SCALE: 1:500
PRINCE LYELL MINE 50 & 60 SERIES HAULAGE	
DRAWN: <i>But</i>	APPROVED:
CHECKED:	APPROVED:
CHECKED:	APPROVED:
DRAWING NUMBER A0-206	
SHEET NUMBER —	

UPDATED 22/6/93
5 cm