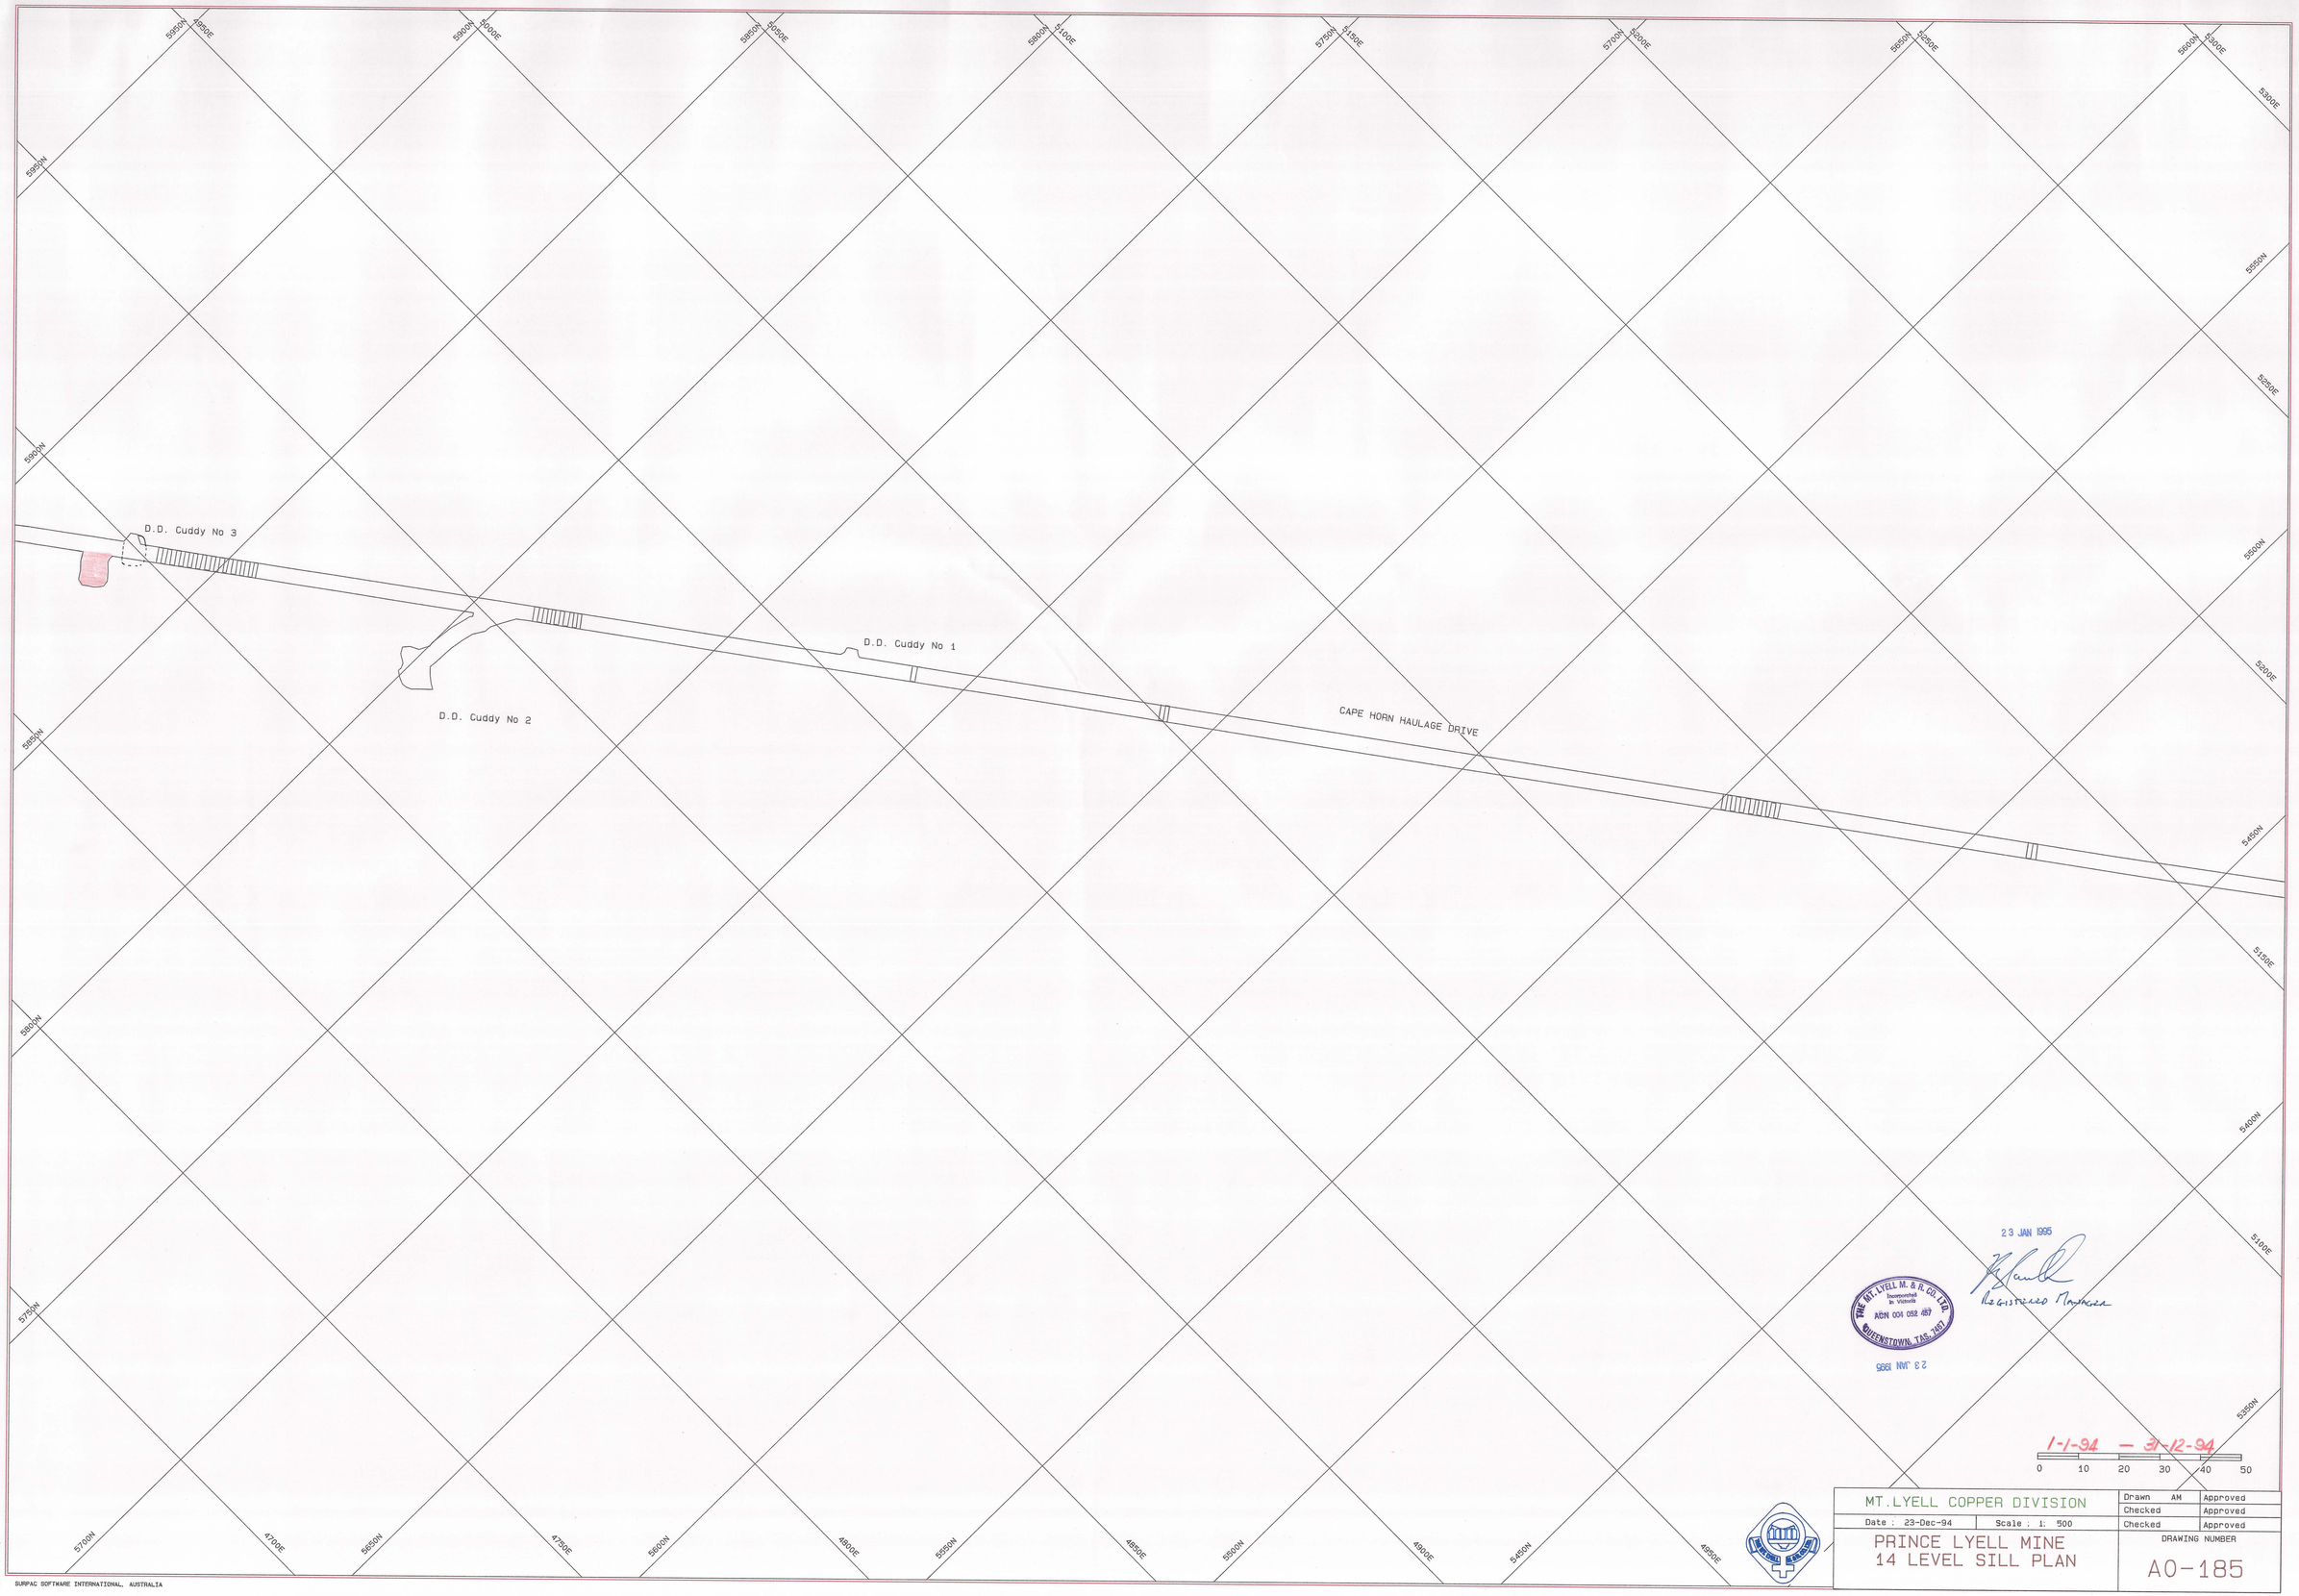
D.D. Cuddy No 3
D.D. Cuddy No 2
D.D. Cuddy No 1
CAPE HORN HAULAGE DRIVE
5950N
4950E
5900N
5000E
5850N
5050E
5800N
5100E
5750N
5150E
5700N
5200E
5650N
5250E
5600N
5300E
5550N
5350E
5500N
5400N
5450N
5150E
5400N
5110E
5350N
5700N
4700E
5650N
4750E
5600N
4800E
5550N
4850E
5500N
4900E
5450N
4950E
1-1-94 — 31-12-94
0 10 20 30 40 50
23 JAN 1995
Registered Manager
THE MT. LYELL M. & R. CO. LTD.
Incorporated in Victoria
ACN 004 092 487
QUEENSTOWN, TAS. 7467
23 JAN 1995
MT.LYELL COPPER DIVISION
Date : 23-Dec-94
Scale : 1: 500
PRINCE LYELL MINE
14 LEVEL SILL PLAN
Drawn AM
Approved
Checked
Approved
Checked
Approved
DRAWING NUMBER
A0-185
5 cm
SURPAC SOFTWARE INTERNATIONAL, AUSTRALIA

0381-028