0381-032

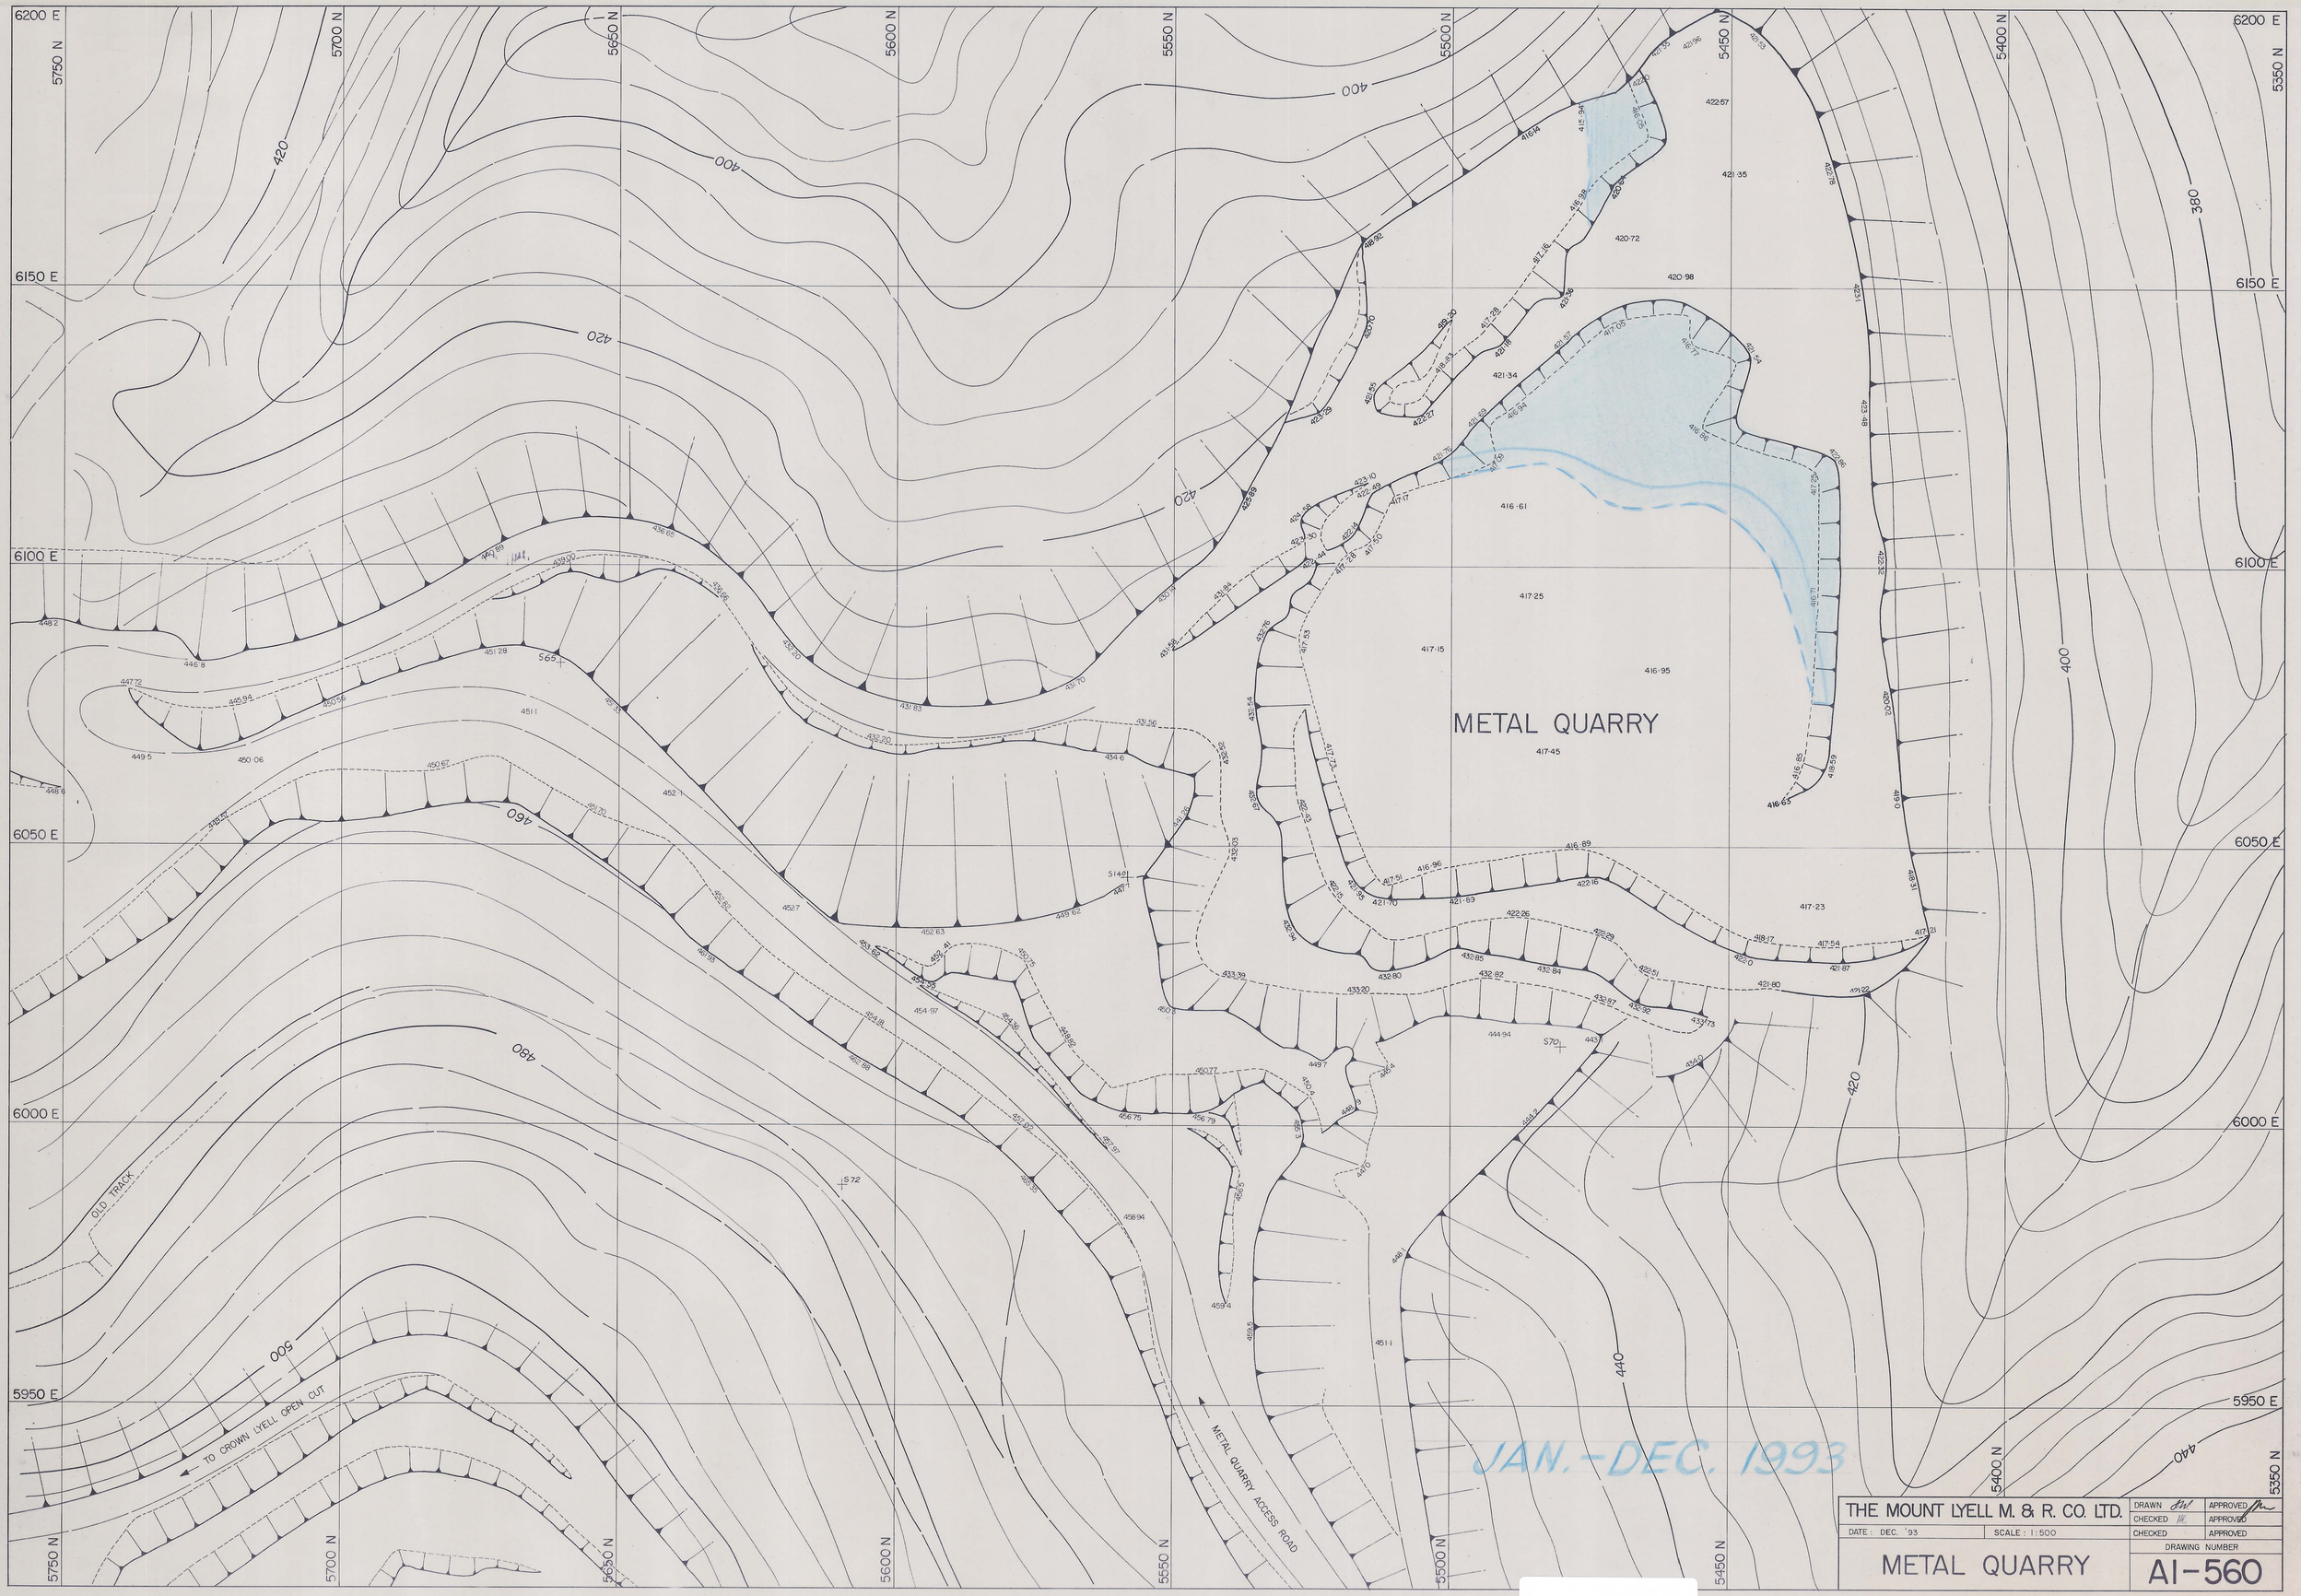
METAL QUARRY
OLD TRACK
TO CROWN LYELL OPEN CUT
METAL QUARRY ACCESS ROAD
6200 E
6150 E
6100 E
6050 E
6000 E
5950 E
5750 N
5700 N
5650 N
5600 N
5550 N
5500 N
5450 N
5400 N
5350 N
420
400
380
440
460
480
500
JAN.-DEC. 1993
THE MOUNT LYELL M. & R. CO. LTD.
DRAWN
APPROVED
CHECKED
APPROVED
DATE: DEC. '93
SCALE: 1:500
CHECKED
APPROVED
DRAWING NUMBER
METAL QUARRY
AI-560
5 cm