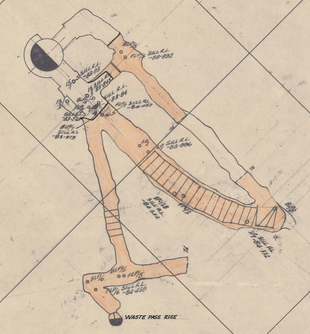

GEOLOGICAL REFERENCE LINE

NOTE: ALL MEASUREMENTS IN METRES

MICROFILMED

0381_080

No	DATE	APP'D	AMENDMENT

MOUNT LYELL M. & R. CO. LTD.
MINE DEPARTMENT

PRINCE LYELL MINE
15 LEVEL SILL PLAN

Scale: 1:500
Date: AUGUST '75

Surveyed:	
Designed:	
Drawn:	
Traced:	
Checked:	
Checked:	

APPROVED
Ufd Mgr.
C/M Eng.
C/Surv.
C/Geol.
Mine Supt.

DRAWING No
AO-52
SHEET No 8
Colour Drawing No 75039

0381_080