


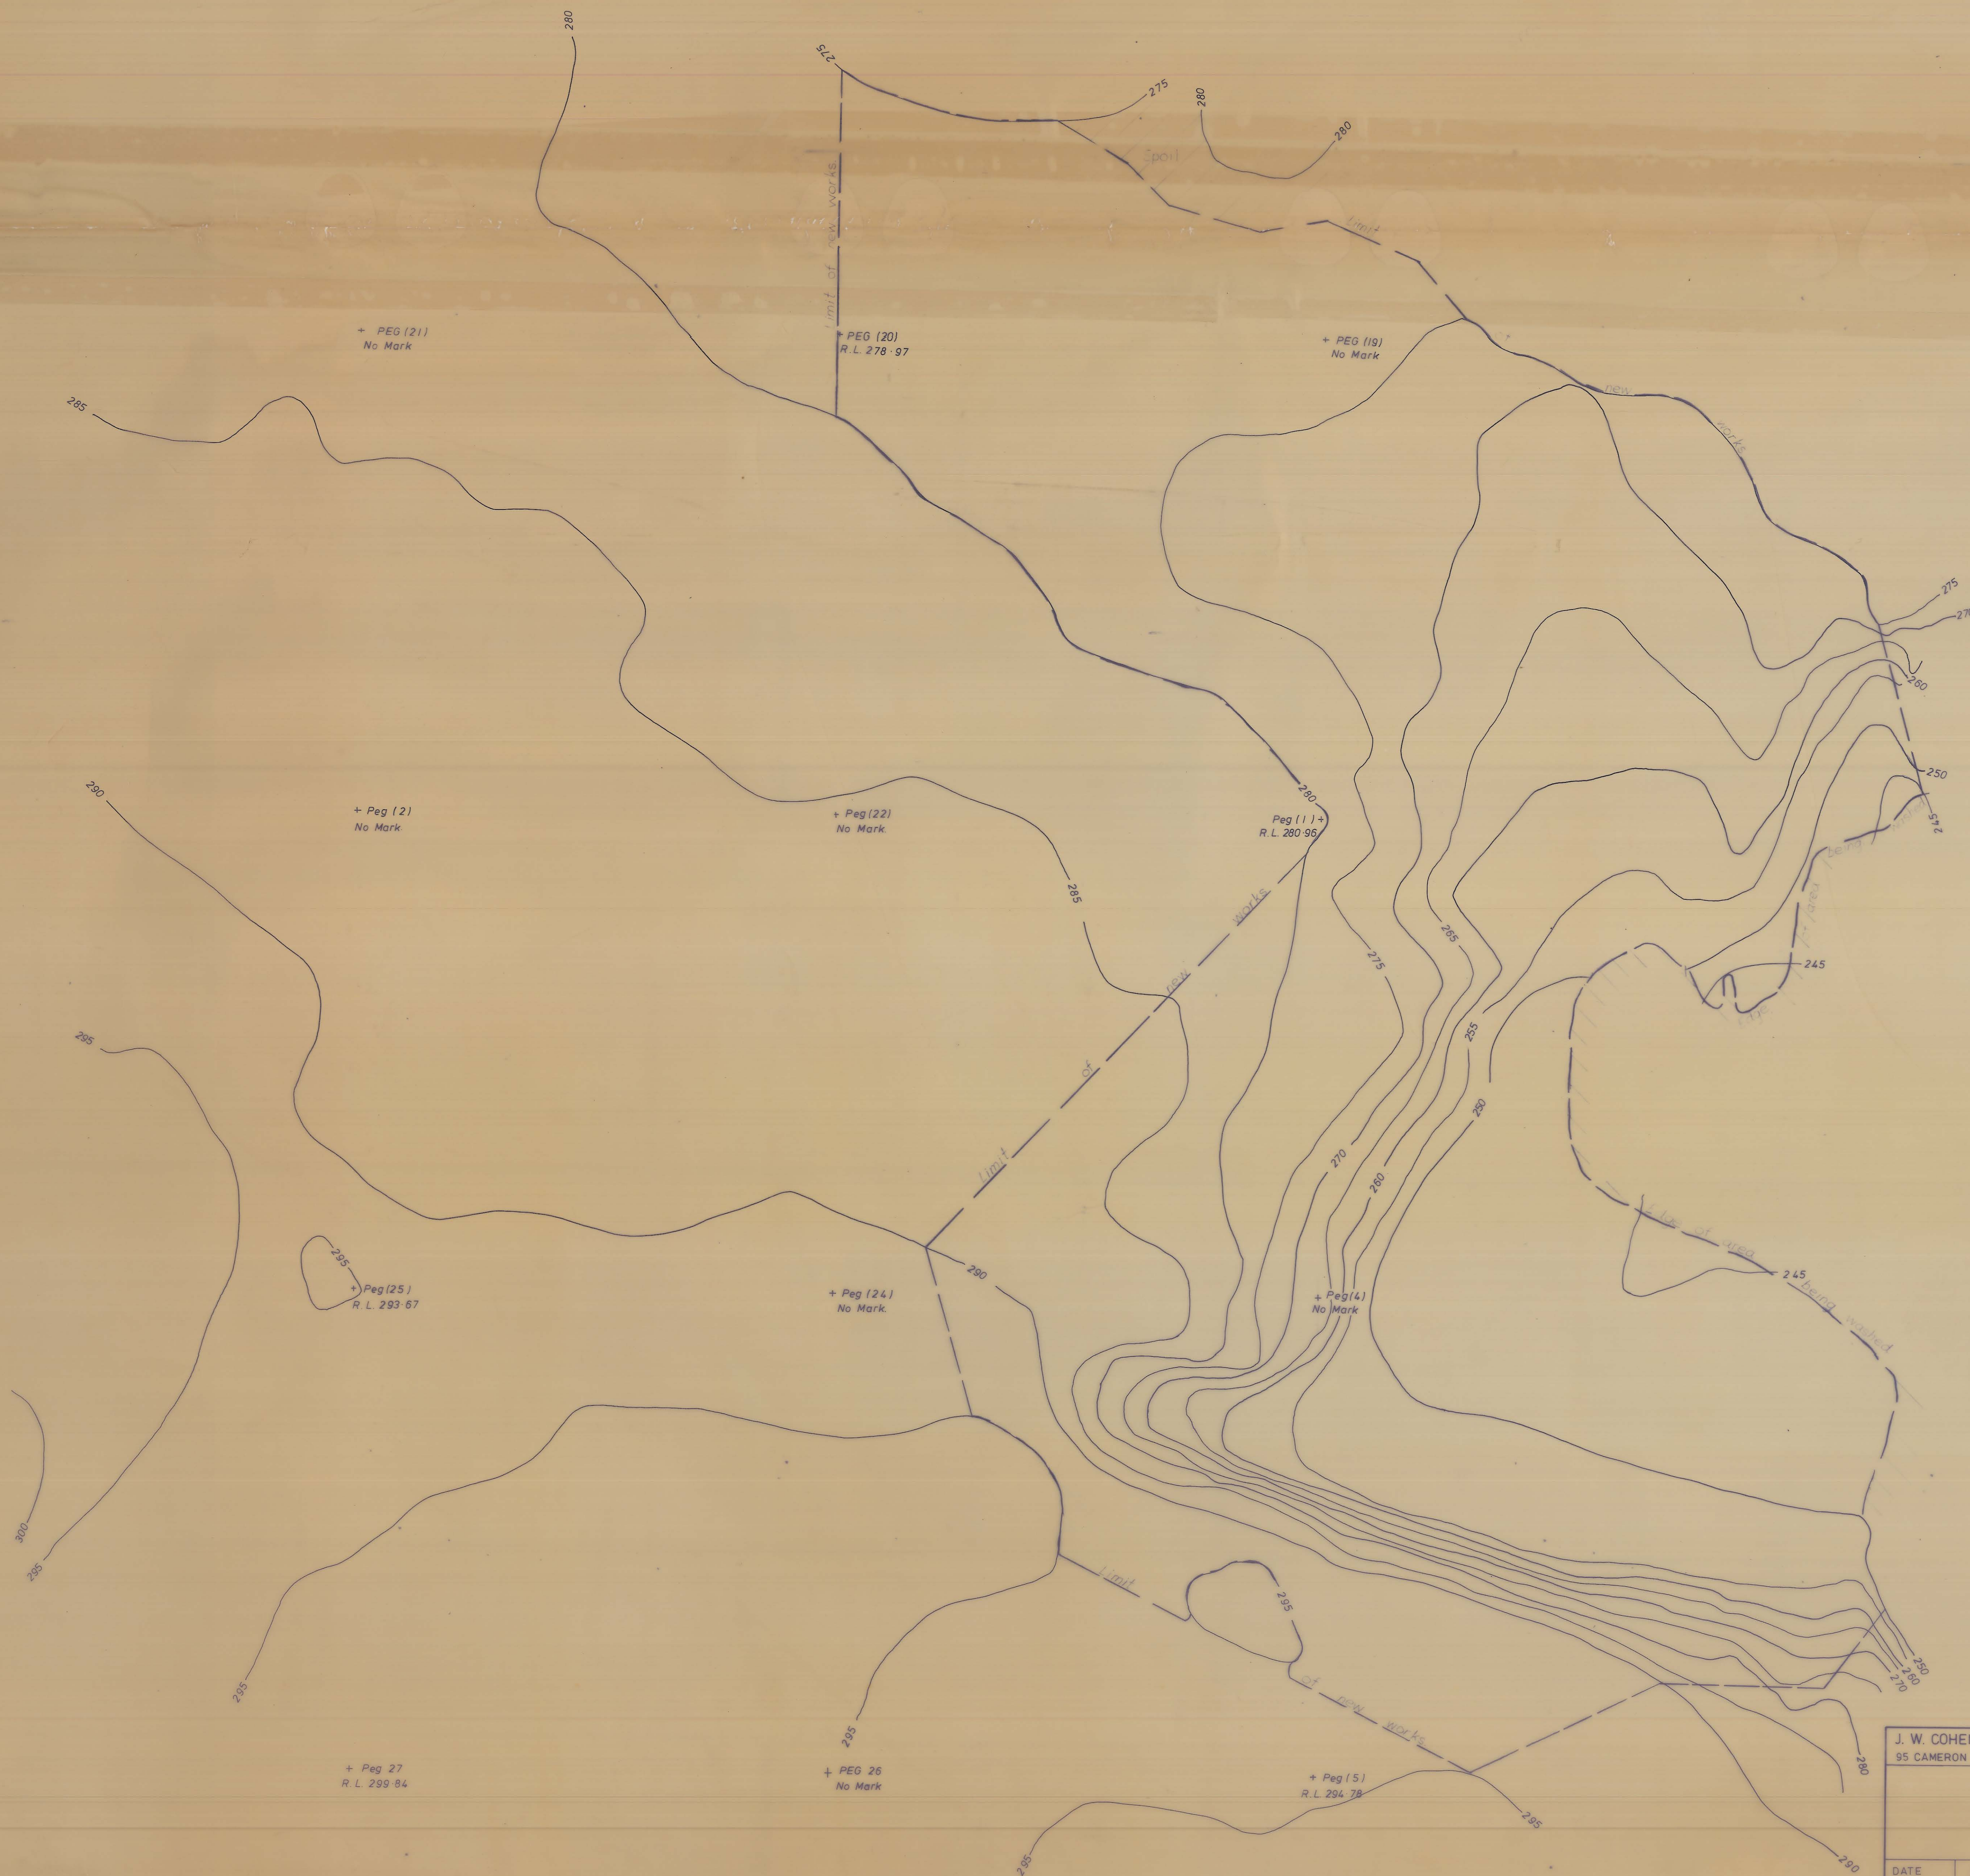

NOTE: MEASUREMENTS ARE IMPERIAL.
ARBITRARY NORTH POINT
ARBITRARY LEVEL DATUM.

J. W. COHEN & ASSOCIATES - SURVEYORS AND TOWN PLANNERS
95 CAMERON STREET, LAUNCESTON

KIBUKA MINE PTY LTD
PIONEER MINE
PROGRESSIVE STRIPPING CONTOURS
CONTOURS AS AT 5-2-78

DATE	27-2-78	DRAWN	D.W.G.	JOB NO	21-64
SCALE	1 inch = 50 feet	CHECKED	KDT		
CONTOUR INTERVAL	5 feet	L.B.	F.B.		
					Registered Surveyor

0382_062

0382_062