


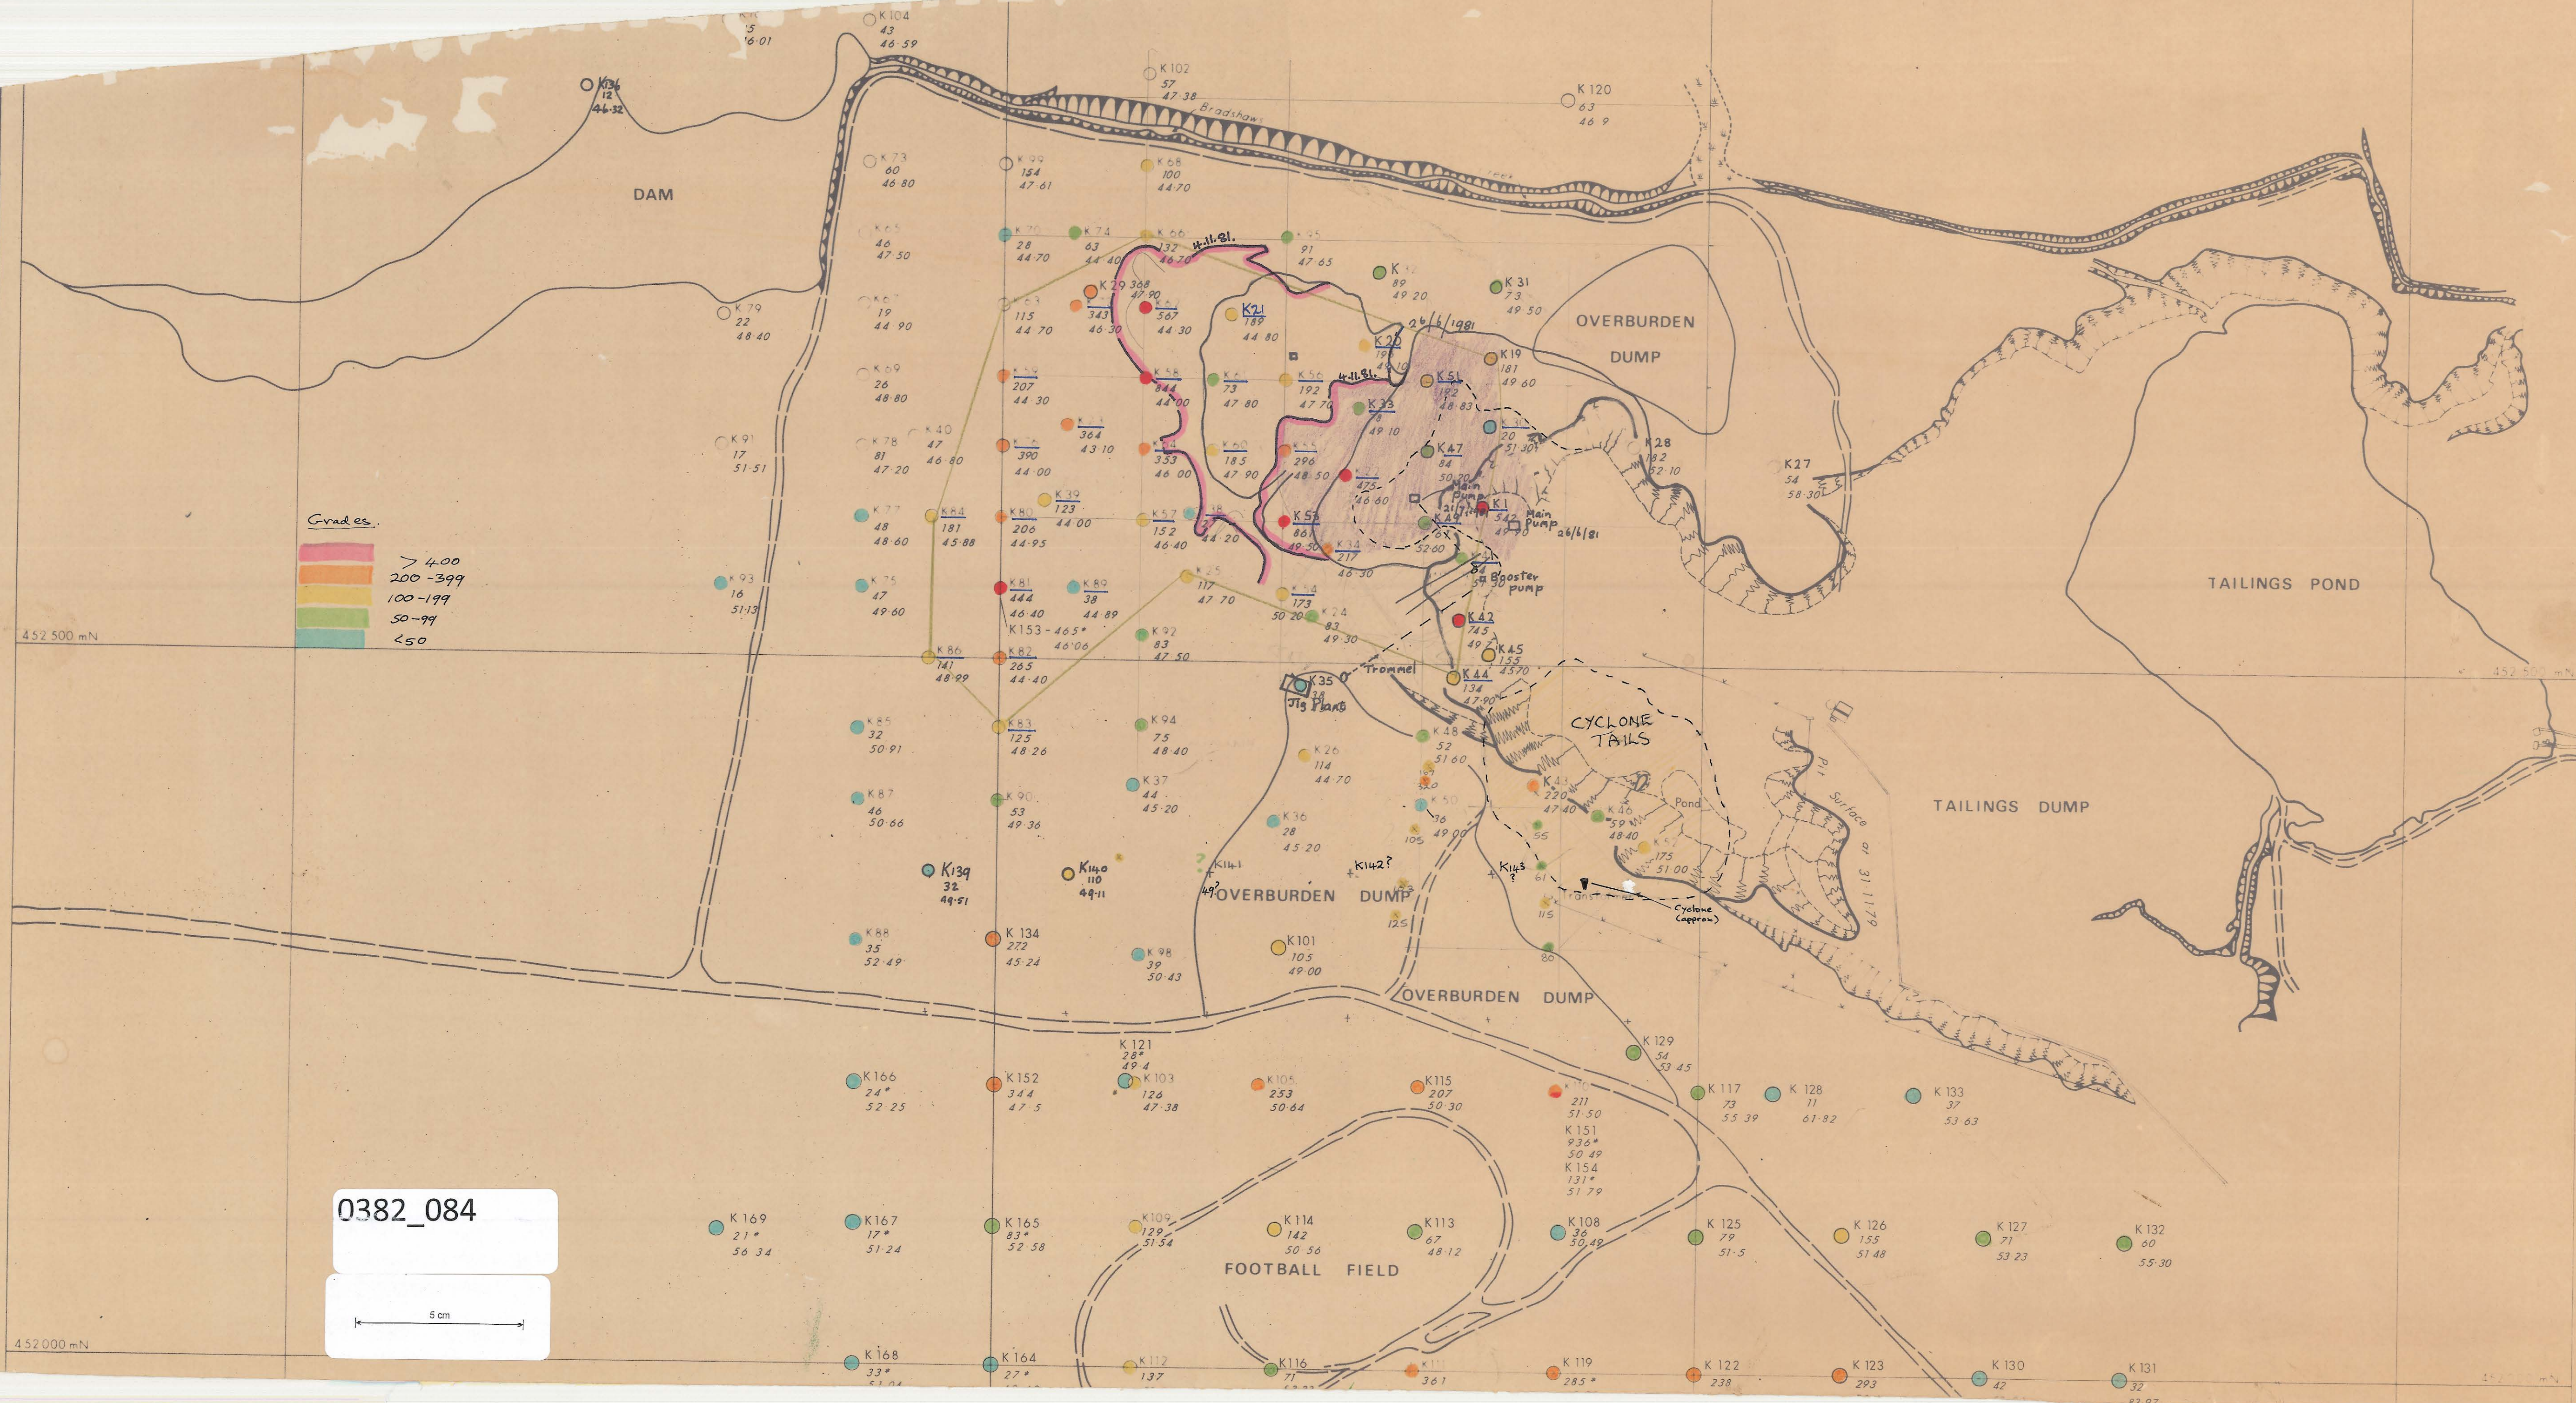

0382_084

5 cm