


Figure 1.

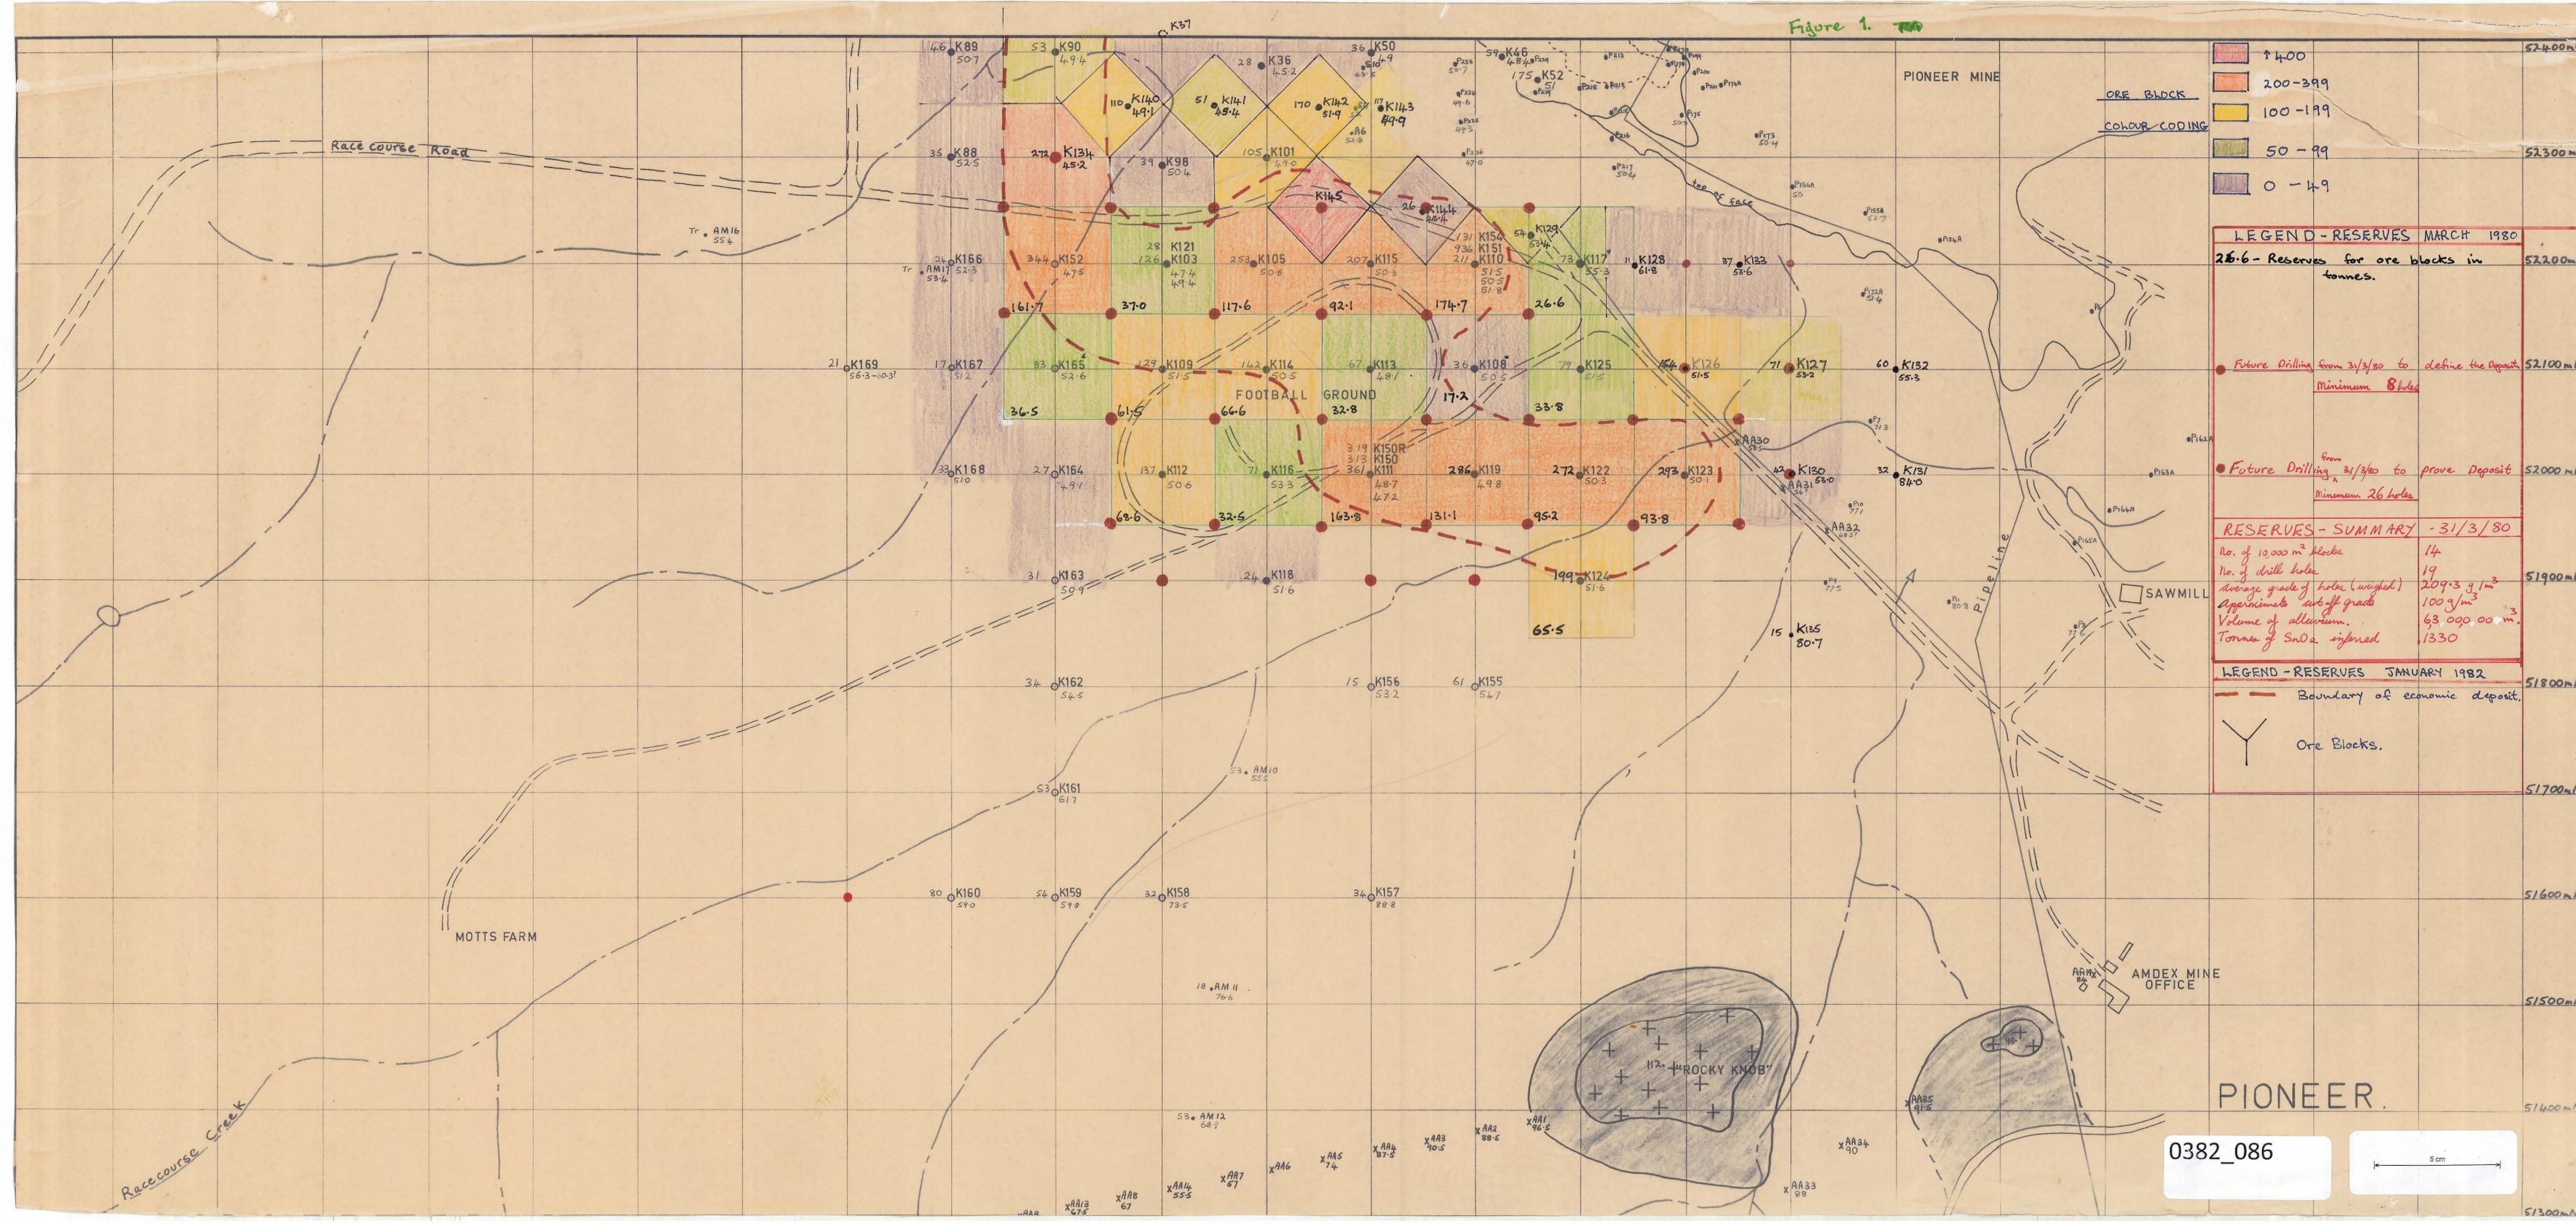

ORE BLOCKS

COLOR CODING

Red	400
Orange	200-399
Yellow	100-199
Light Green	50-99
Dark Green	0-49

LEGEND - RESERVES MARCH 1980

26.6 - Reserves for ore blocks in tonnes.

Future Drilling from 3/3/80 to define the Deposit
Minimum 8 holes

Future Drilling from 3/3/80 to prove Deposit
Minimum 26 holes

RESERVES - SUMMARY - 31/3/80

No. of 10,000 m ² blocks	14
No. of drill holes	19
Average grade of holes (weighted)	209.3 g/m ³
Approximate cut-off grade	100 g/m ³
Volume of alluvium	63,090.00 m ³
Tonnes of SnO ₂ signed	1330

LEGEND - RESERVES JANUARY 1982

--- Boundary of economic deposit.

Y Ore Blocks.

FOOTBALL GROUND

0382_086


0382_086

