
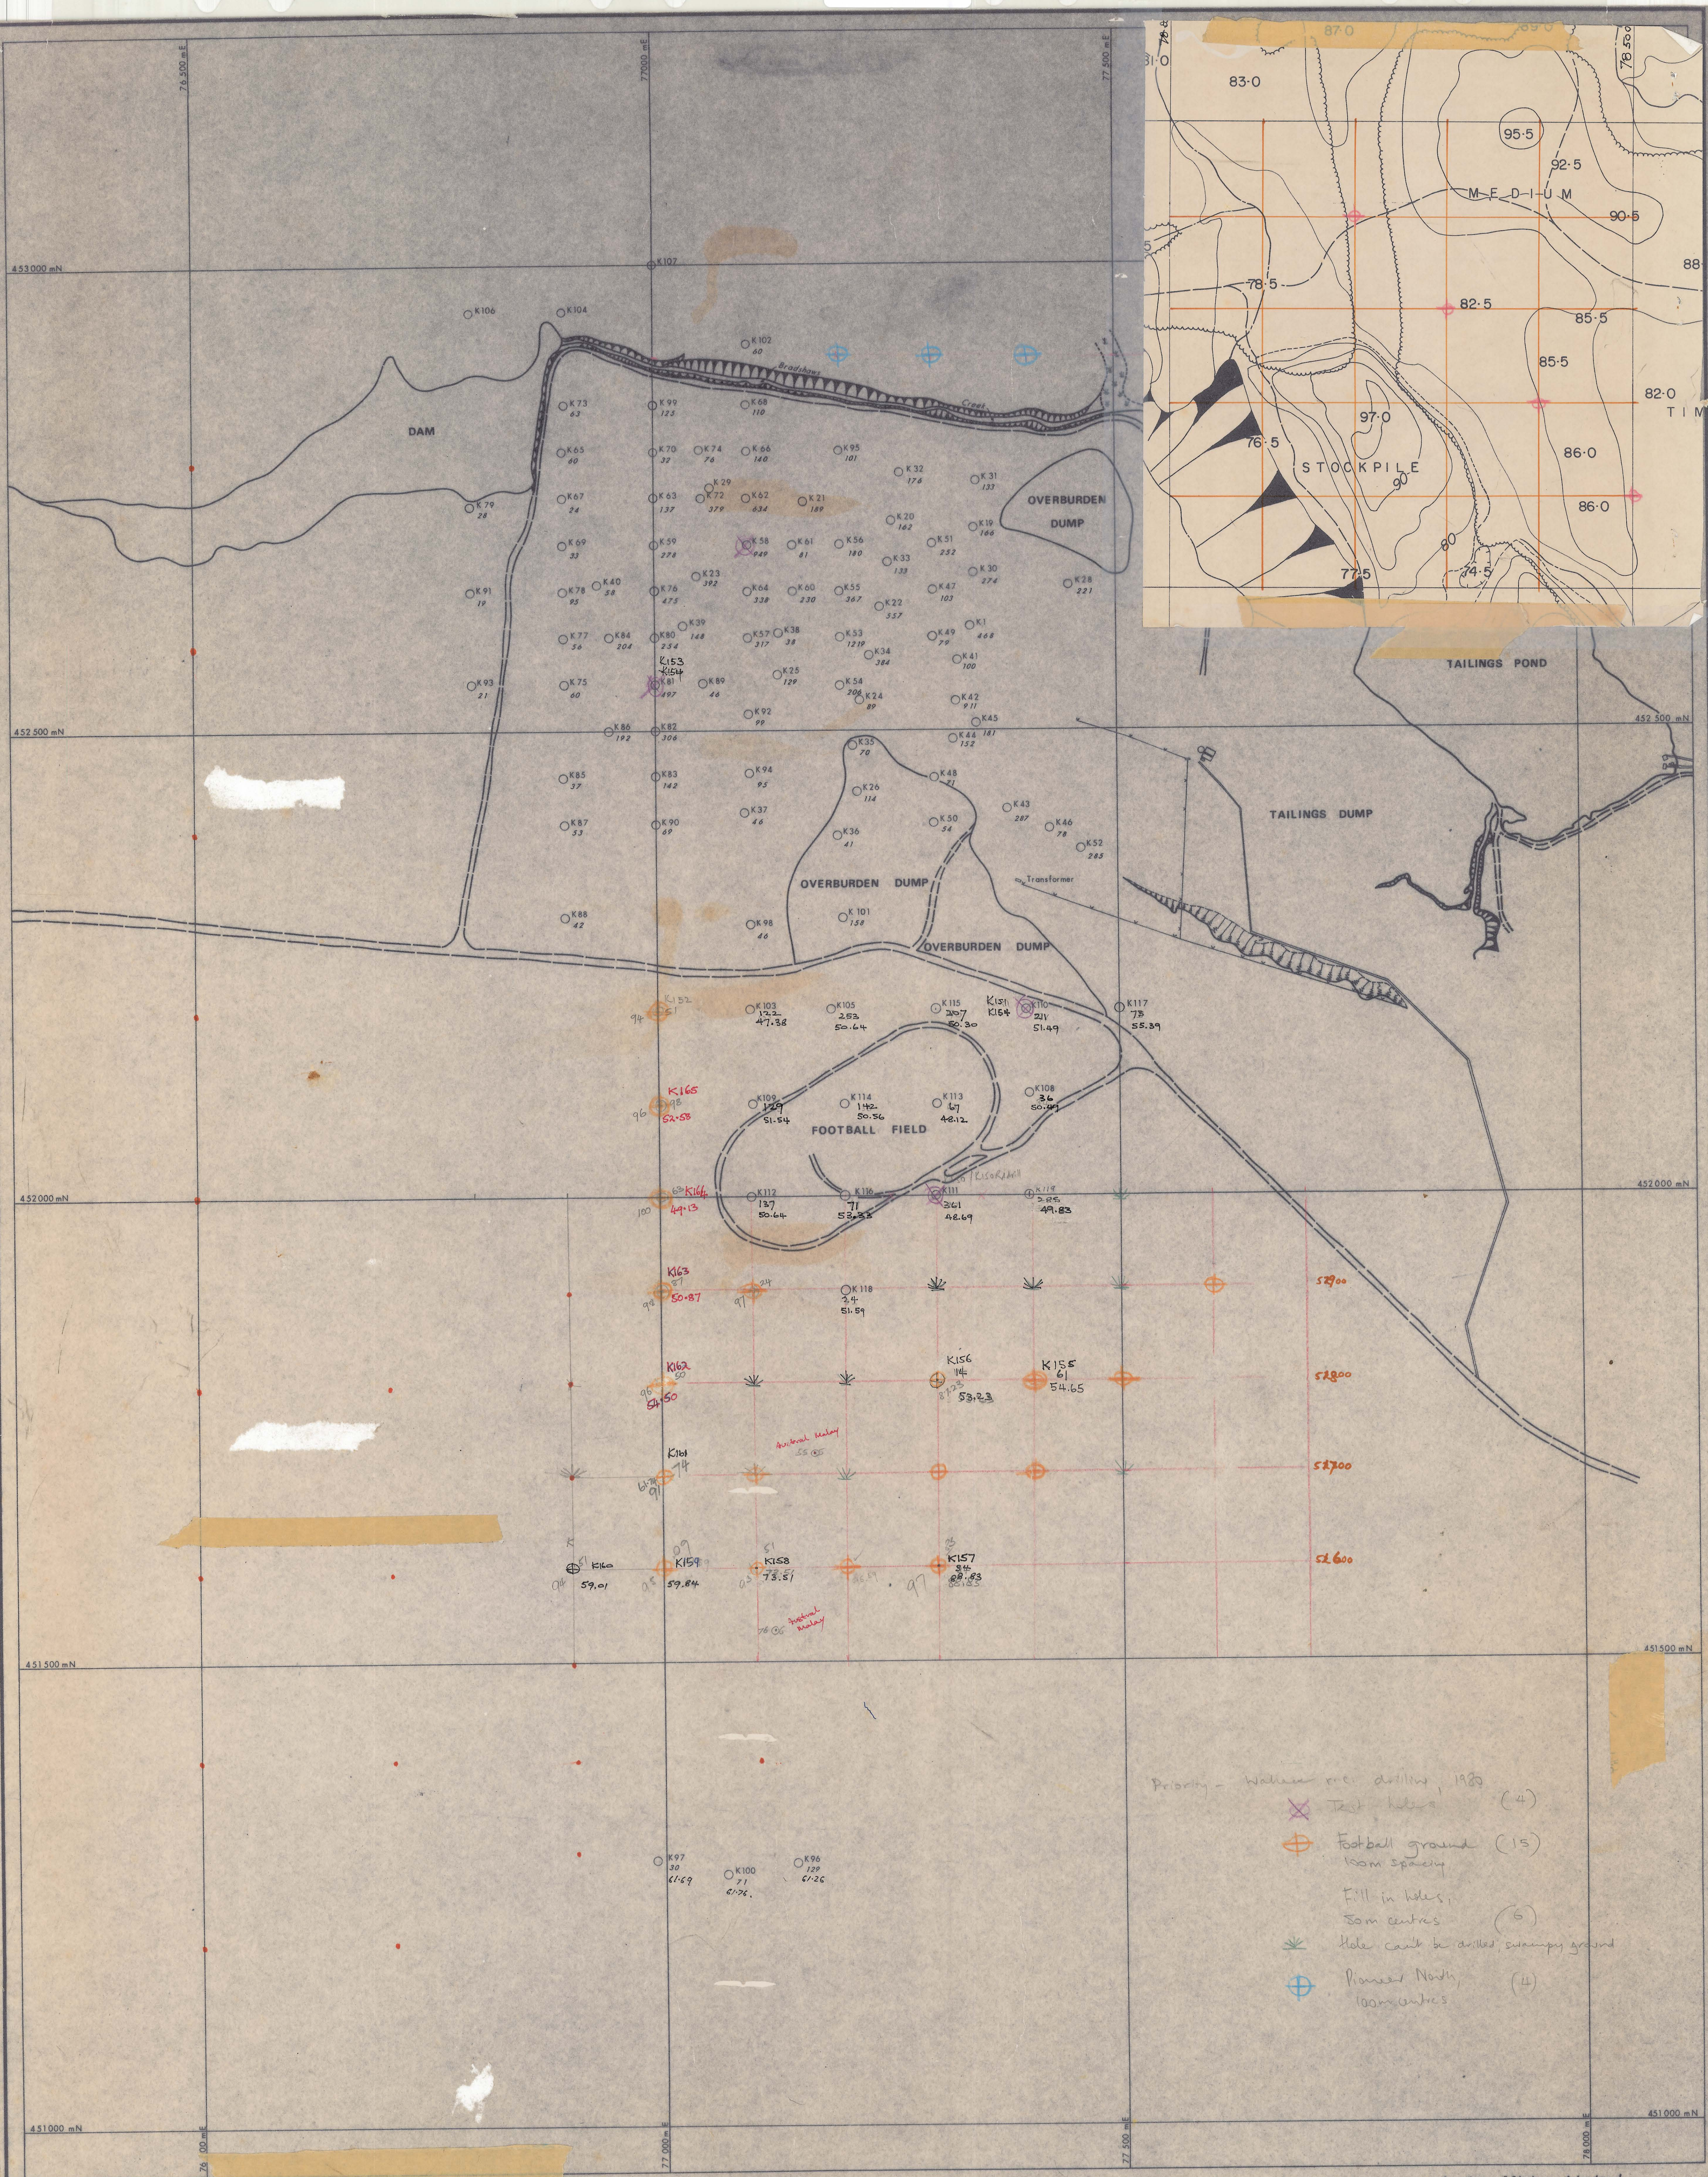


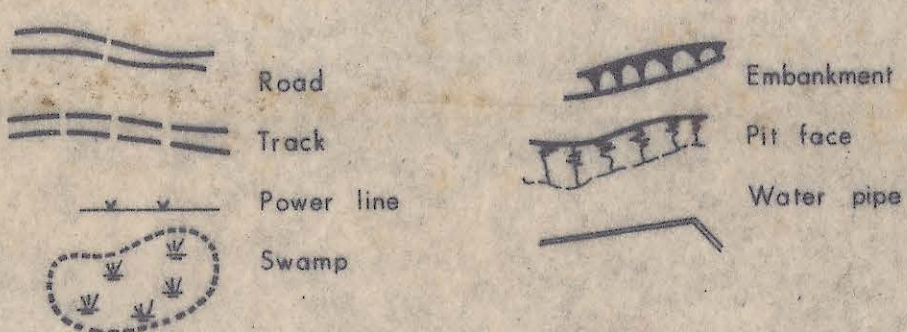

LEGEND

SCALE: 1 : 2 500
0 50 100 150 200 250 metres

Amdex Mining Limited
N.E. TASMANIA
PIONEER TIN MINE
Drilling & 'Recovered Volume'
Grades

Author: T.J. NEALE Date: November, 1979 Drawn: No. 136/524
Drafting: S.G. Report No. Base Plan: 136/524

0382_092