


CURRIE'S LODE

Scale 25 feet 1 inch.

D

E

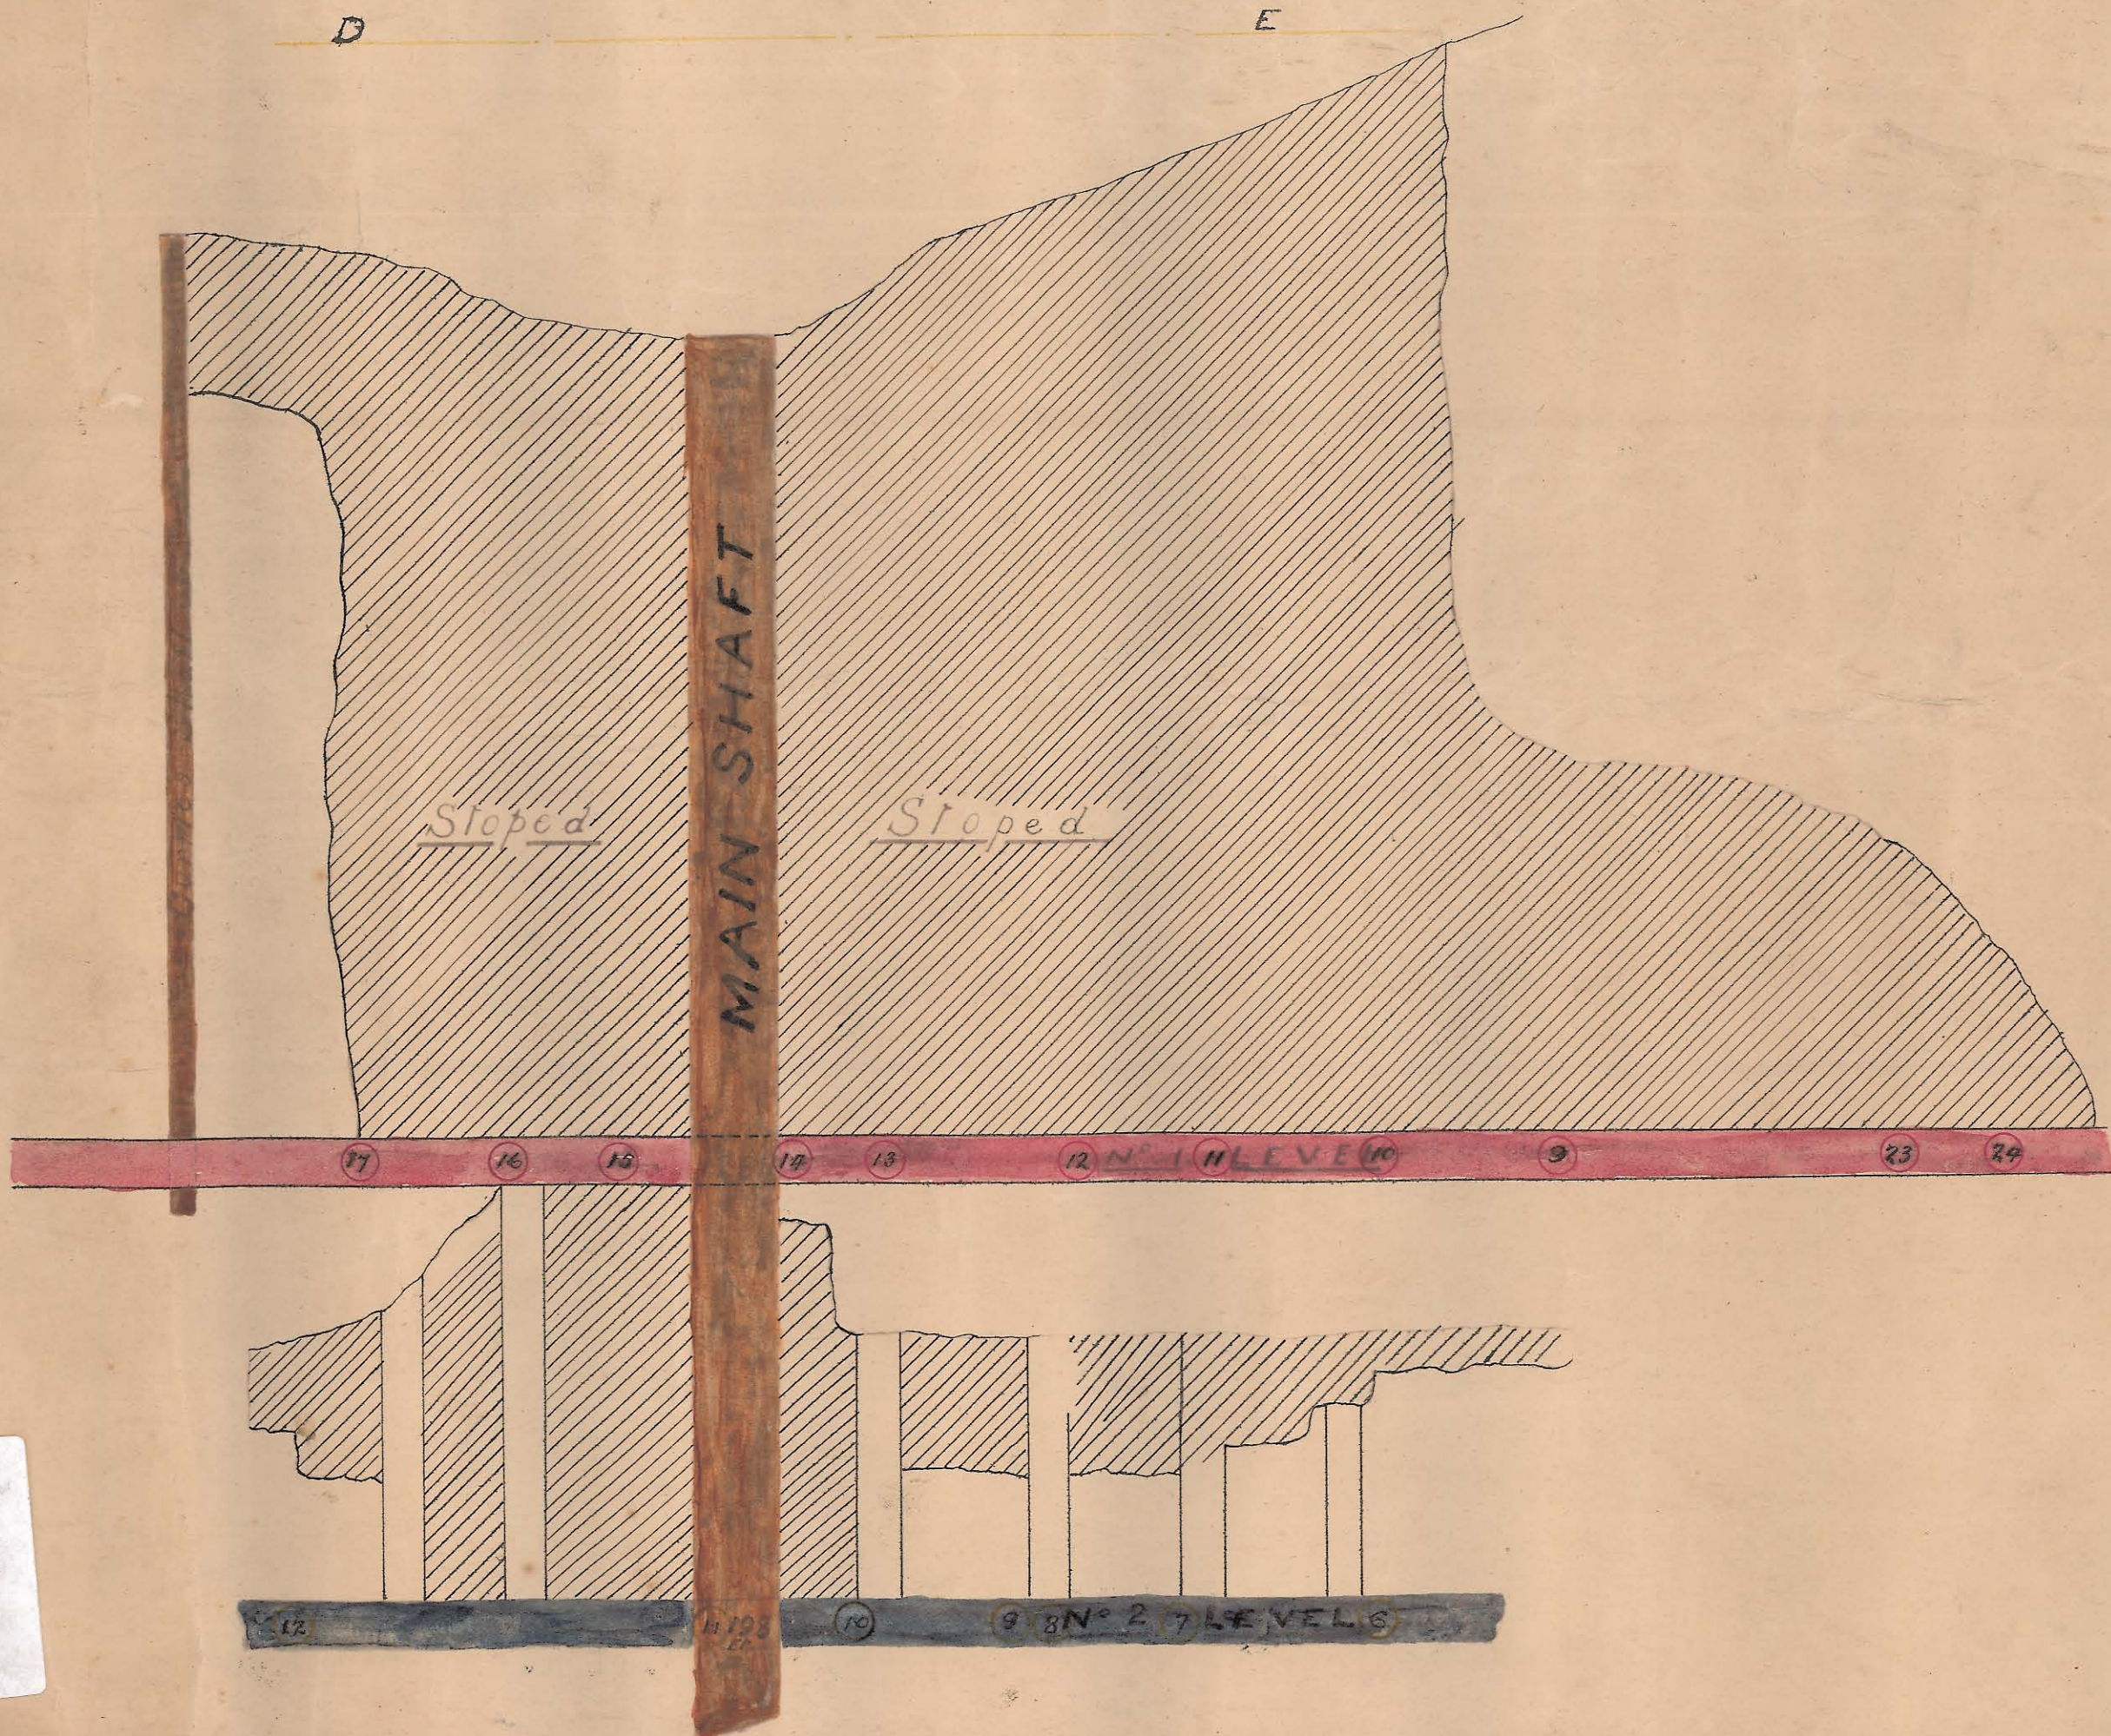

383-24

5 cm

383-24