



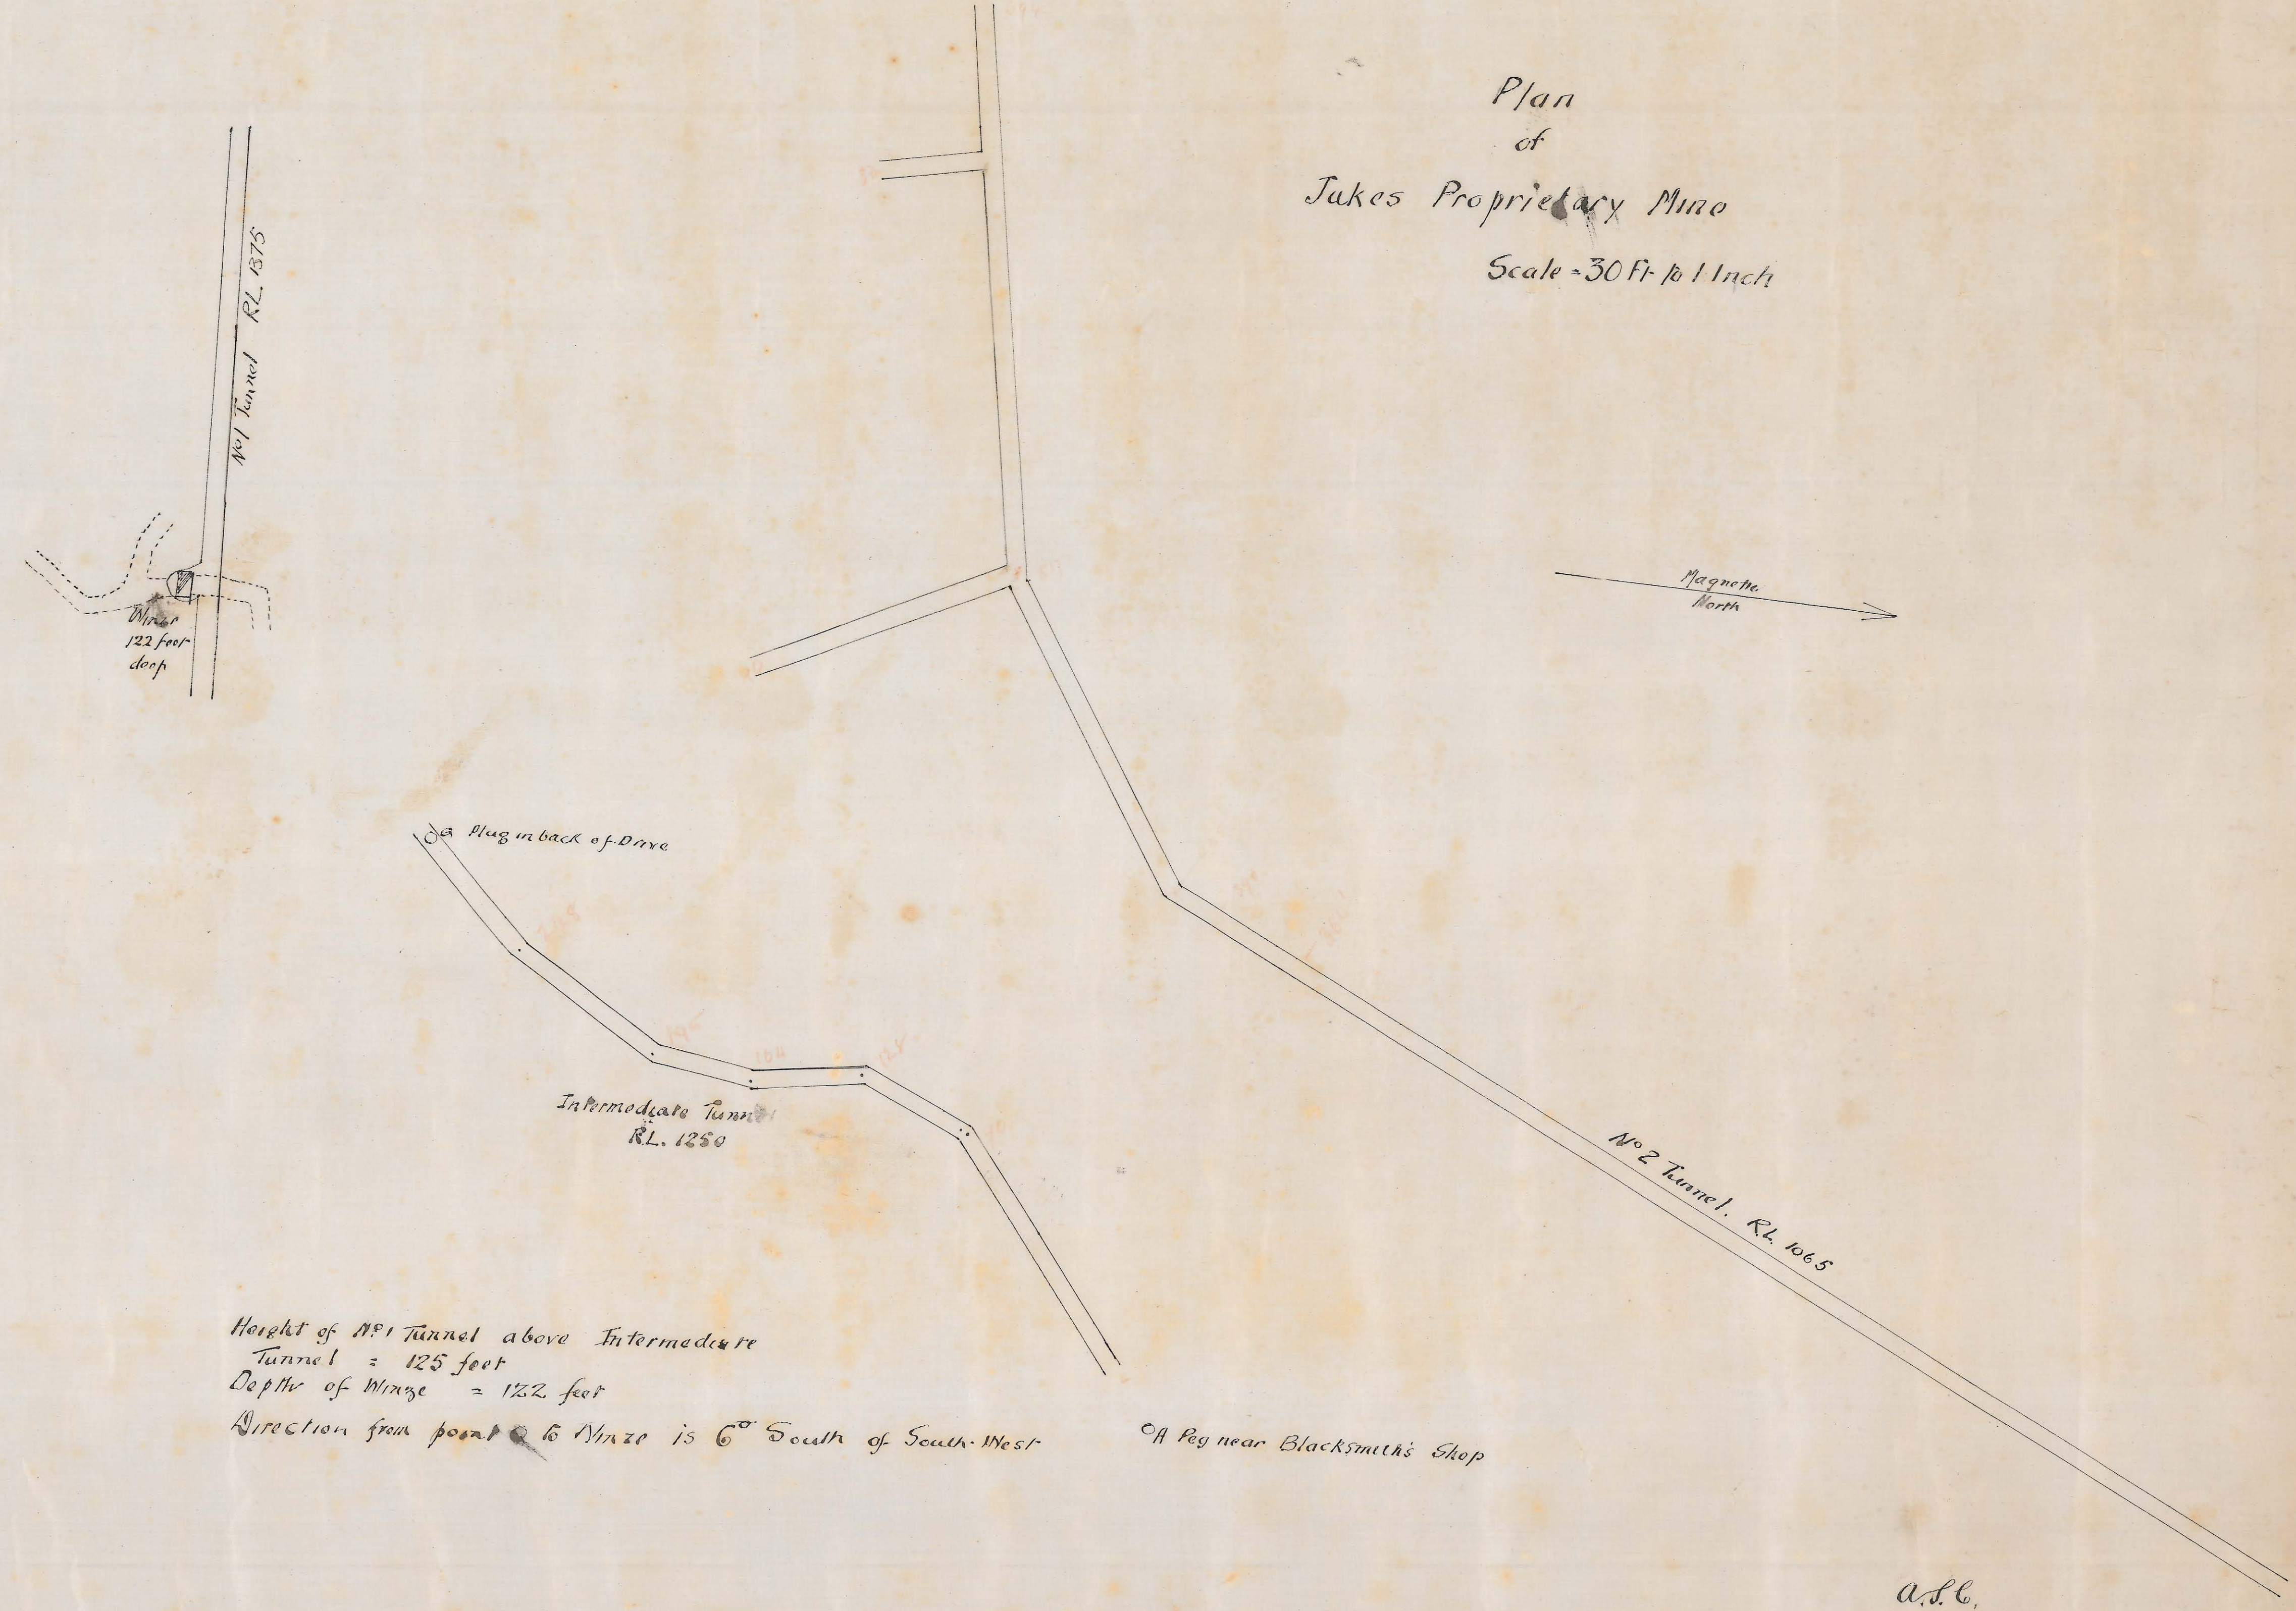


Plan
of
Jakes Proprietary Mine
Scale 30 ft. to 1 inch

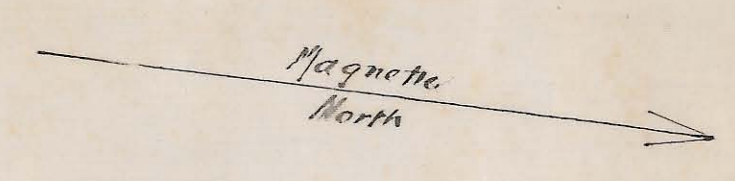

Height of No 1 Tunnel above Intermediate Tunnel = 125 feet
Depth of Winze = 122 feet
Direction from point Q to Winze is 6° South of South West

a.l.c.
14/7/15

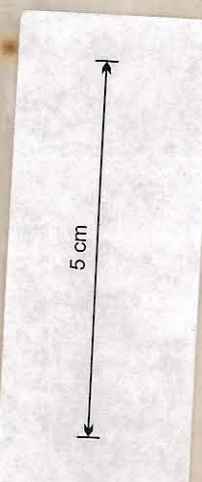

10-384