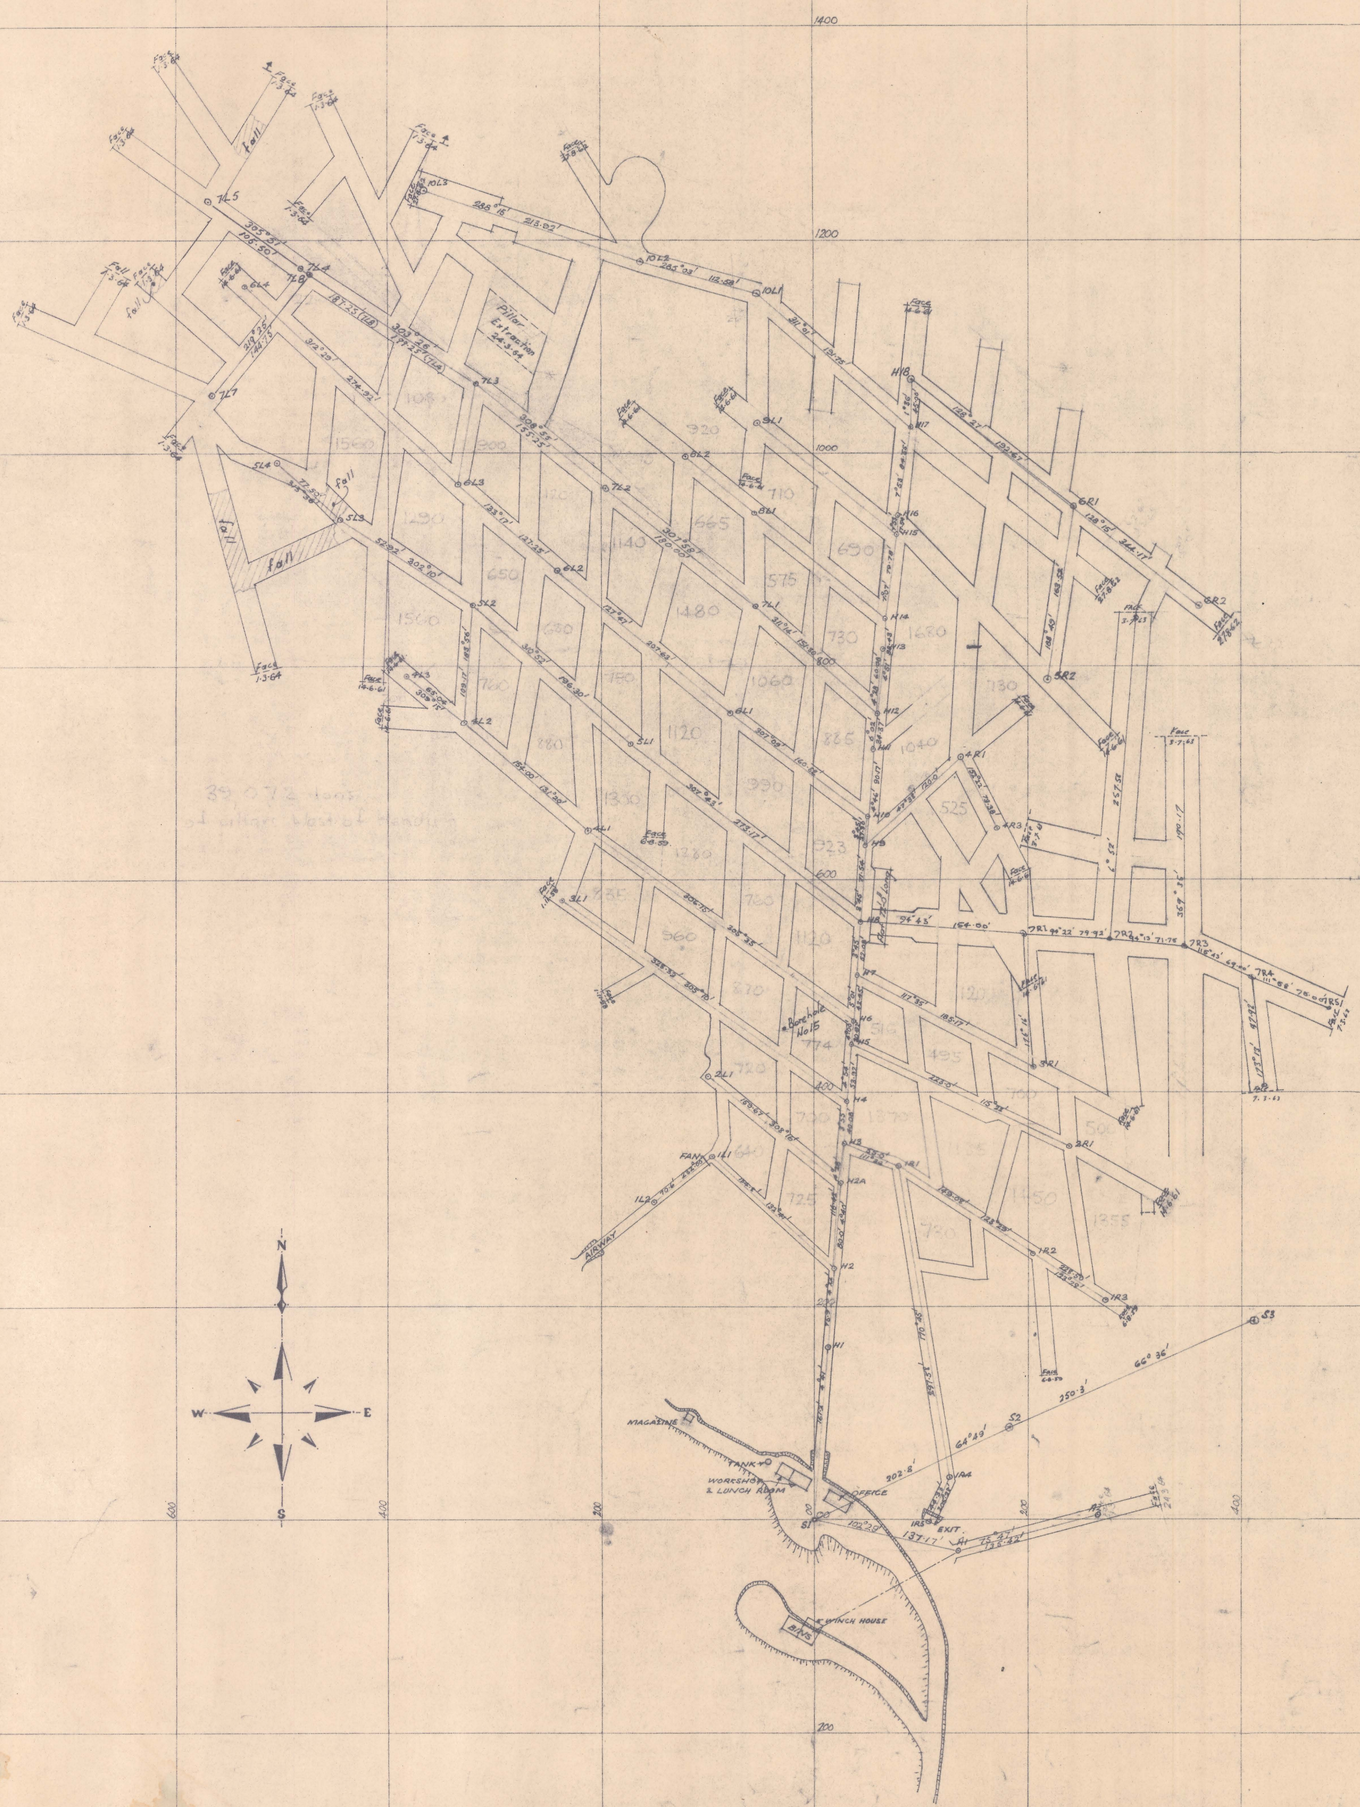

STANHOPE COLLIERIES AT AVOCA

SCALE - 1" = 80'-0"

SURVEY COMMENCED — 10·12·'57
EXTENDED — 1·11·'58
EXTENDED — 6·8·'59
EXTENDED — 14·6·'61
EXTENDED — 27·8·'62
" — 3·7·'63
" — 24·3·'64