


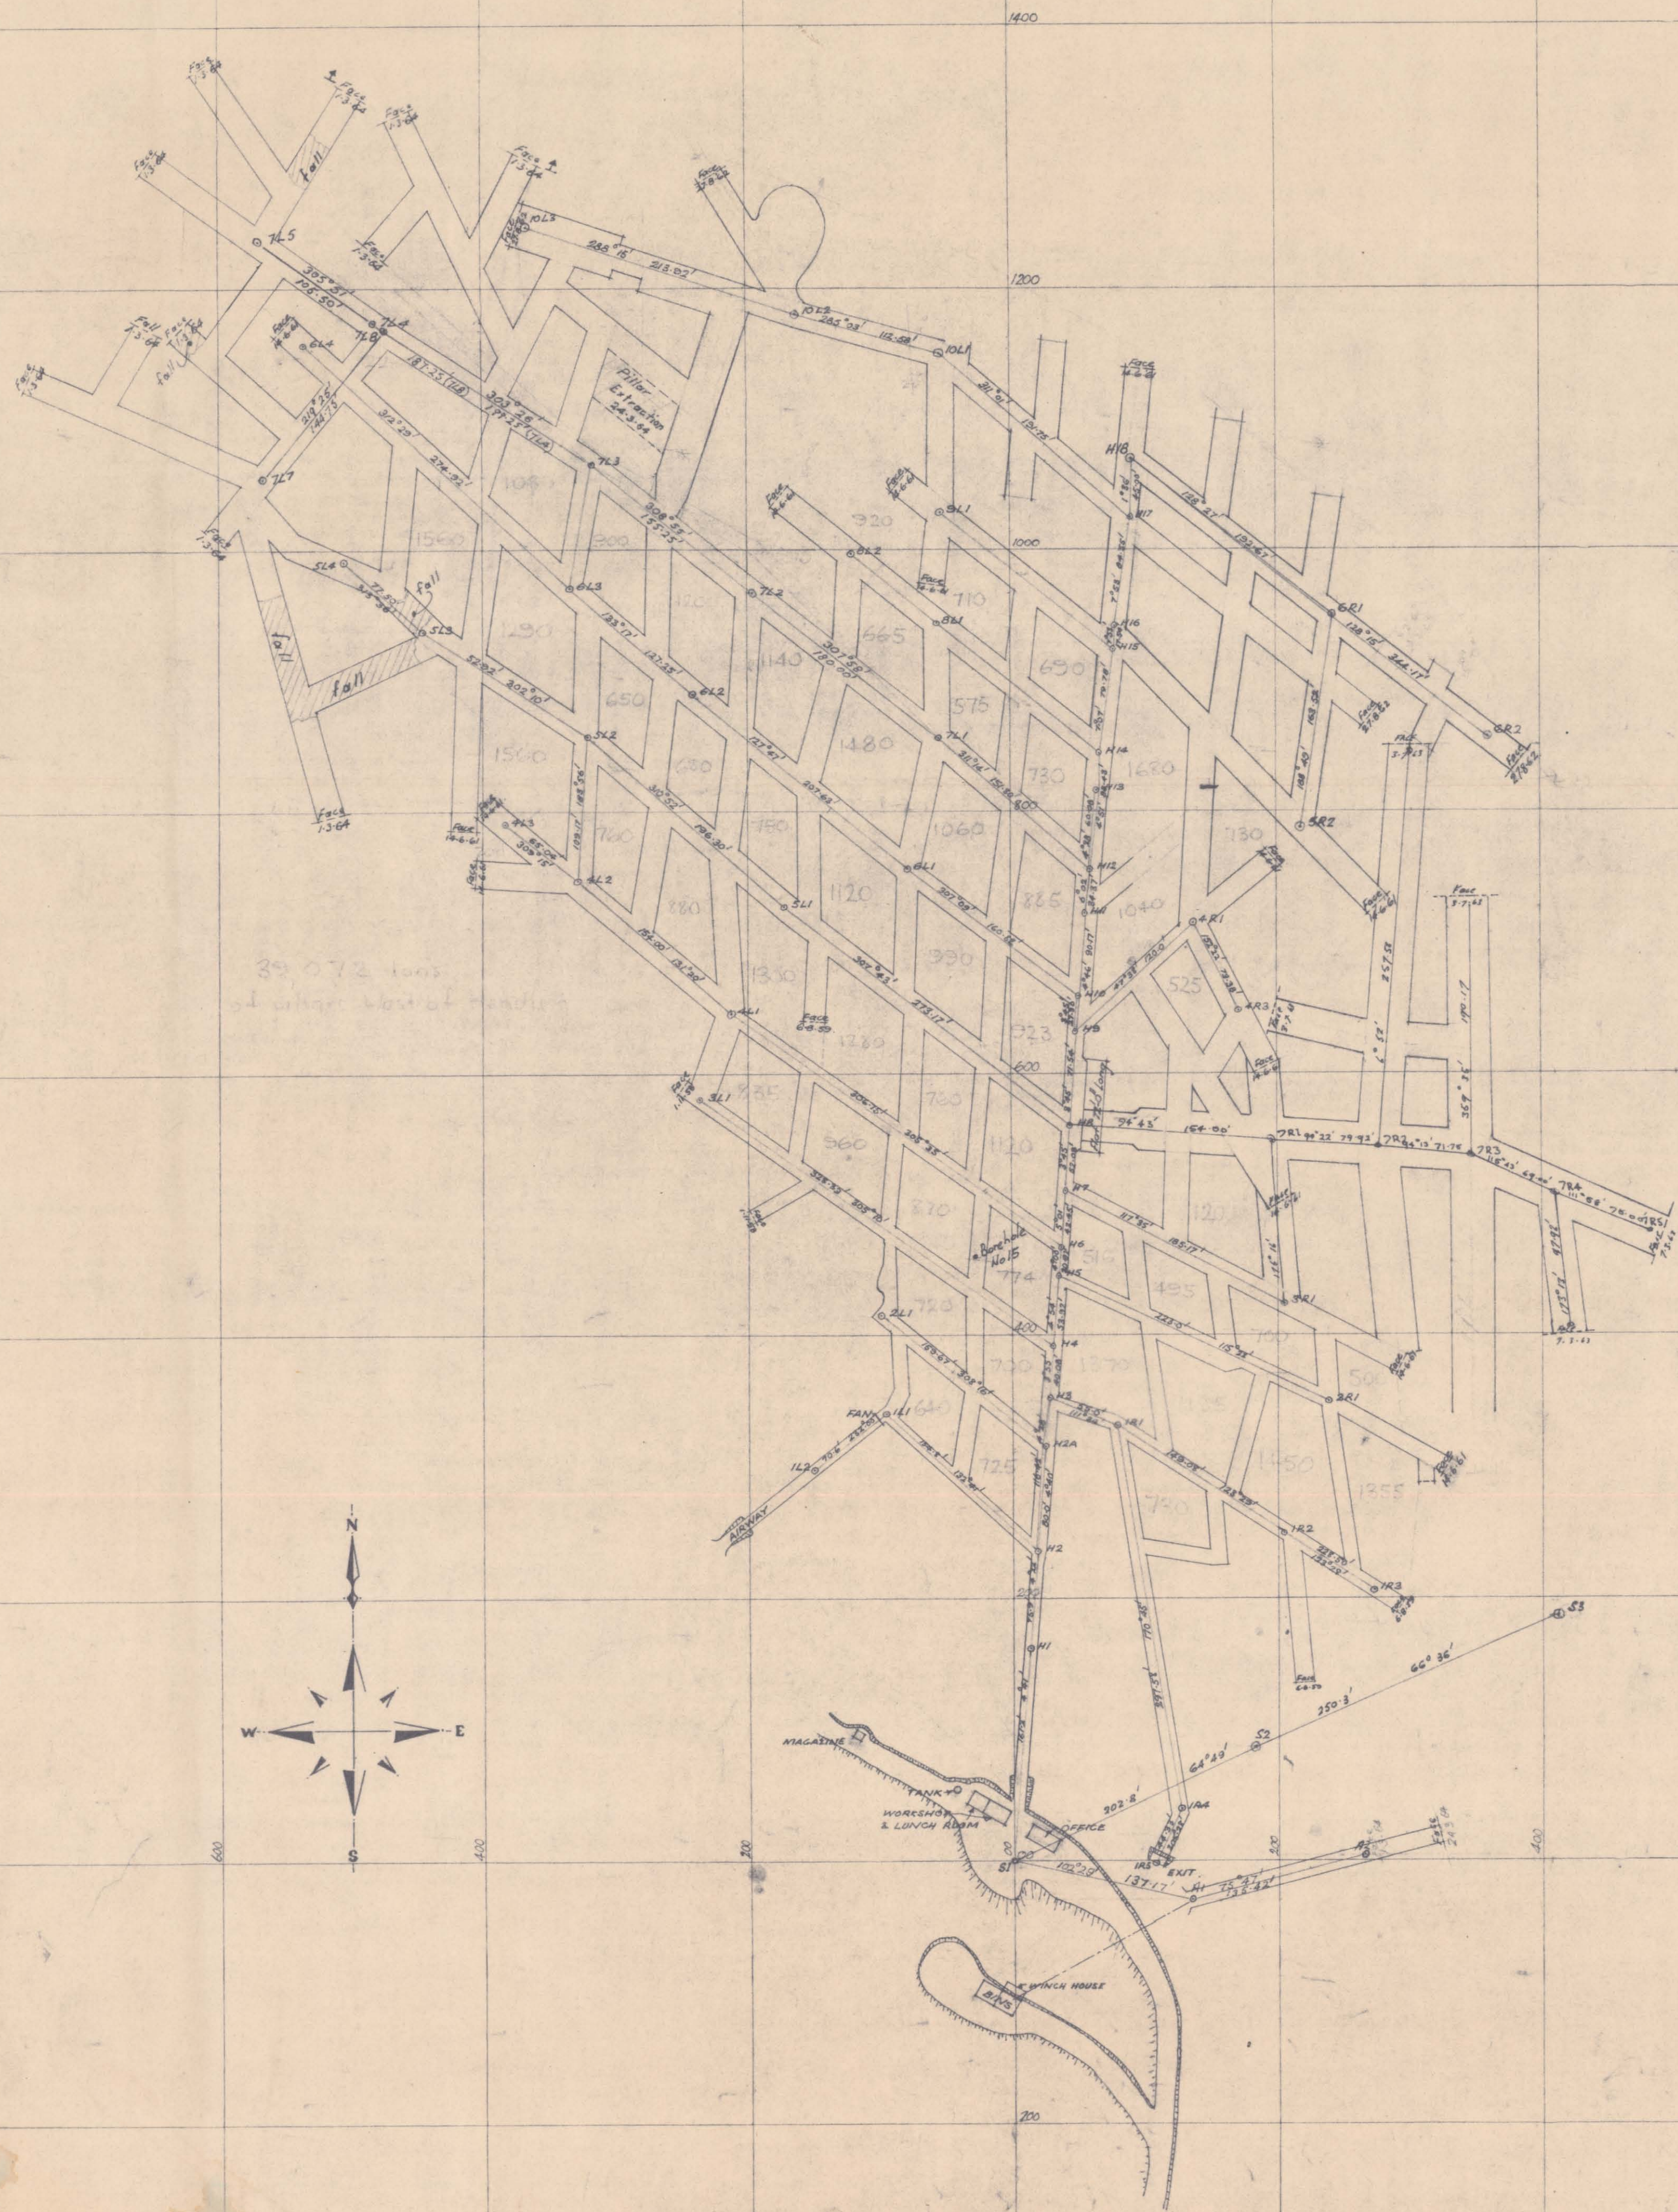

STANHOPE COLLIERIES AT AVOCA

SCALE - 1" = 80'-0"

SURVEY COMMENCED	10-12-'57
EXTENDED	1-11-'58
EXTENDED	6-8-'59
EXTENDED	14-6-'61
EXTENDED	27-8-'62
	3-7-'63
	24-3-'64