



# BLUE TIER TIN MINES N.L.

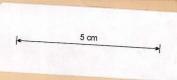


## OPEN CUT WORKINGS

SCALE 1 in = 100 ft

### PLAN

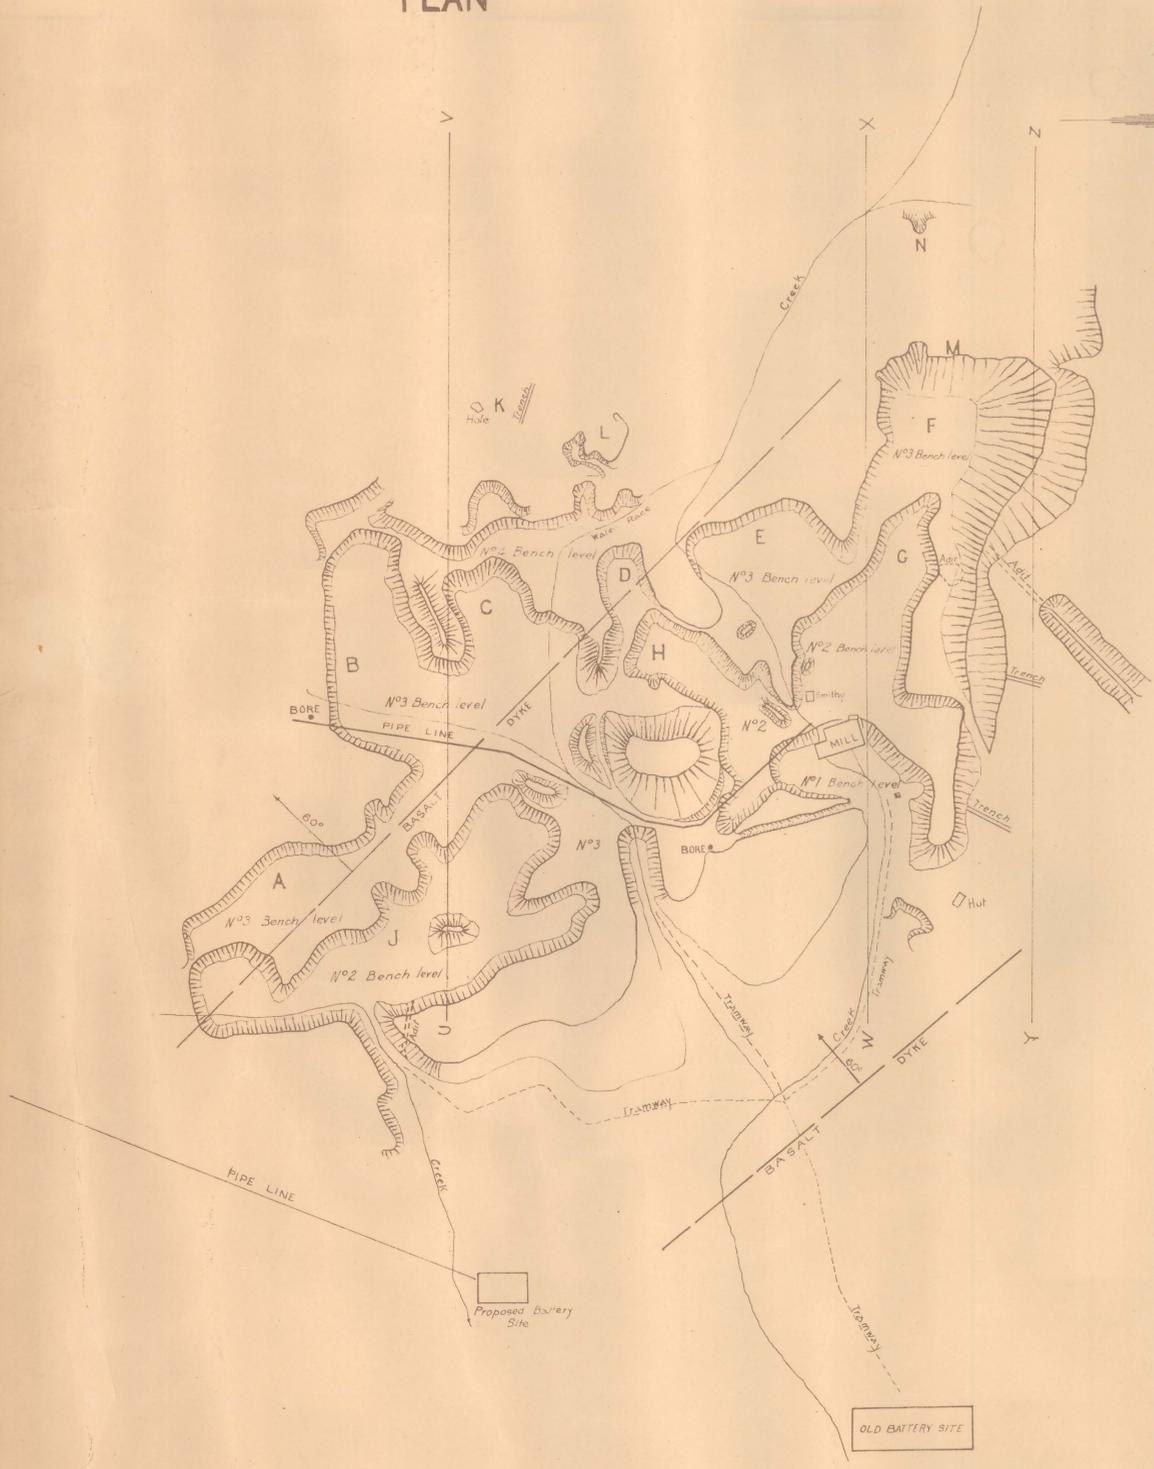

### SECTIONS

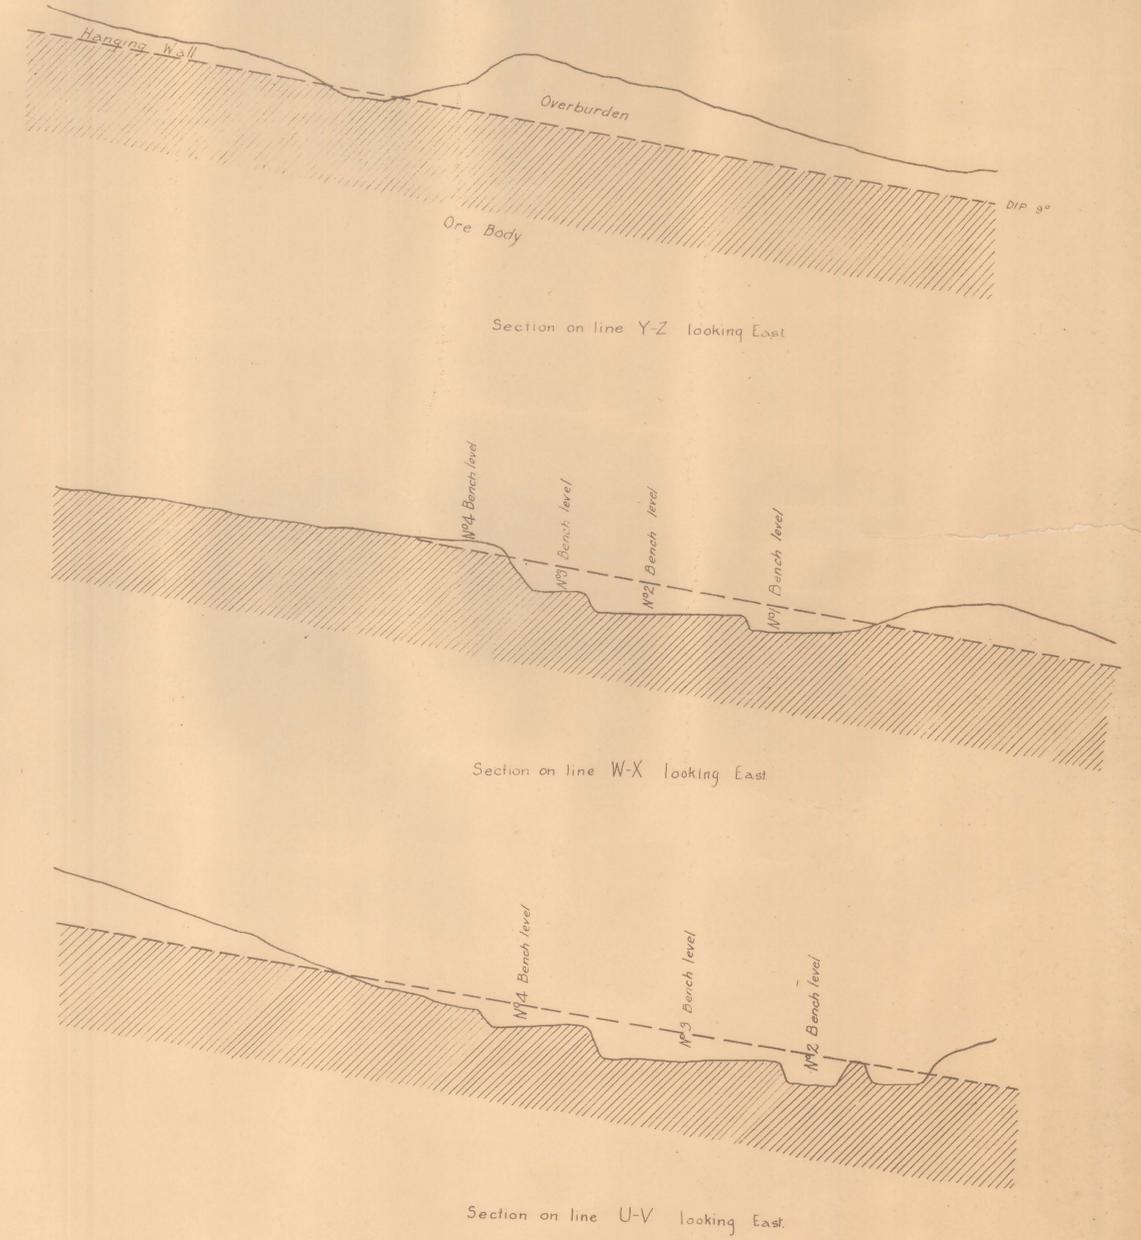

303-03

303-03