

343





20 ac.

N^o 9 SHEET
Details of Surface Sampling
Scale 50 ft. to an inch

A. R. J. D I S H I N G T O N.

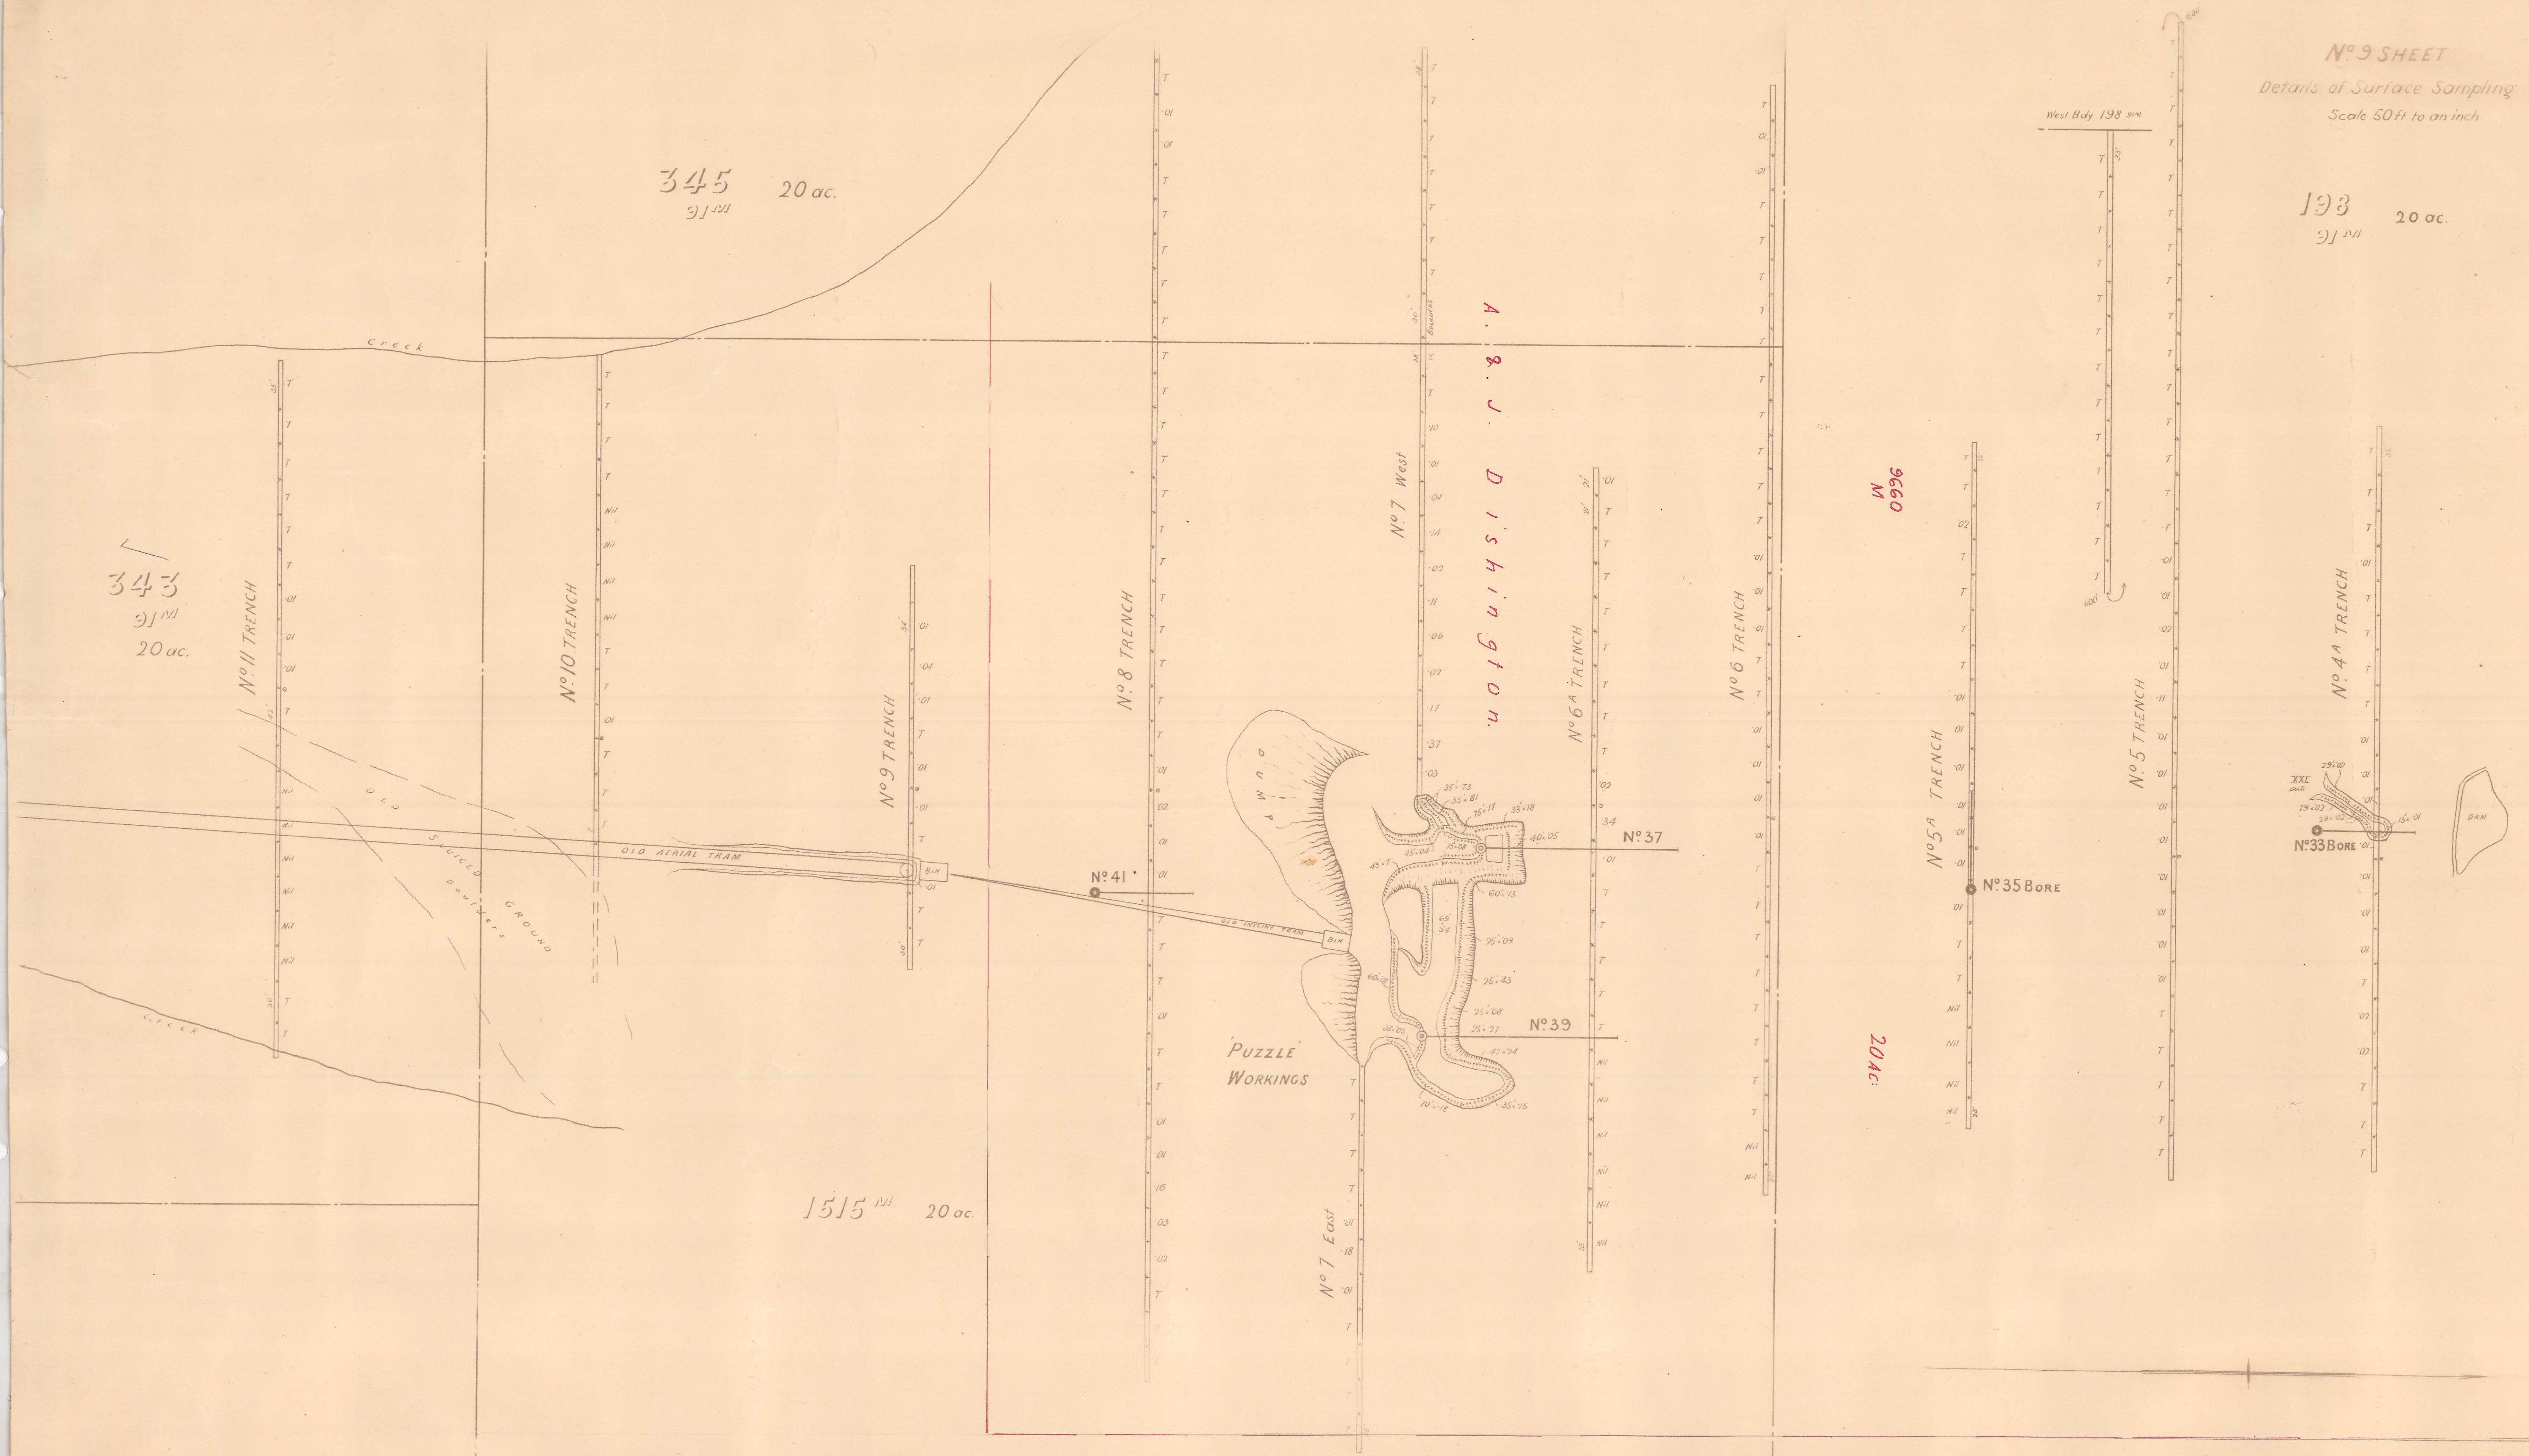

50 ft.