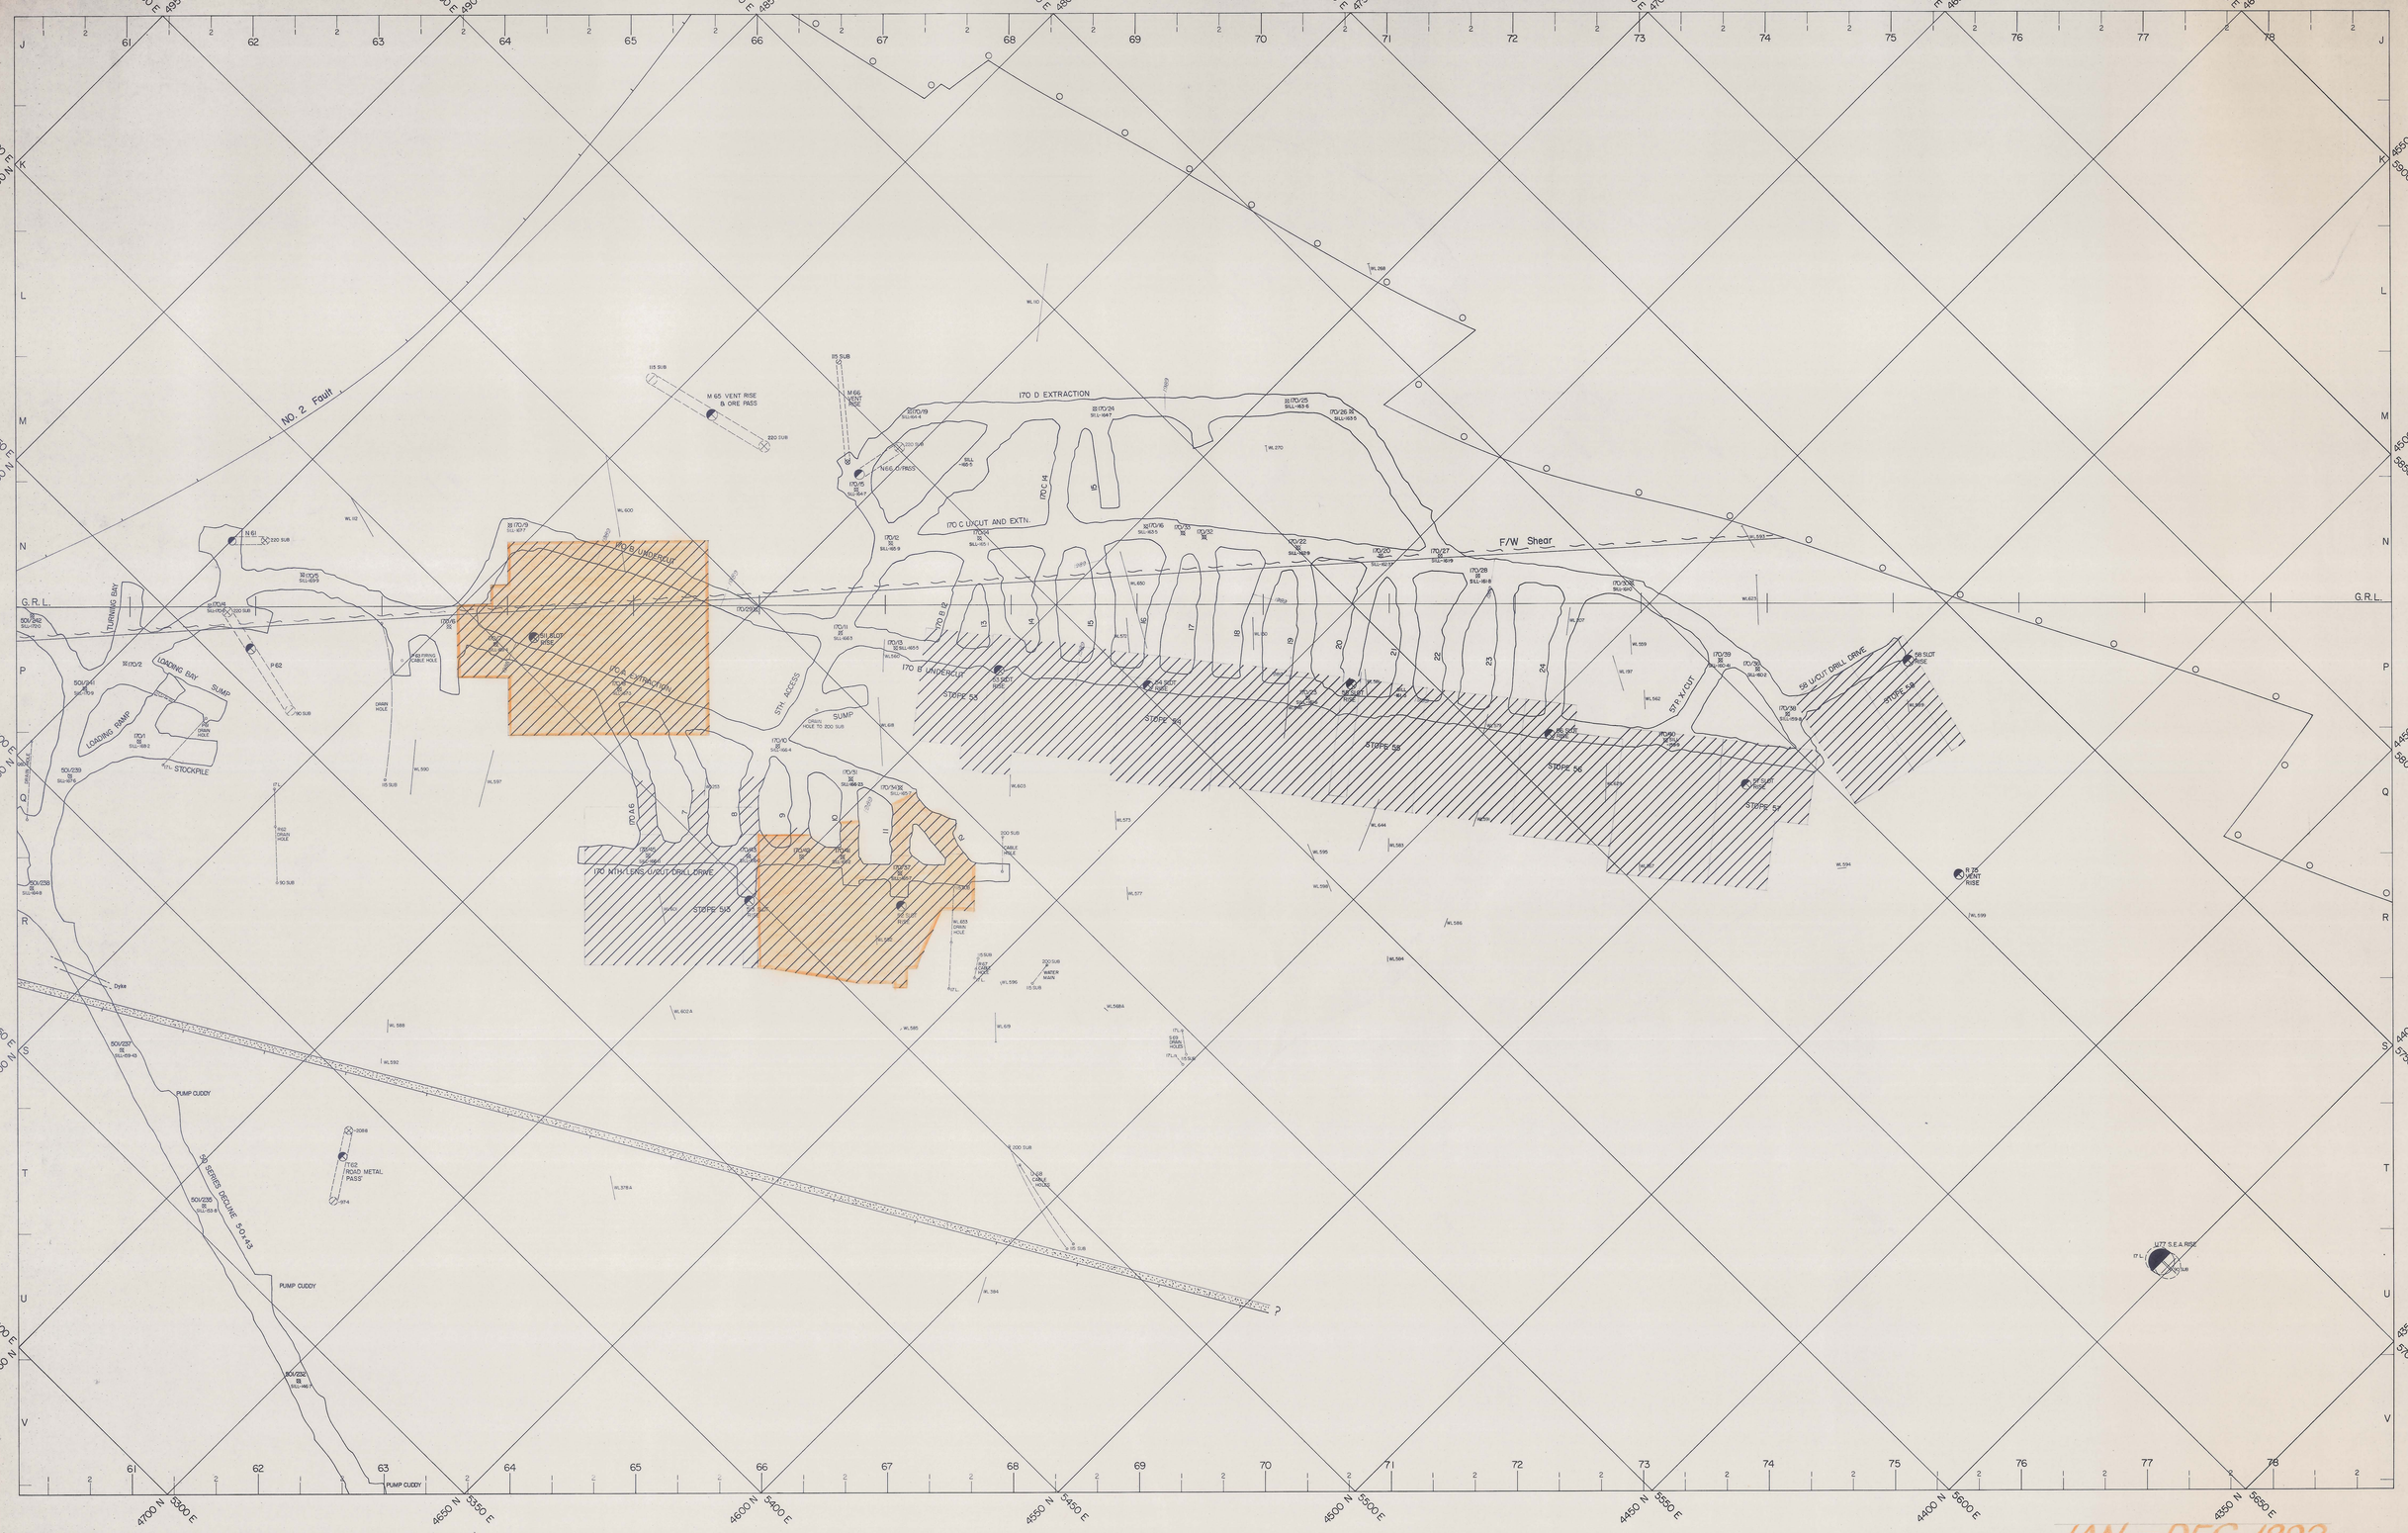

Survey station, Line pegs FLP, BLP
Rise – down
Rise – through
Rise – up
Sets
Ore outline
Conglomerate contact
Fault zone
Cable hole
Diamond drill hole collar
Diamond drill hole intersection
Diamond drill hole, end of hole
Shear
Lamprophyre Dyke

JAN. – DEC. 1992

UPDATED 18/1/93

5 cm

THE MOUNT LYELL M. & R. CO. LTD.	DRAWN	APPROVED
DATE: JUNE 1988 SCALE: 1:500	CHECKED	APPROVED
	CHECKED	APPROVED
PRINCE LYELL MINE 170 SUB-LEVEL 50 SERIES	DRAWING NUMBER A0-198	
	SHEET NUMBER —	

0413-034