BUKA-SEREM-TRIAKO JOINT VENTURE

# PLAN OF DECLINE
AS CONSTRUCTED TO
# 200 LEVEL

## CENTRAL TASMANIAN TUNGSTEN PTY. LTD.

PREPARED BY SEREM AUSTRALIA




SCALE 1:200

FILE NO: 173-194 | DATE DRAWN: 5-3-81 L. Mordel

MICROFILMED

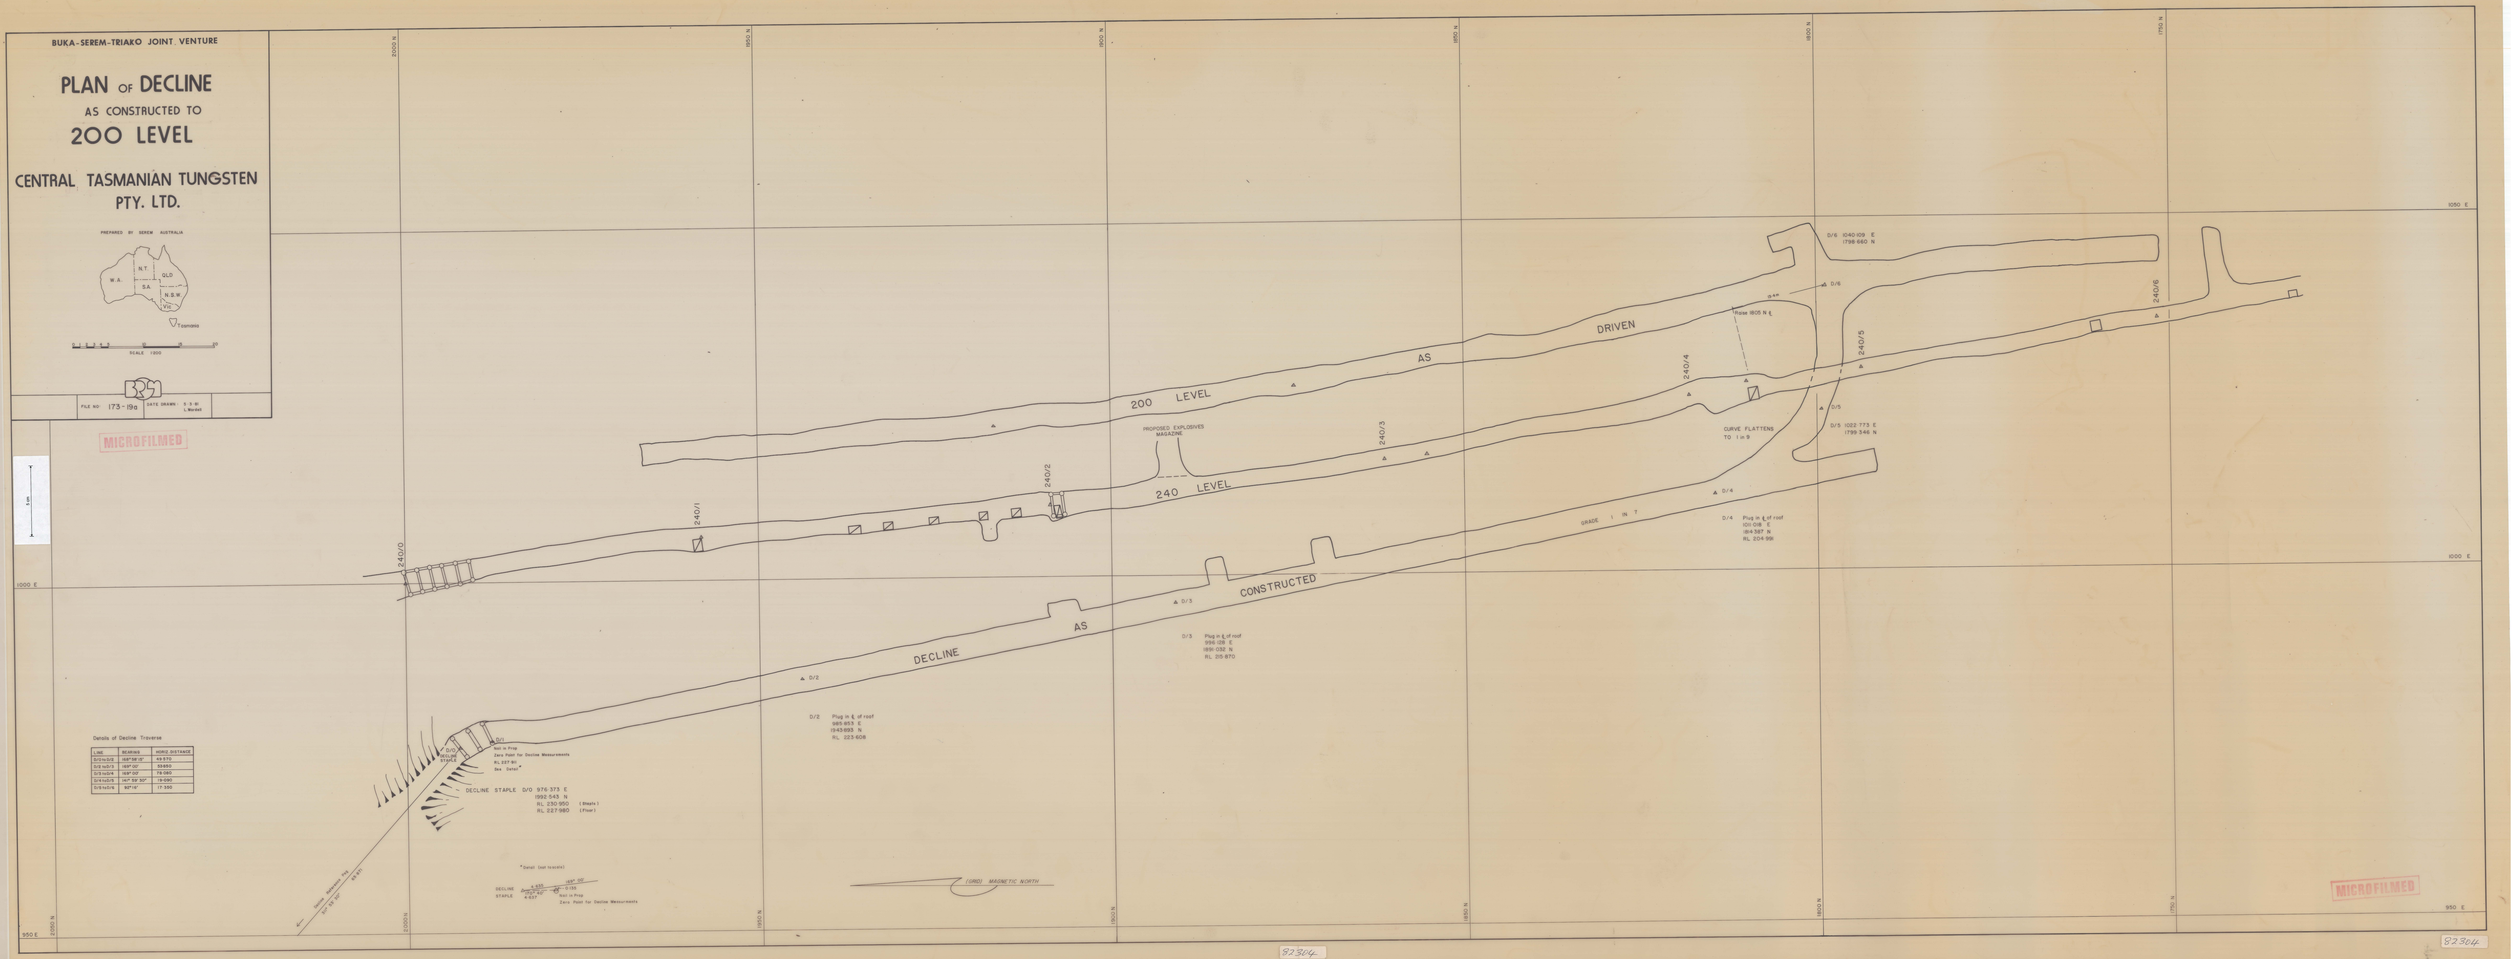


Details of Decline Traverse

| LINE | BEARING | HORIZ. DISTANCE |
|---|---|---|
| D/0 to D/1 | 168°58'13" | 49·870 |
| D/1 to D/2 | 169°00' | 50·600 |
| D/2 to D/3 | 169°00' | 79·180 |
| D/3 to D/4 | 147°53'30" | 19·080 |
| D/4 to D/5 | 90°16' | 17·550 |

MICROFILMED

0395_022

82364

82364

82364