


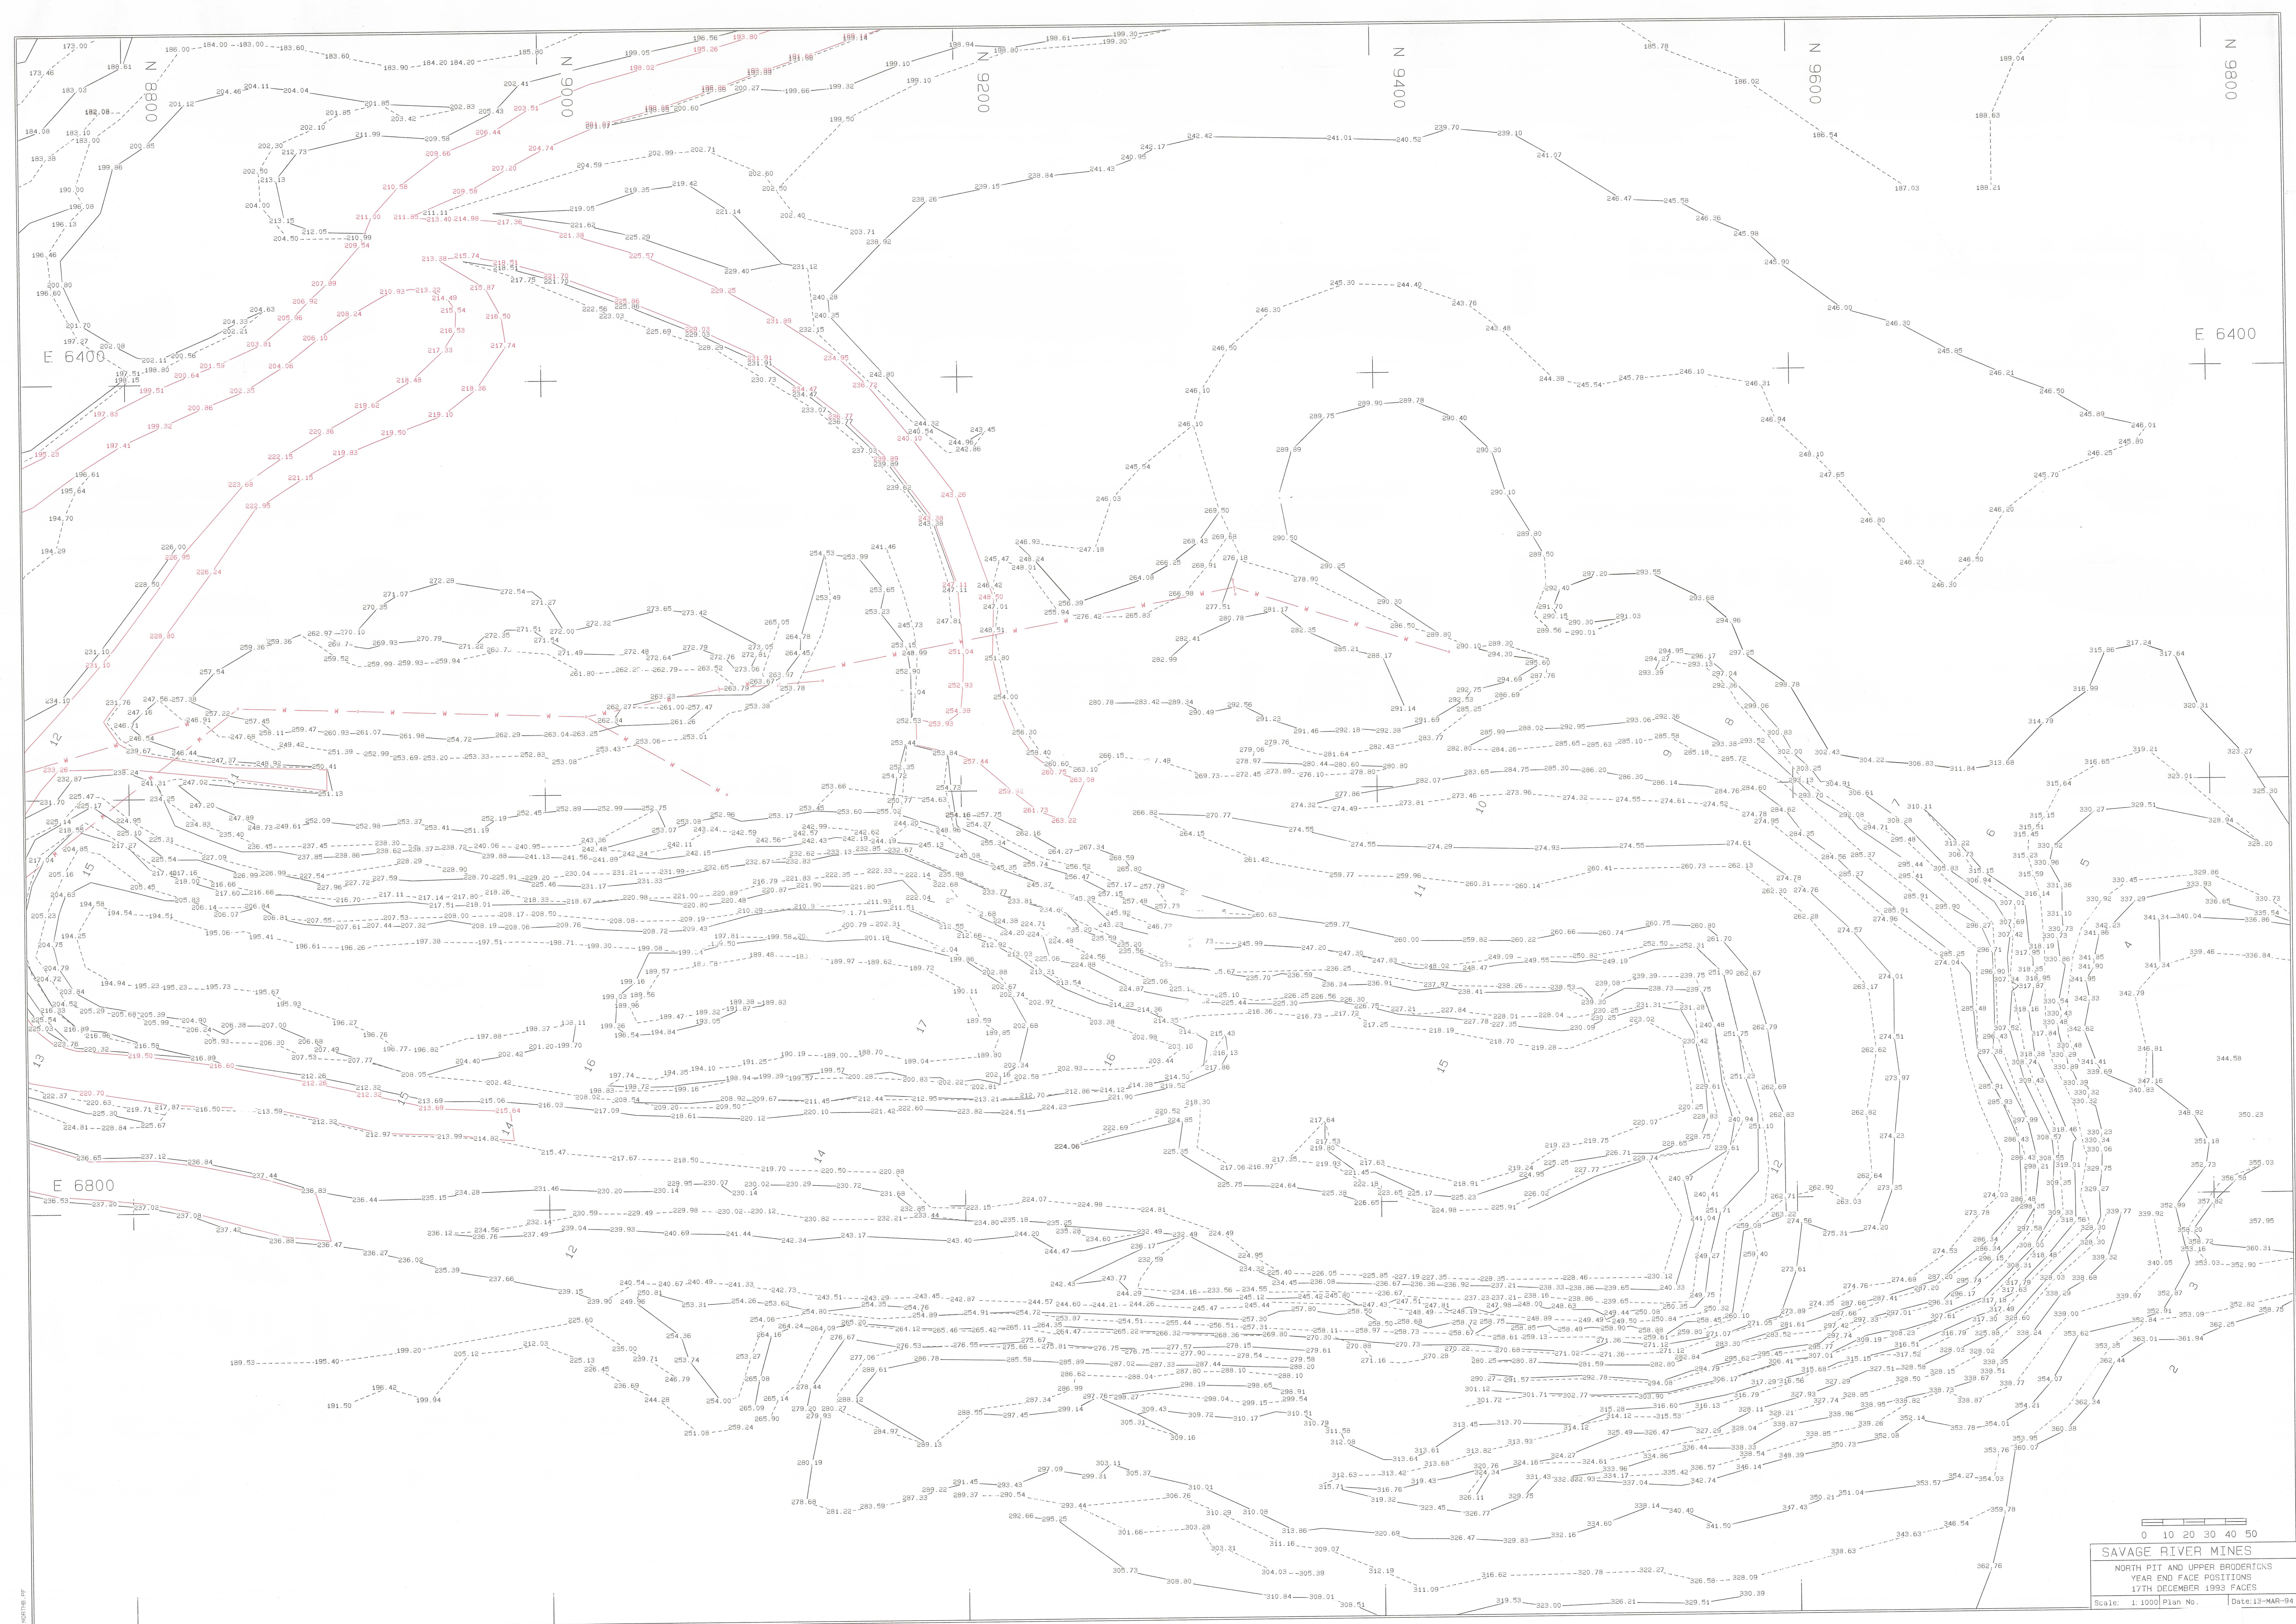

0400-0016