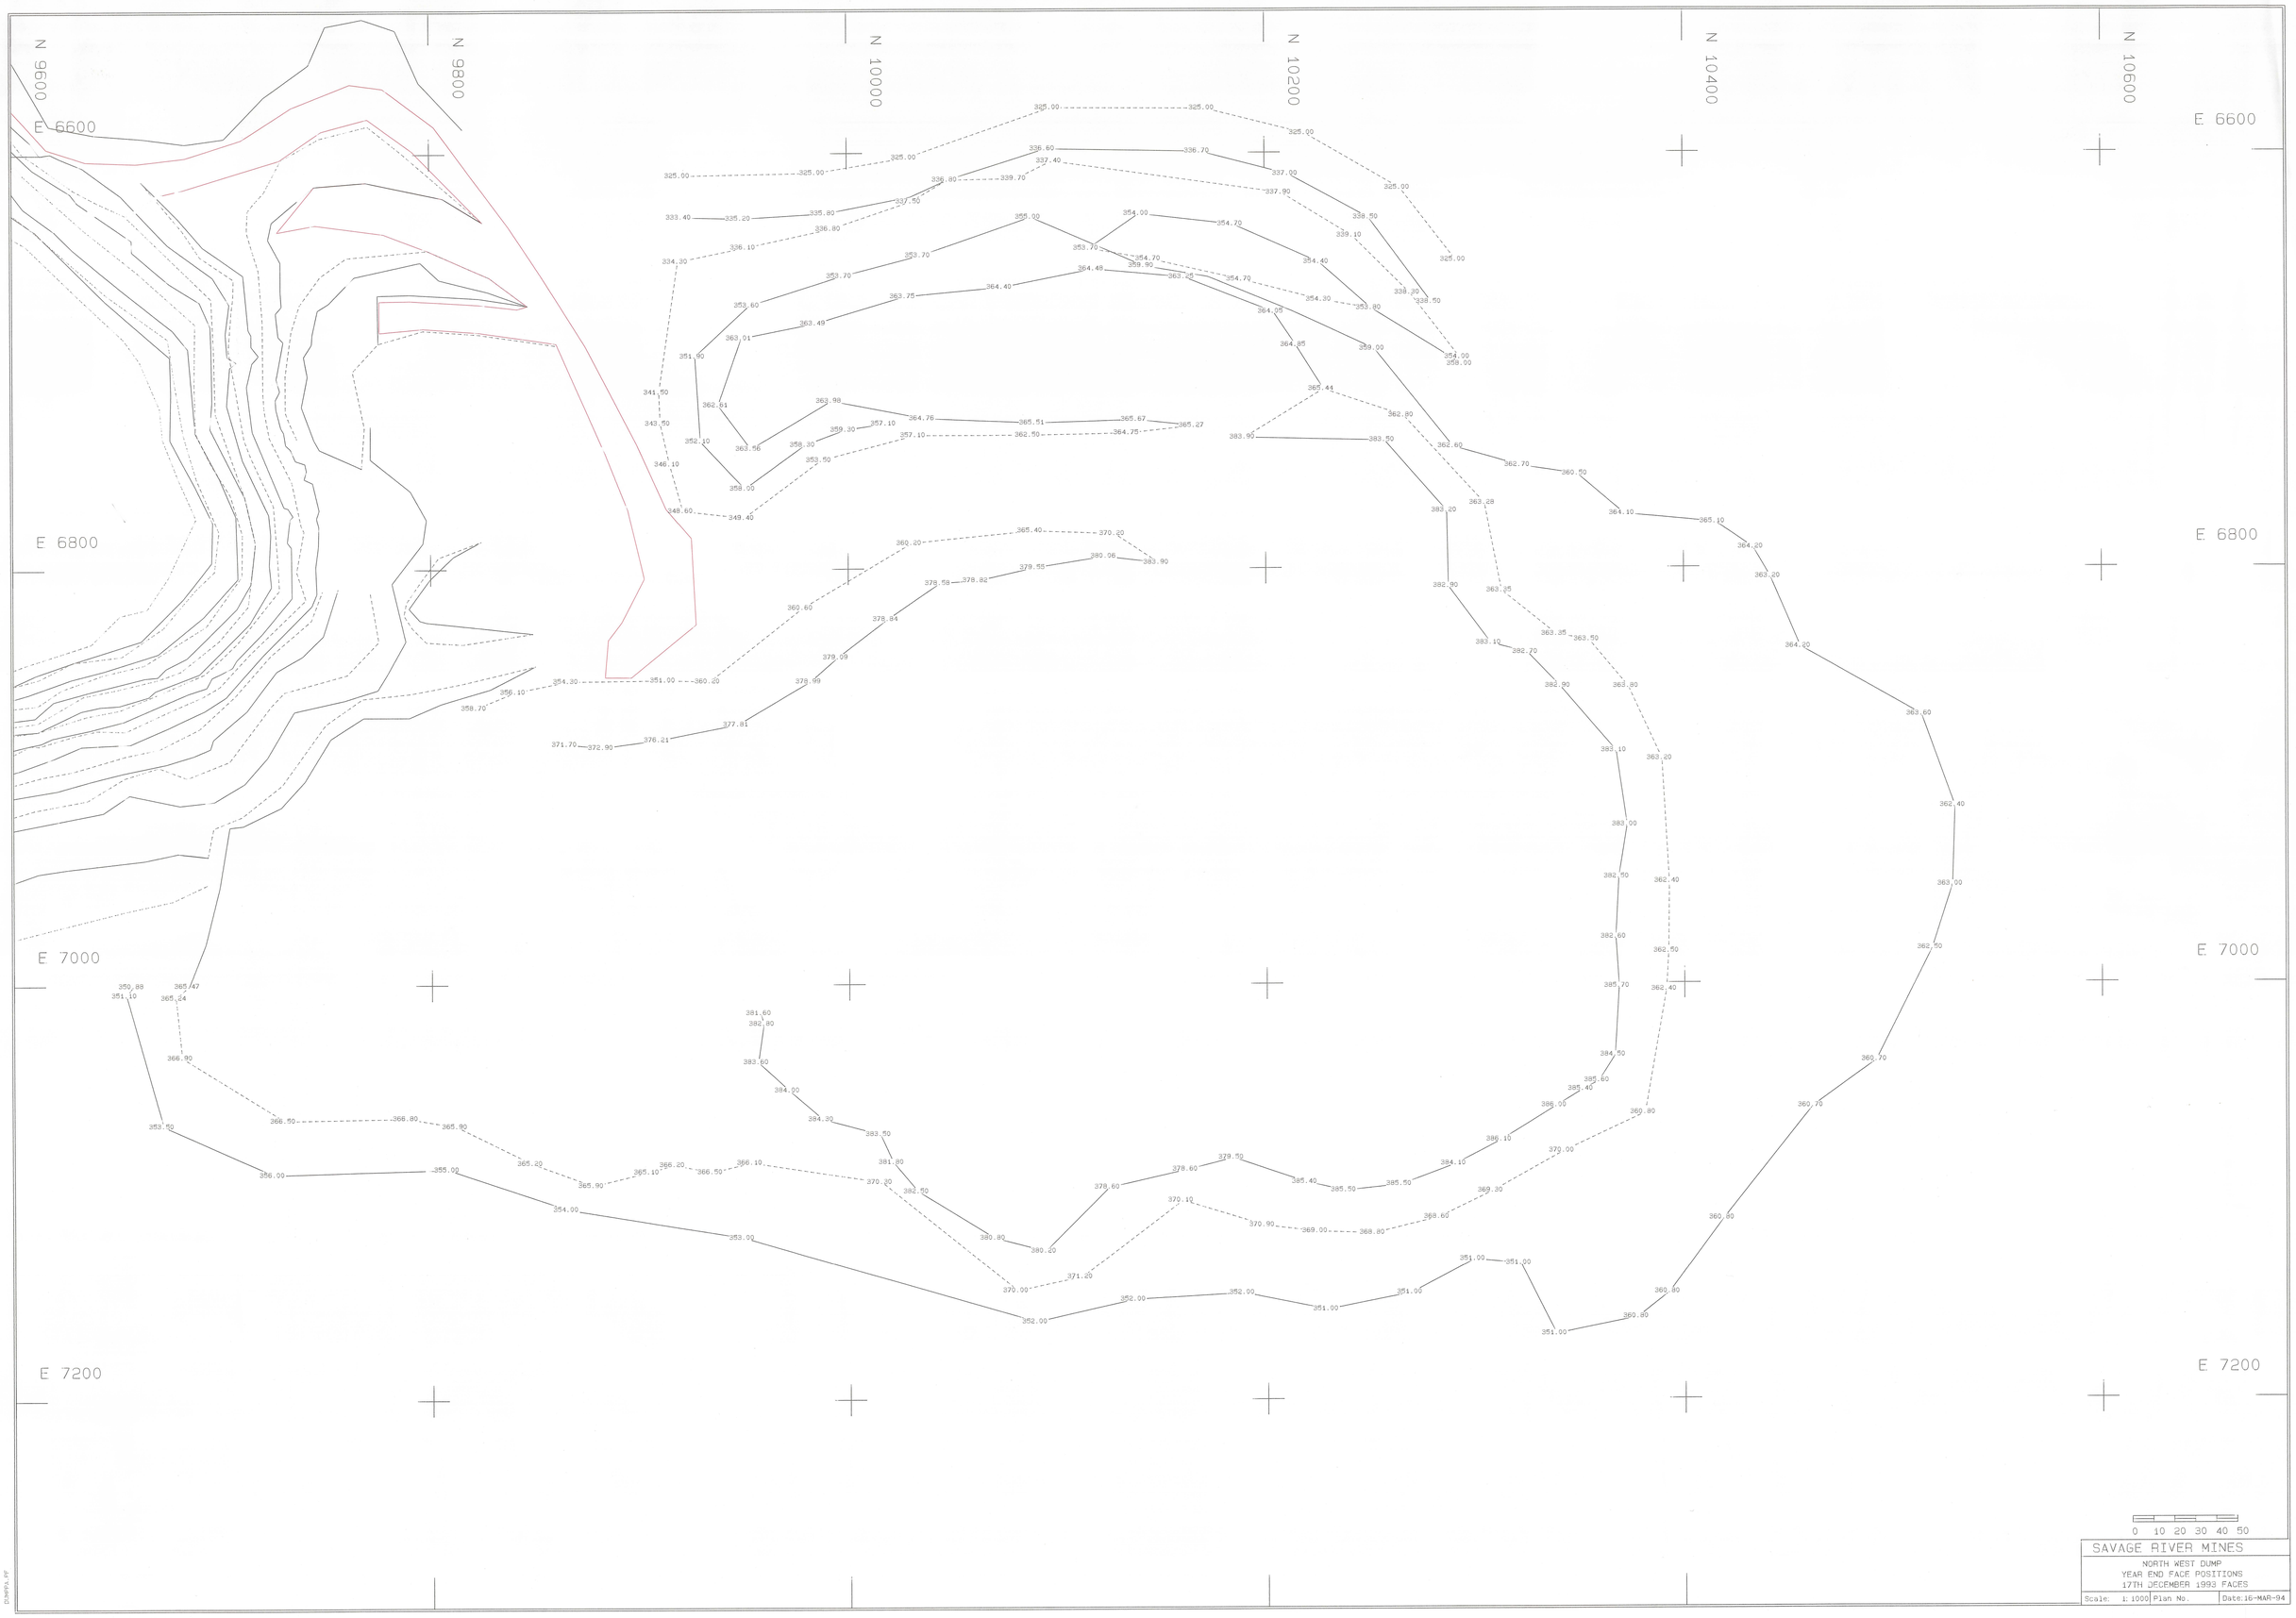

SURPAC SOFTWARE INTERNATIONAL, AUSTRALIA

04 - 00 - 017