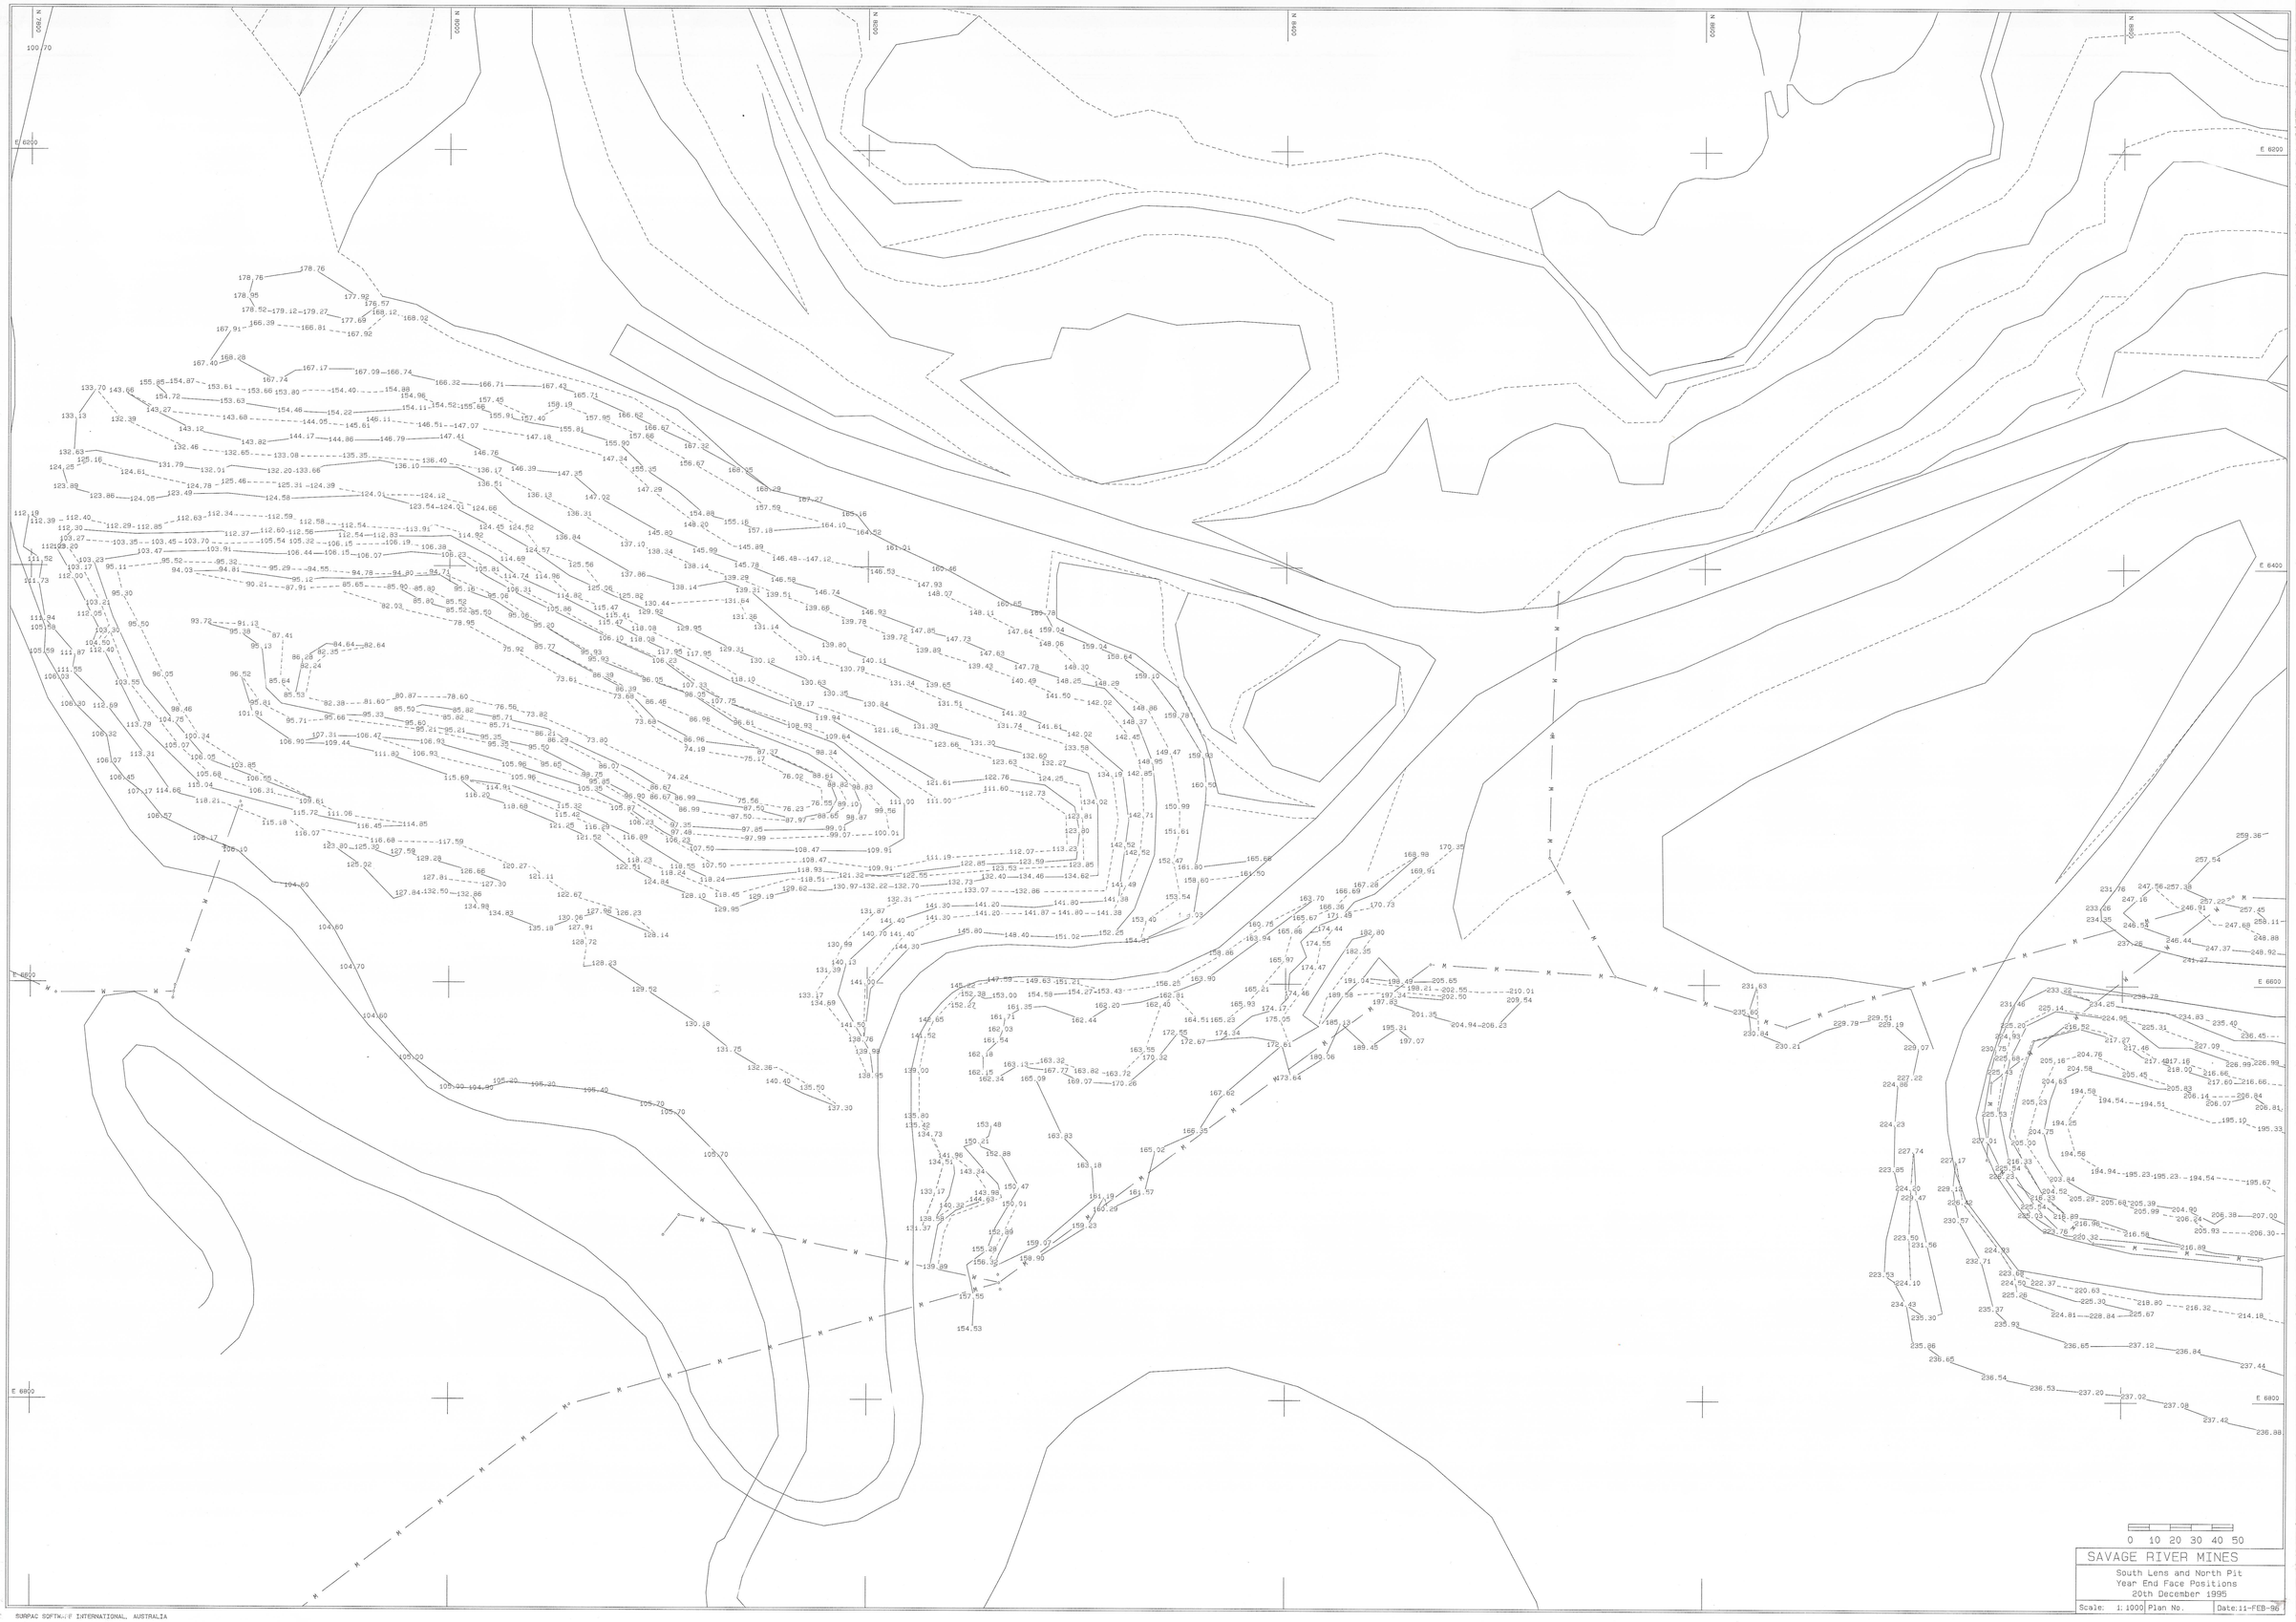

04 00 - 02 - 024

SURPAC SOFTWARE INTERNATIONAL, AUSTRALIA