


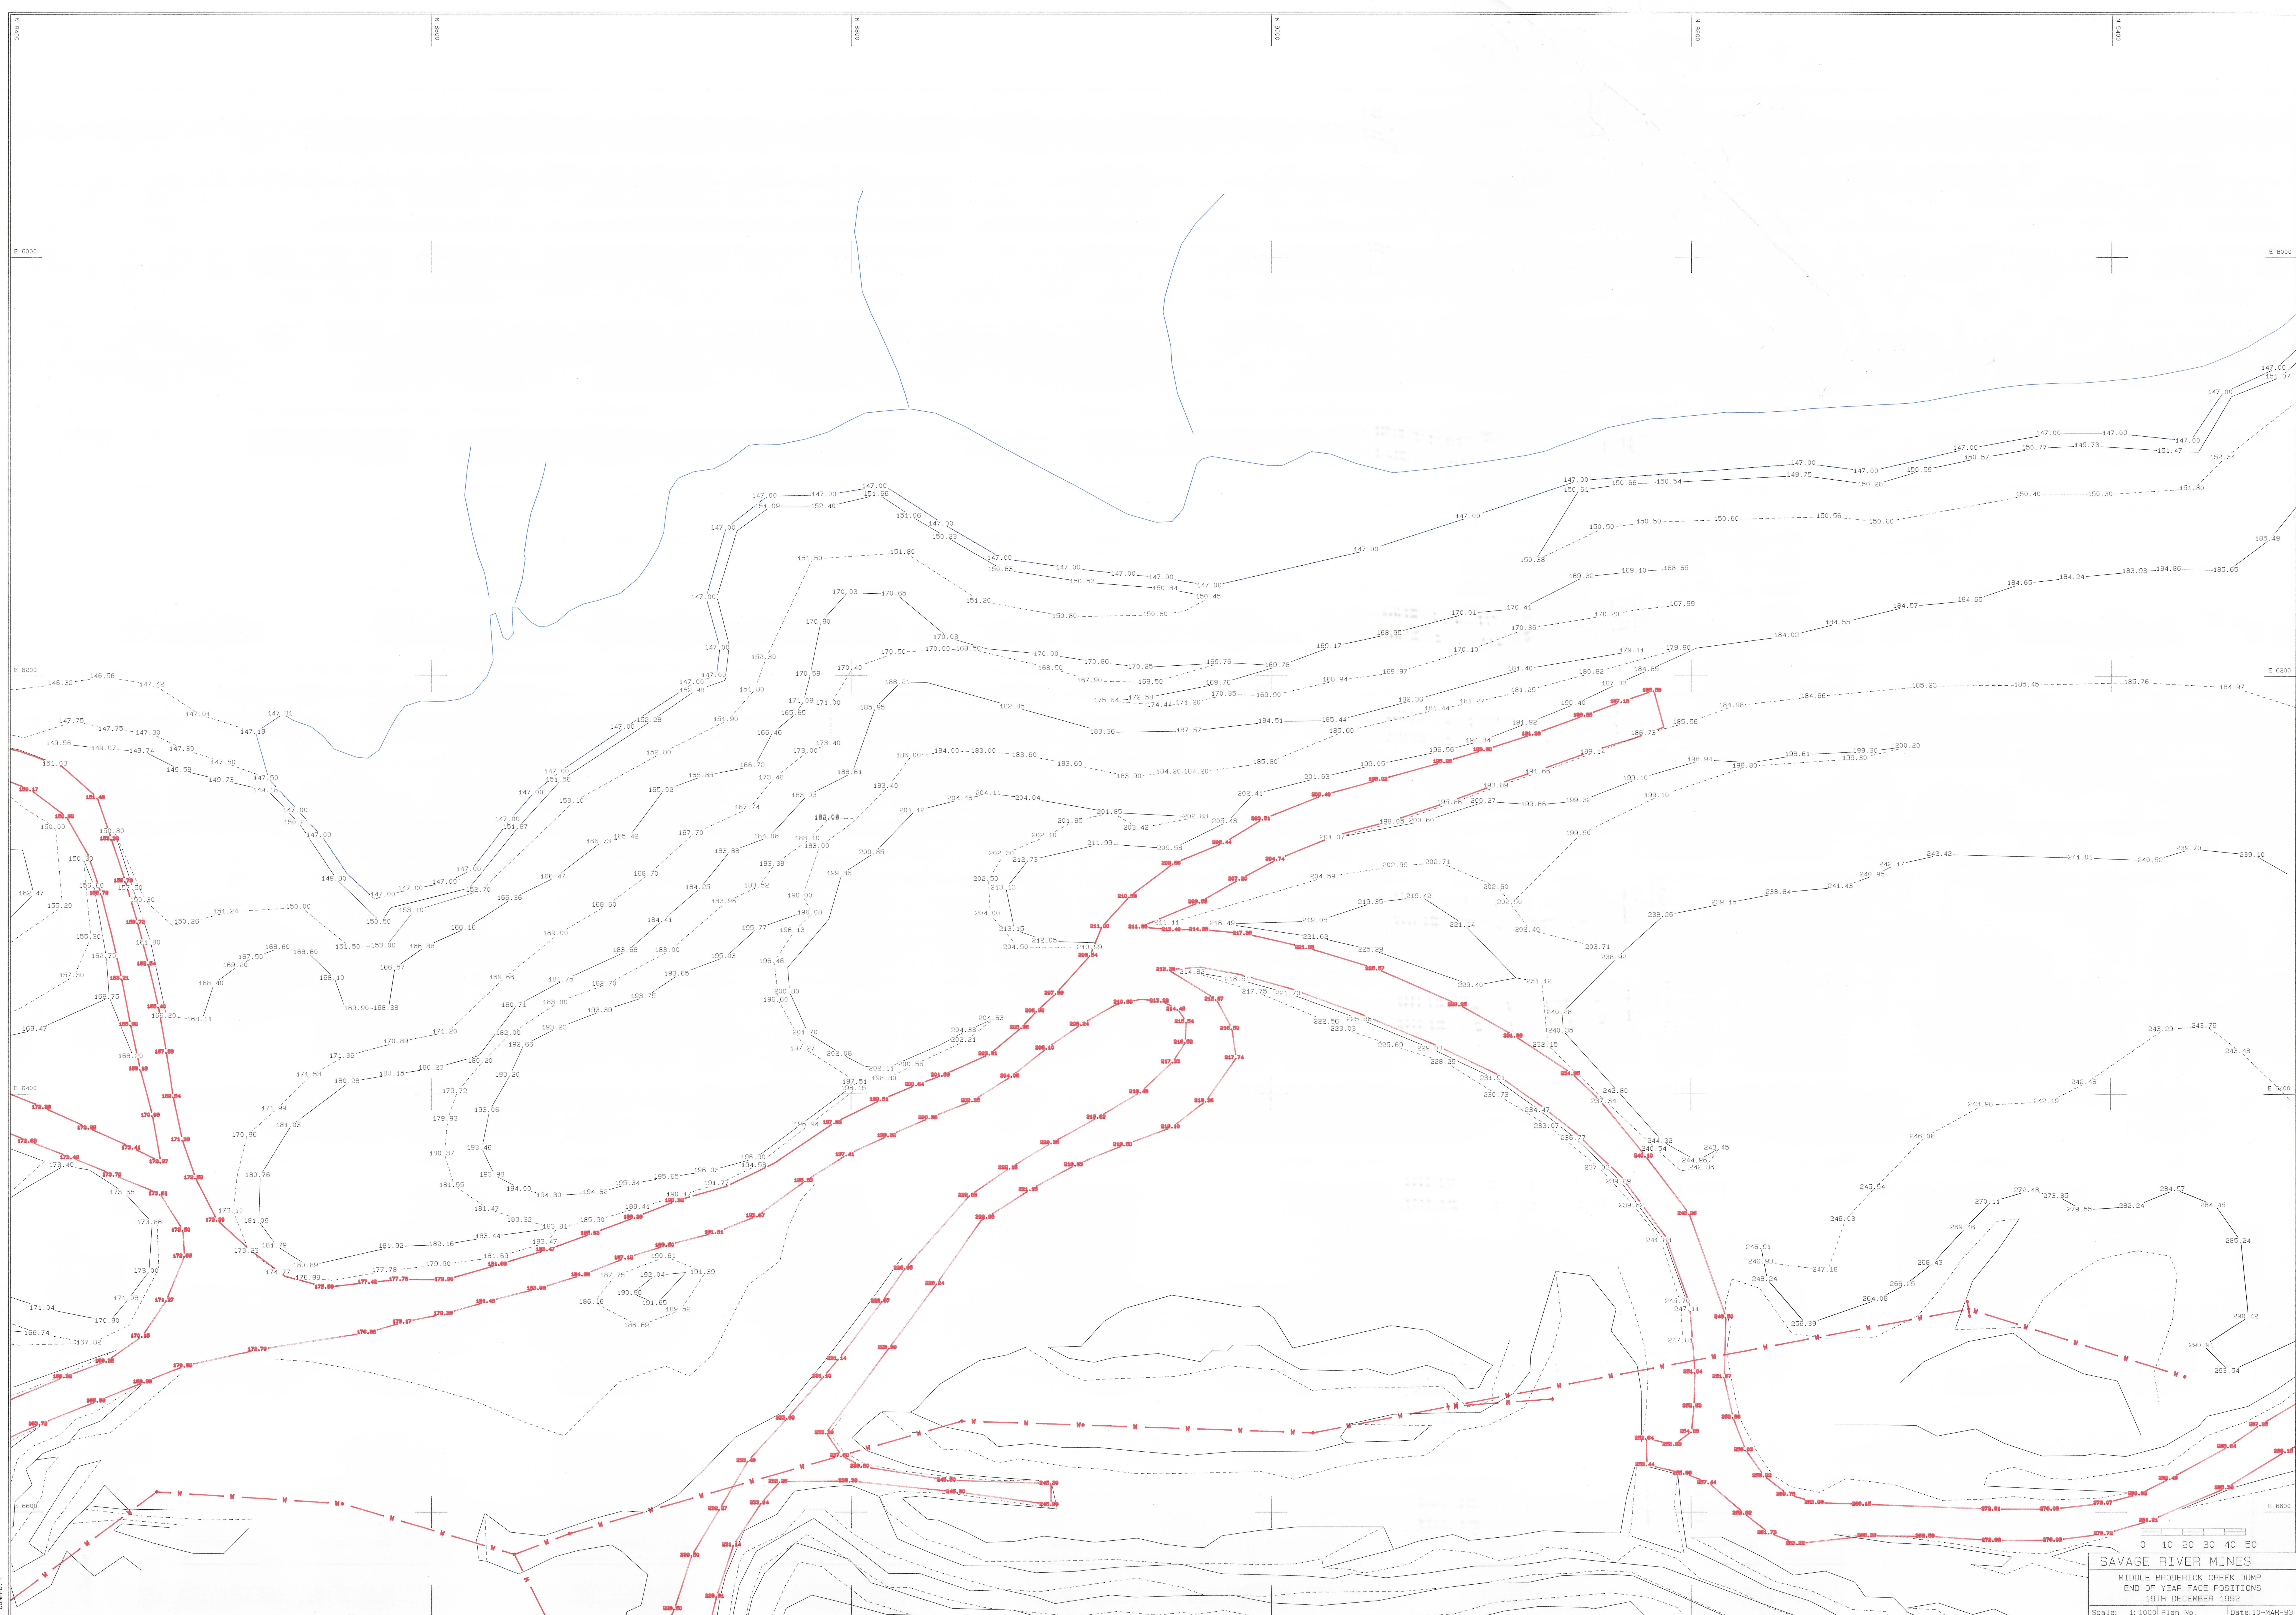

SAVAGE RIVER MINES  
MIDDLE BRODERICK CREEK DUMP  
END OF YEAR FACE POSITIONS  
19TH DECEMBER 1992  
Scale: 1:1000 Plan No. Date: 10-MAR-93

0 10 20 30 40 50  
5m  
0400-033

0400-033