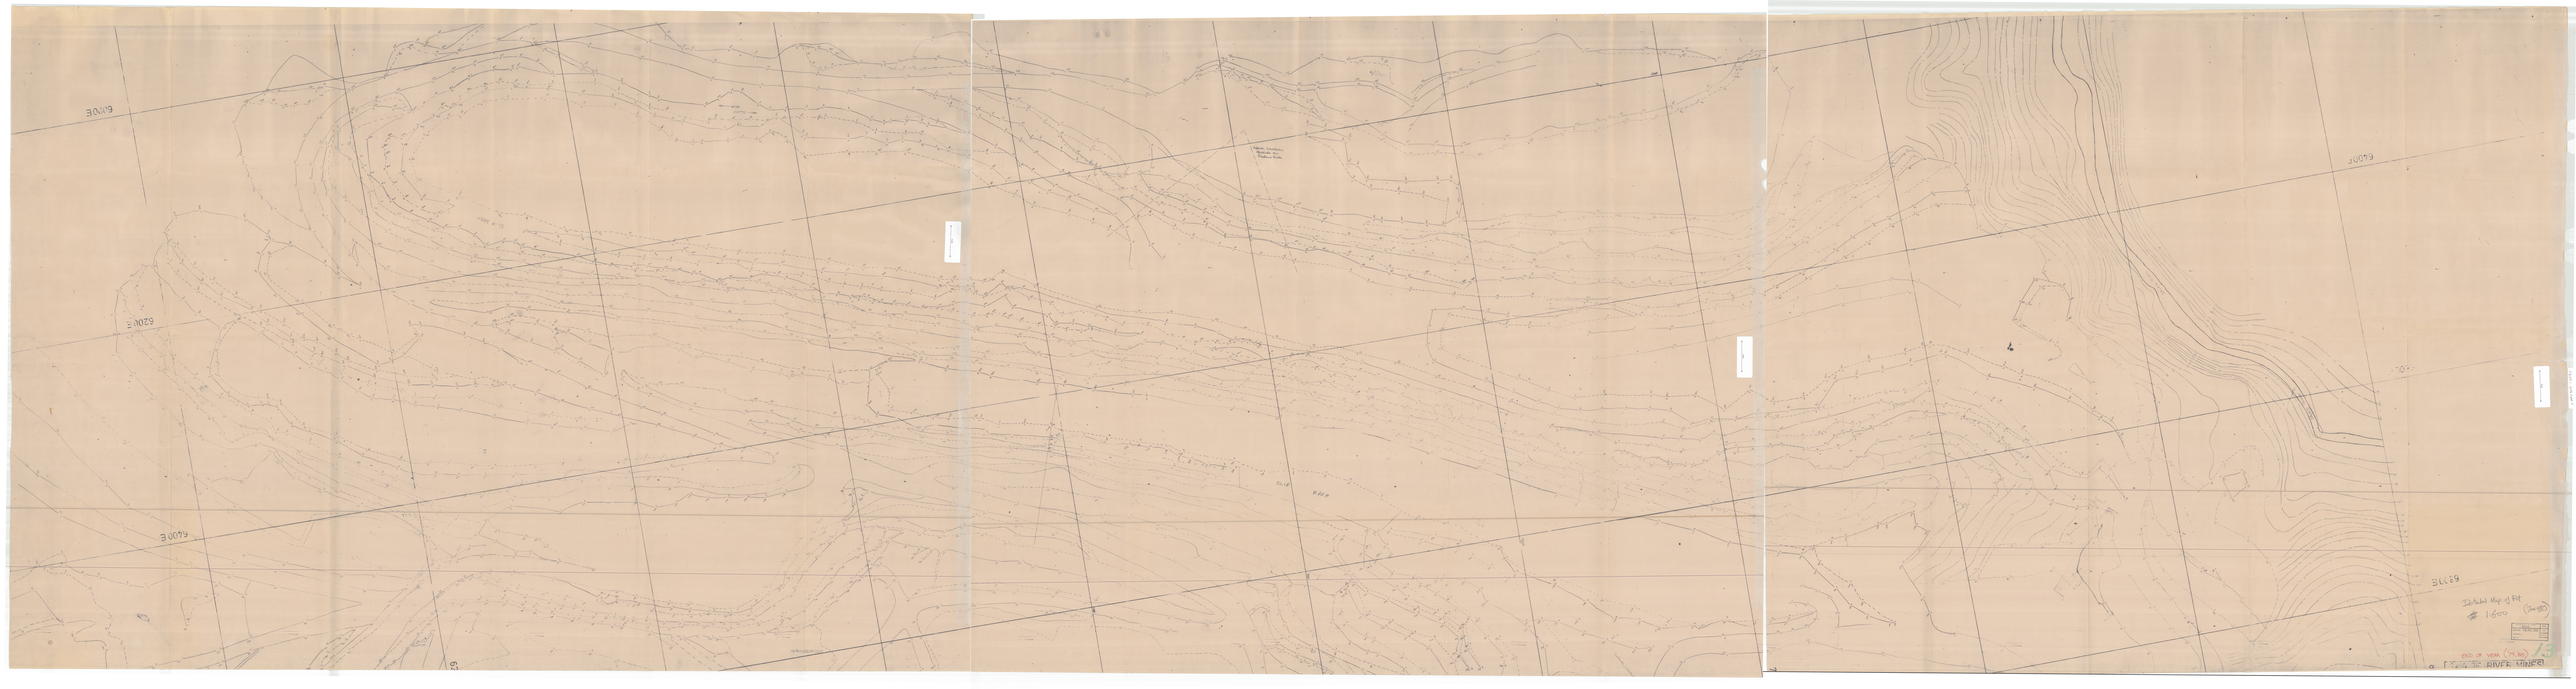

6000E
6200E
6400E
6800E
SLIP AREA
SLIP AREA
Approx. Location of slide on Western Knob.
SAVAGE RIVER
5 cm

Detailed Map of Pit
1:600 (JUN 1980)

DEPARTMENT OF MINES
BURNIE
RECEIVED 30 JUL 1980
ANSWERED
REF. No.
S.M.E.
M.E.
E. & I.L.

END OF YEAR ('79,'80) 13

SAVAGE RIVER MINES

0400-036 PART 5