


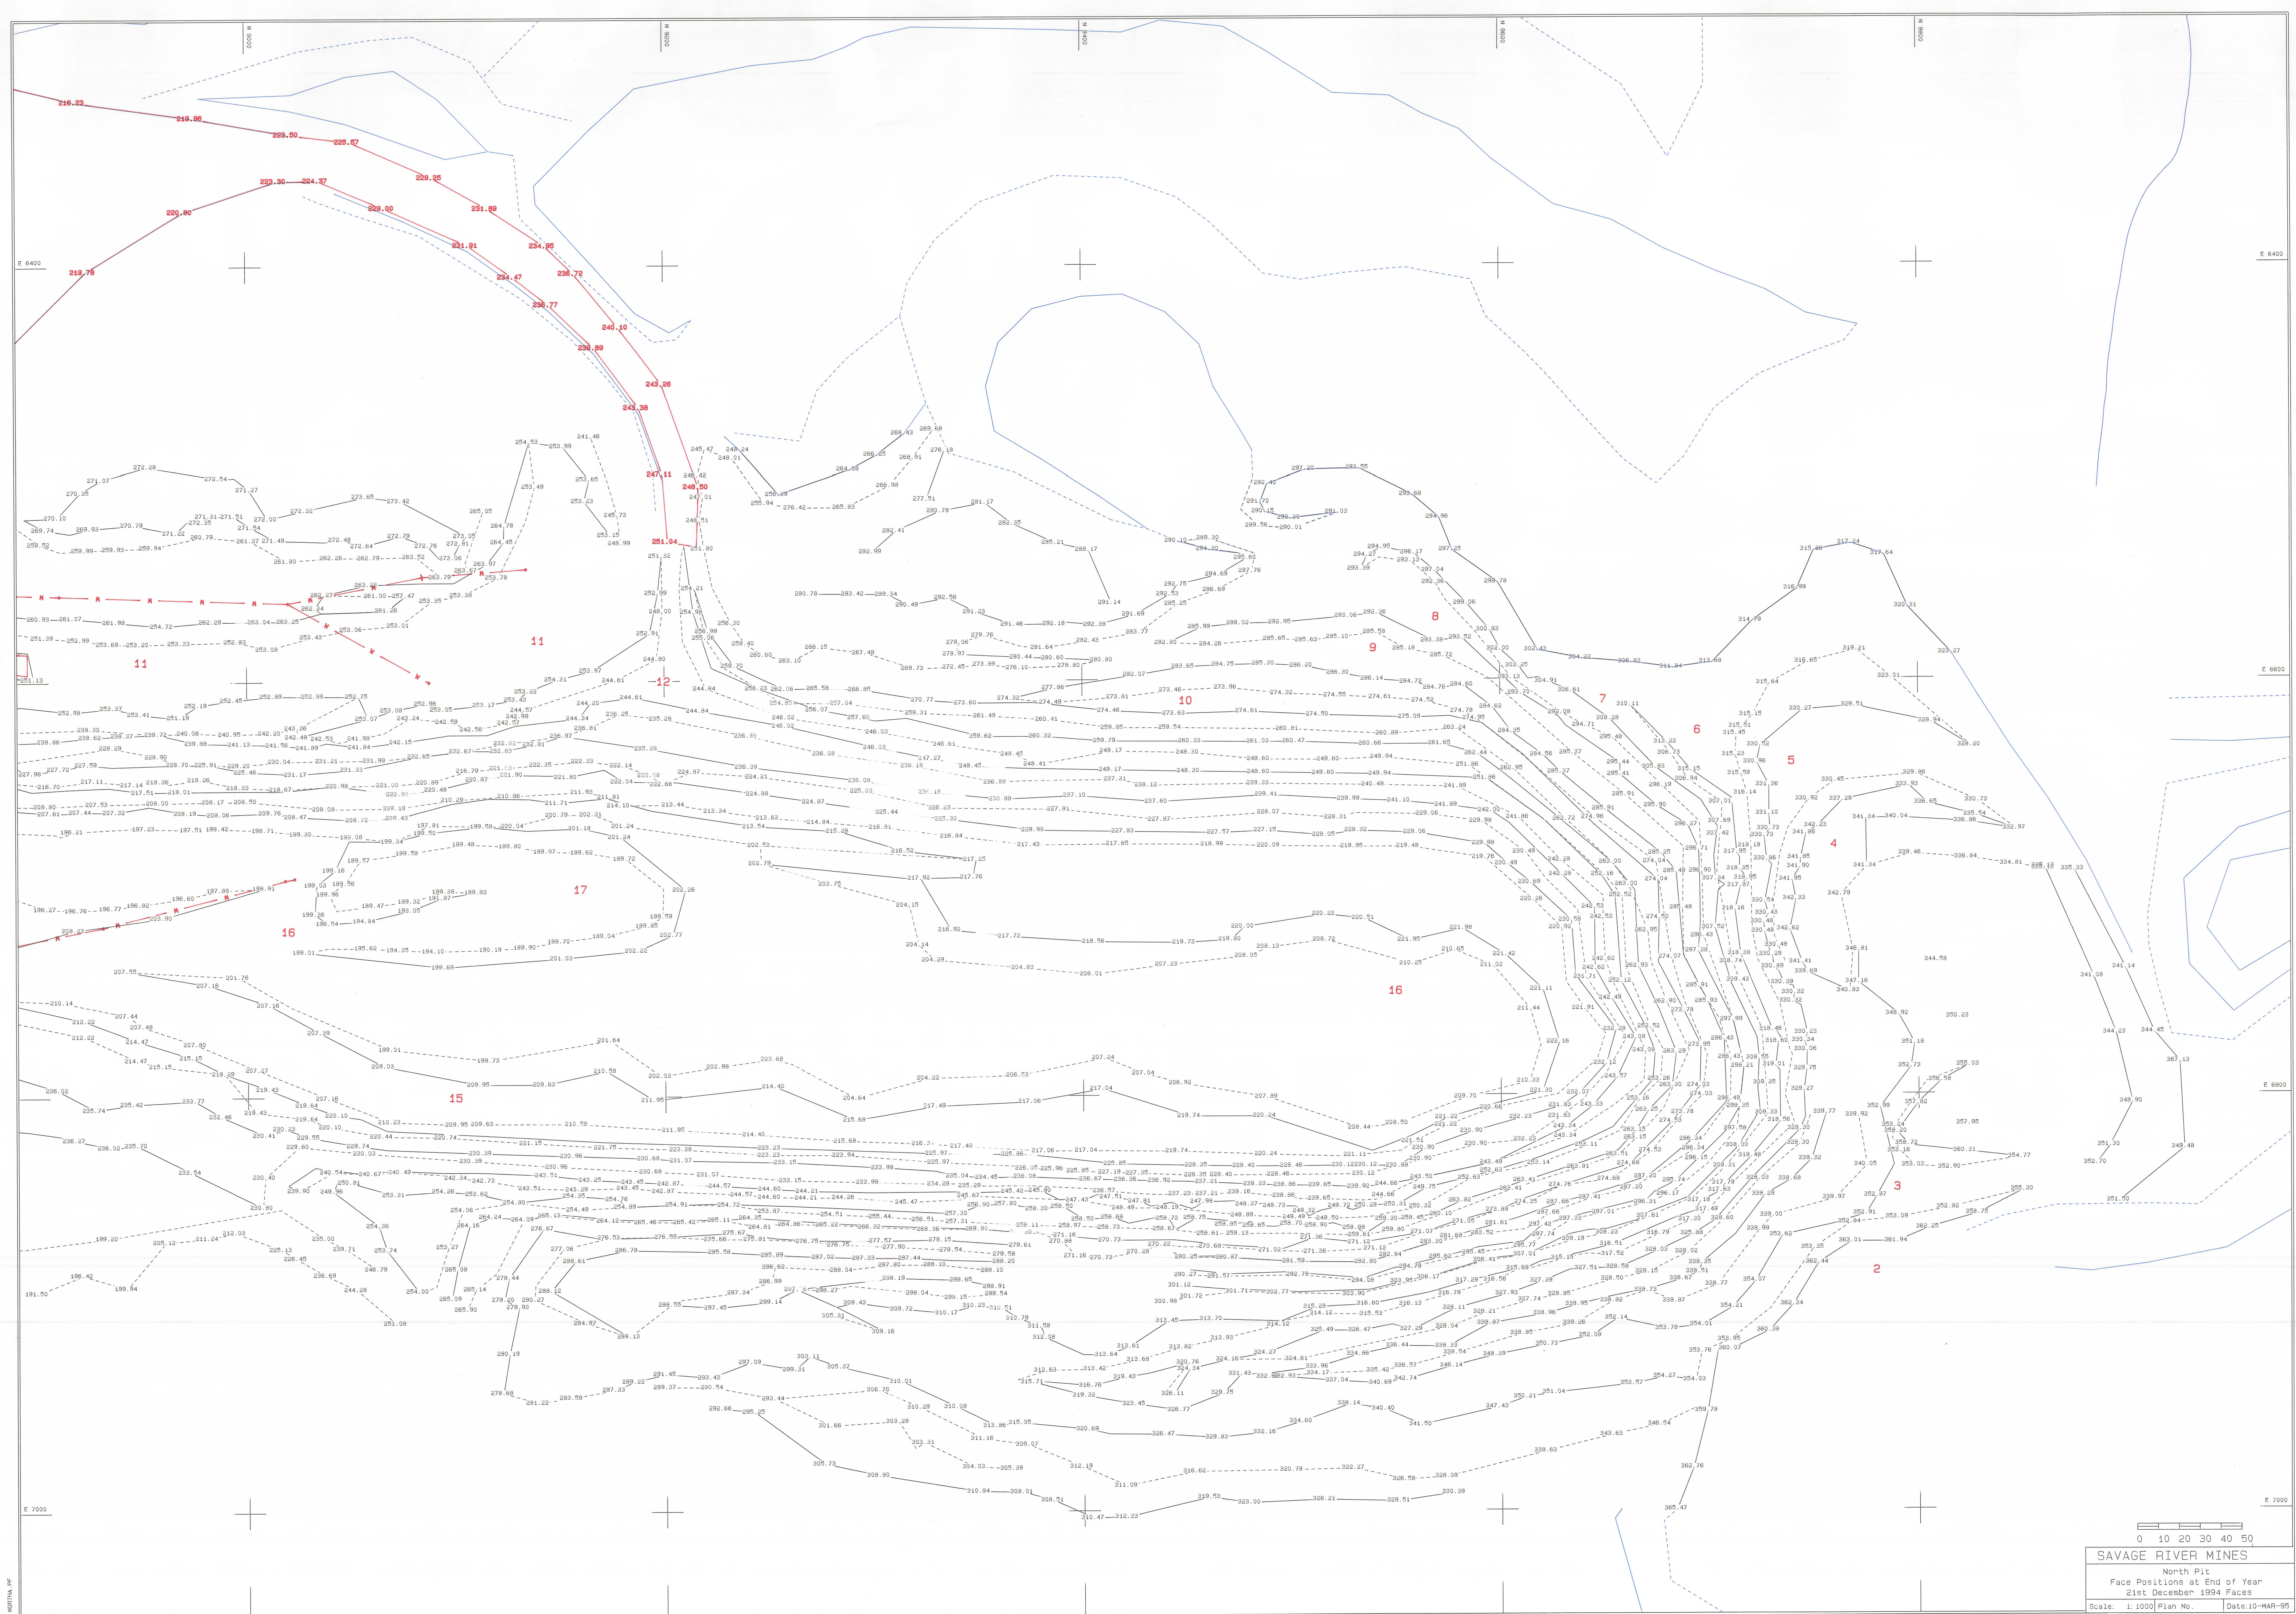

SAVAGE RIVER MINES
North Pit
Face Positions at End of Year
21st December 1994 Faces
Scale: 1:1000 Plan No. Date: 10-MAR-95

0400 - 039

0400 - 039