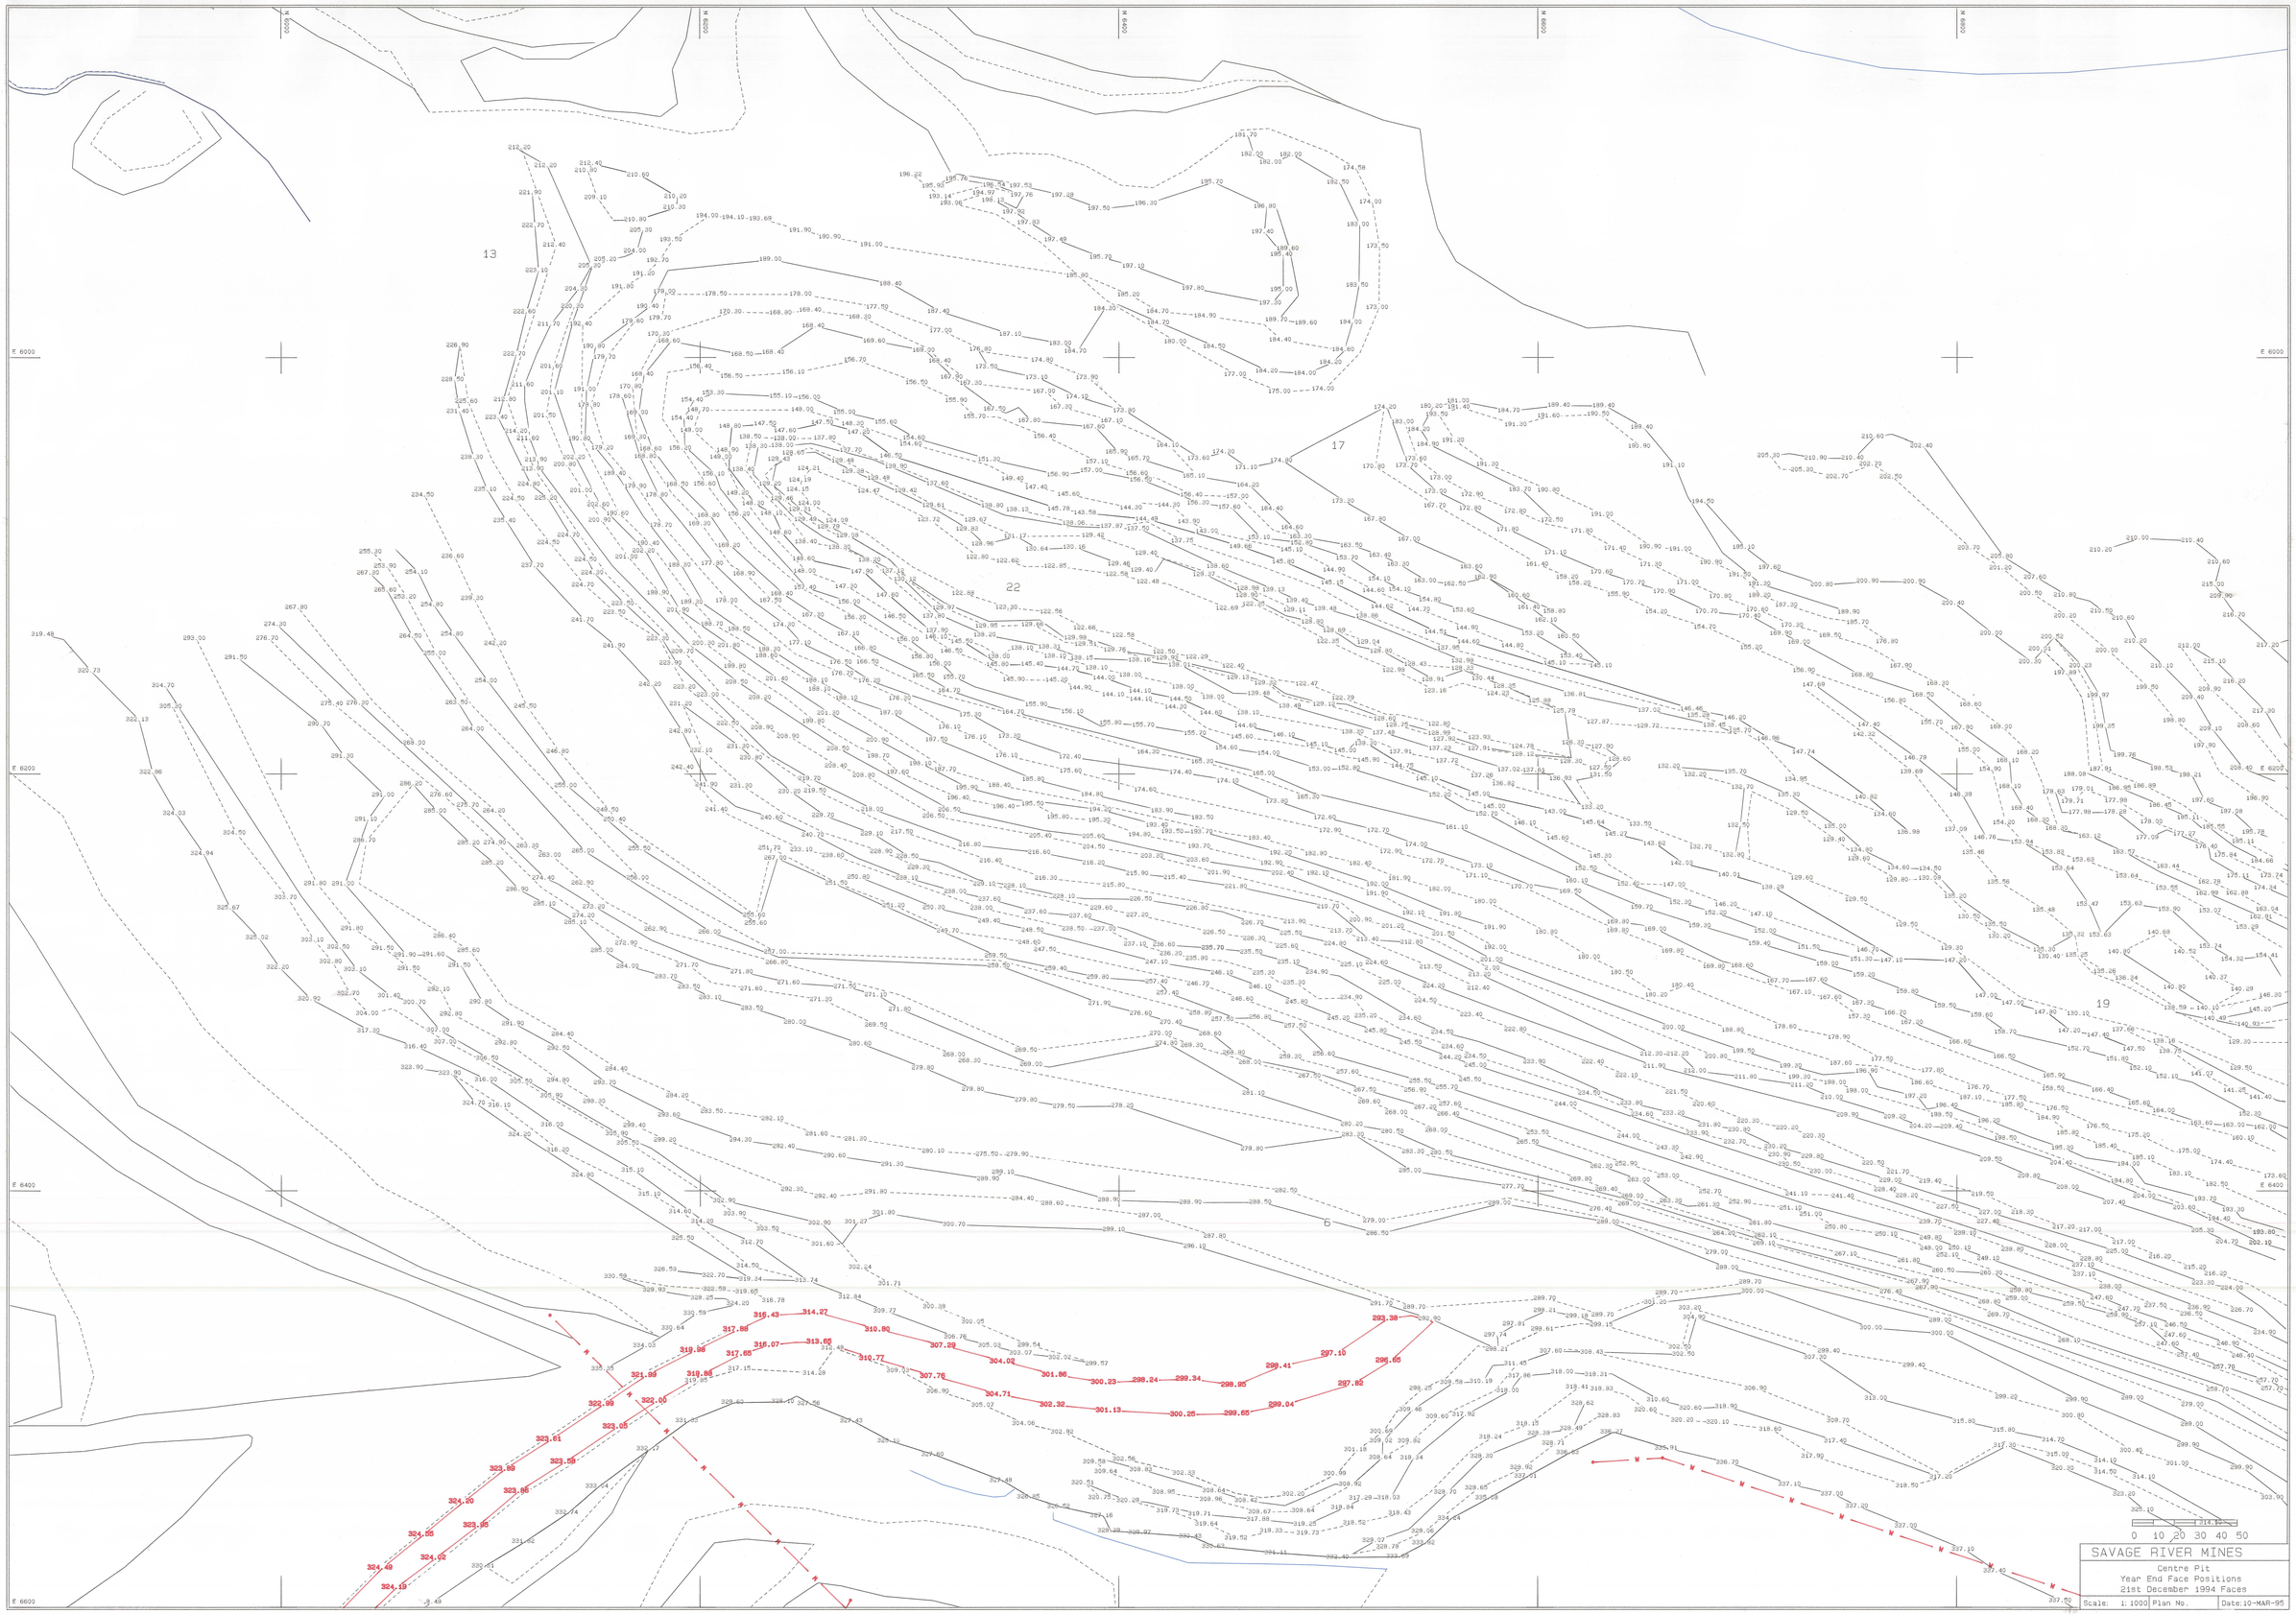

0400 - 042

CENTRE.DF

© SURPAC SOFTWARE INTERNATIONAL, AUSTRALIA

5cm

0400 - 042