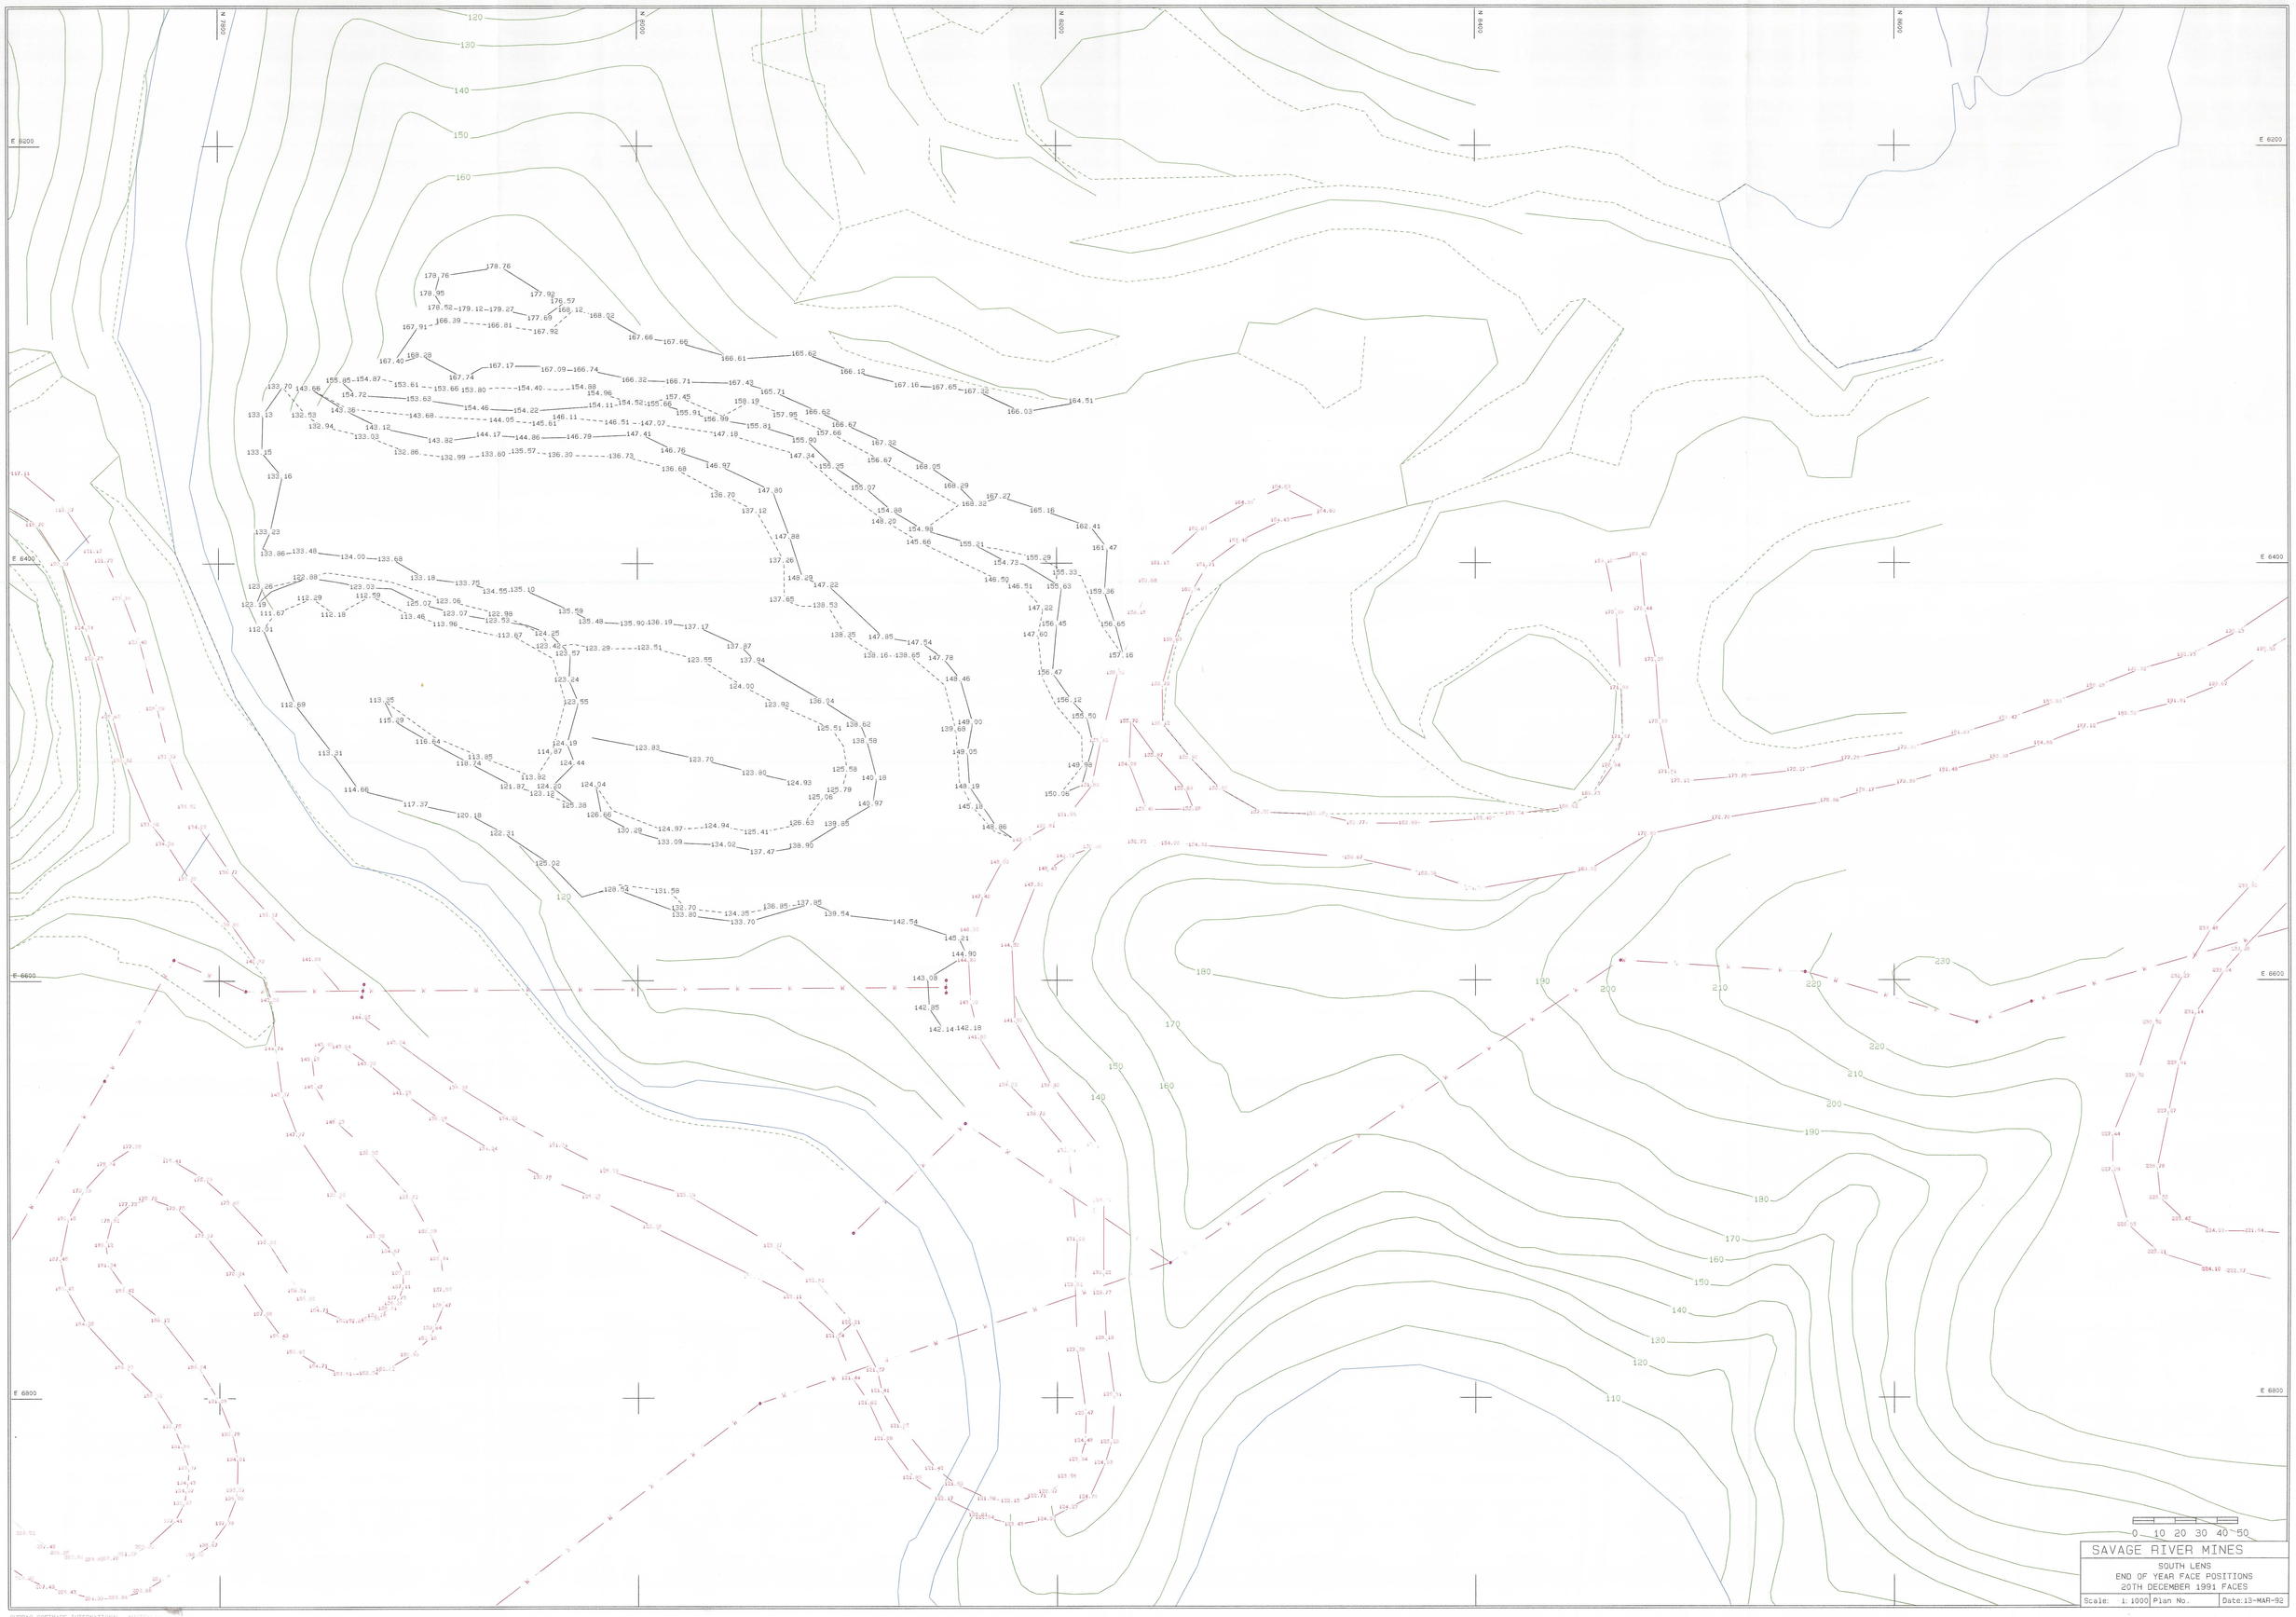

SURPAC SOFTWARE INTERNATIONAL

04 of 07