


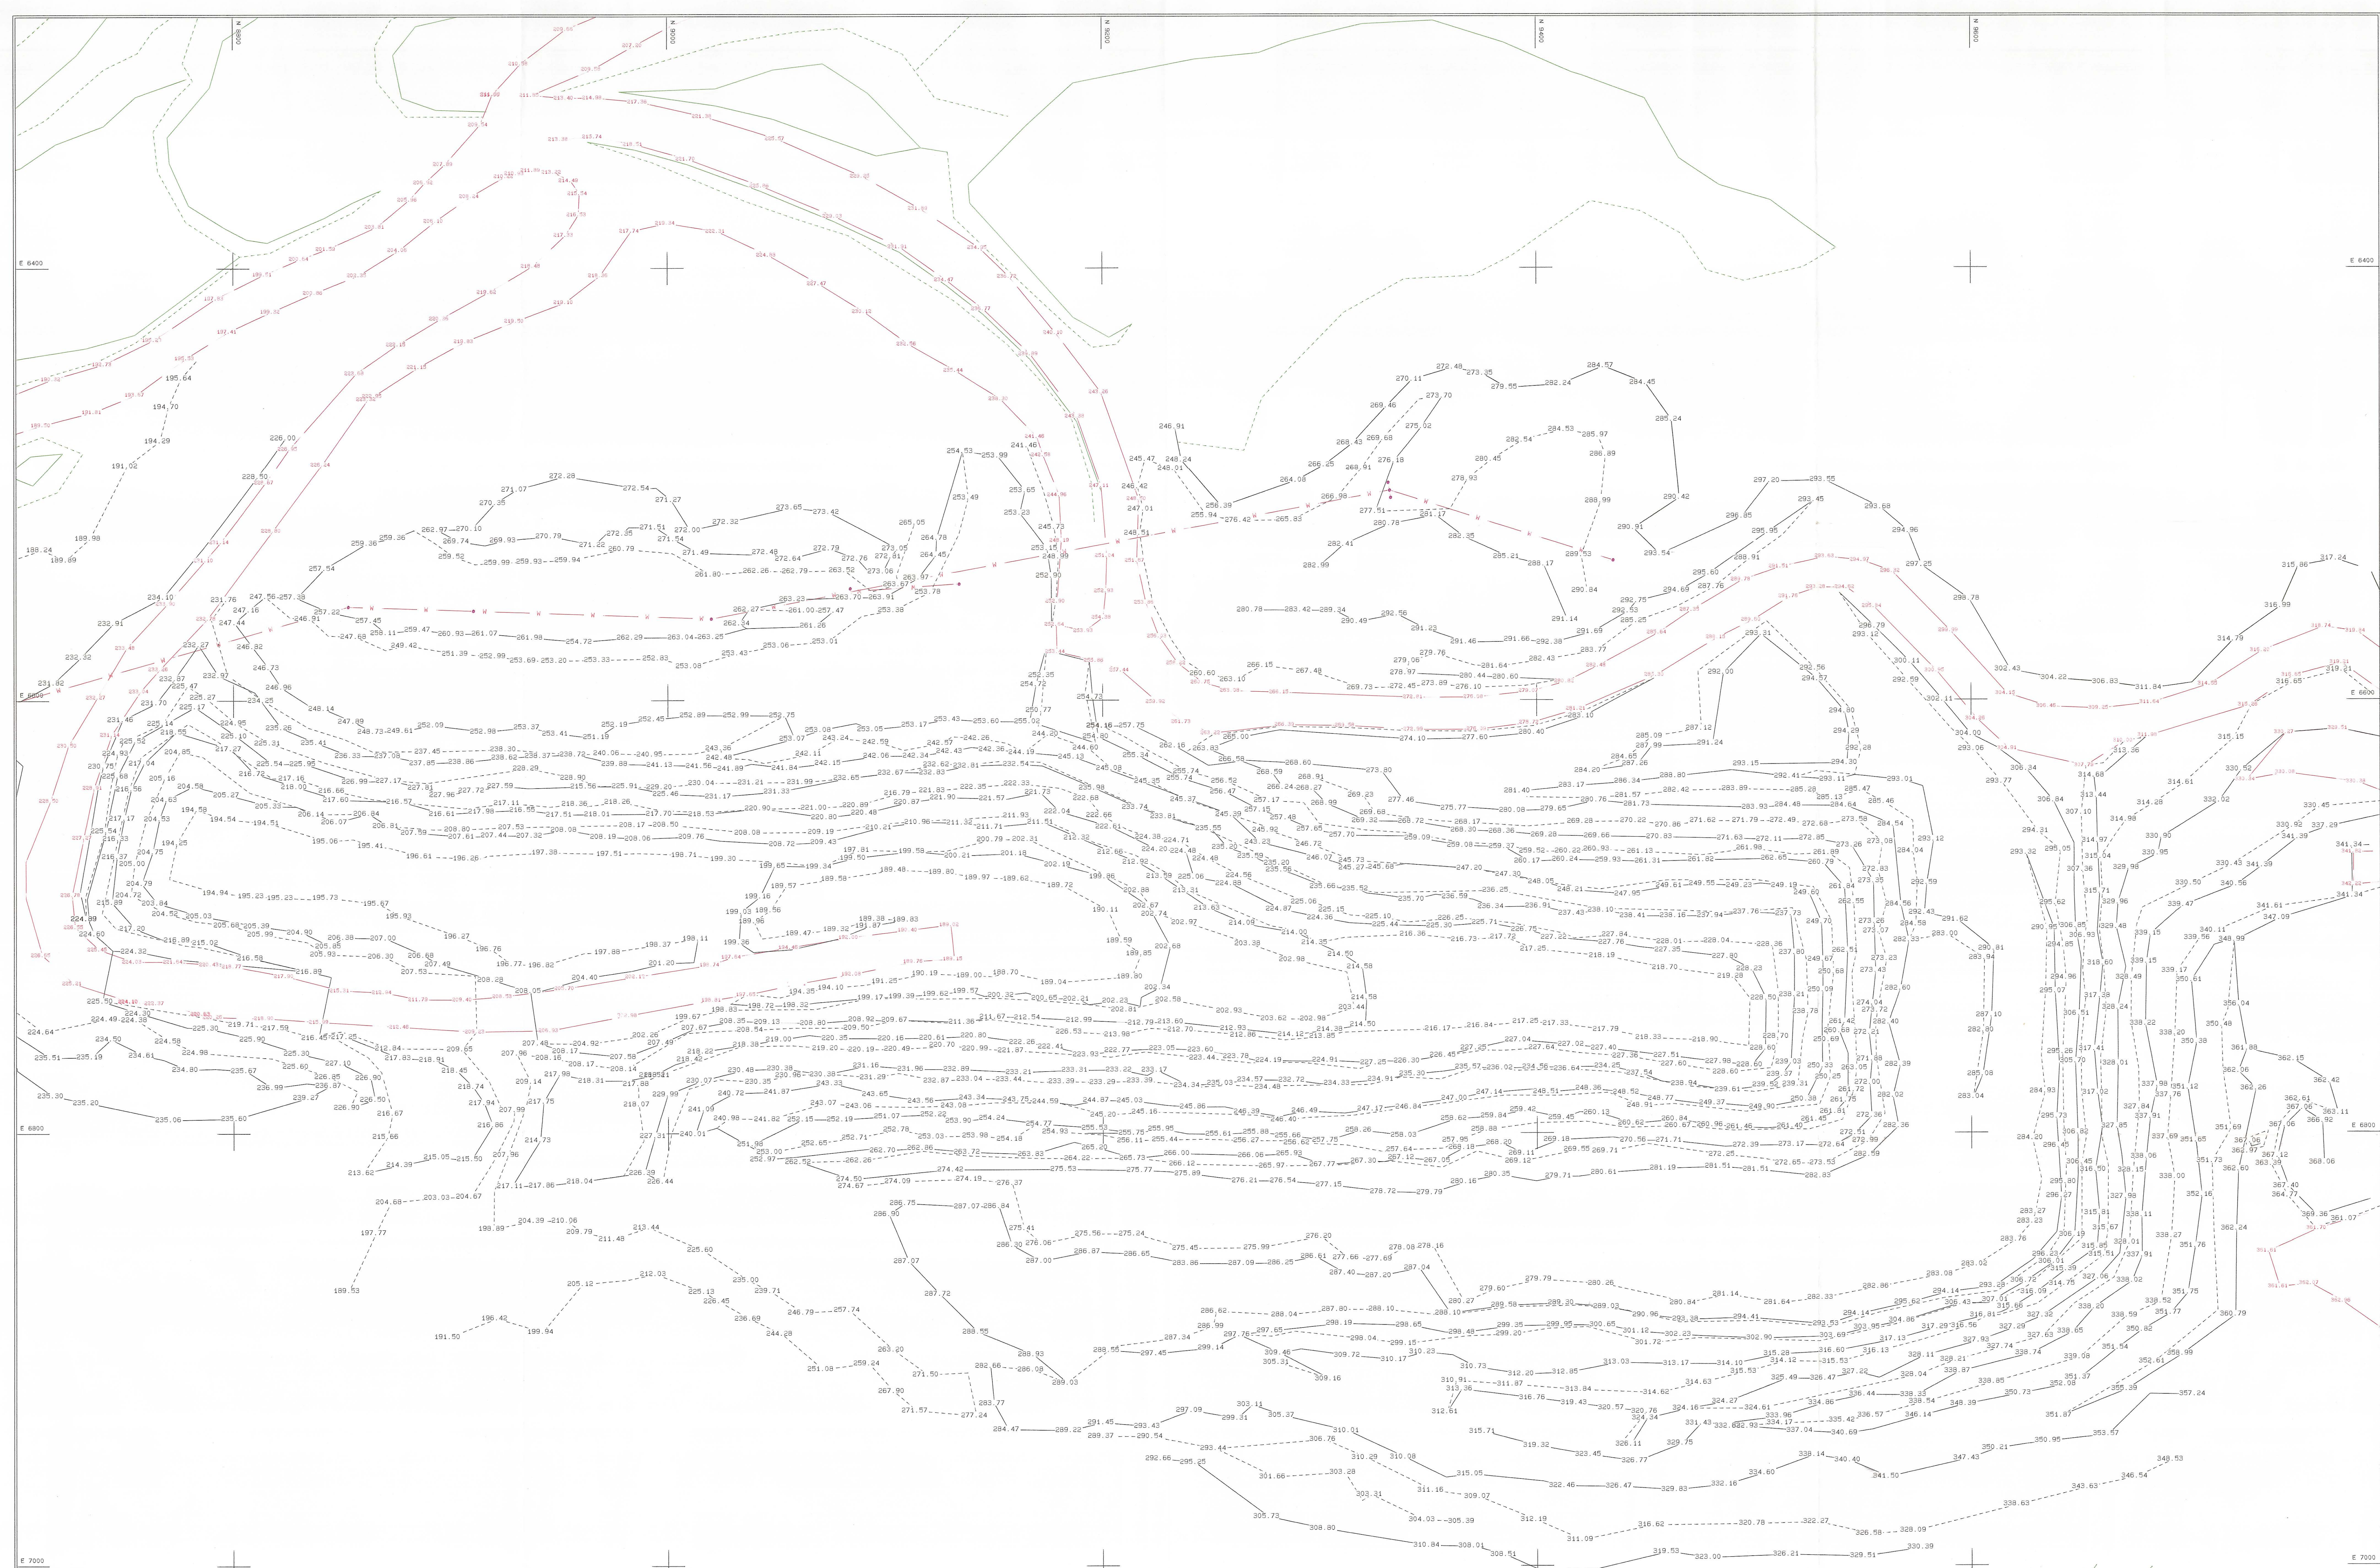

0 10 20 30 40 50

SAVAGE RIVER MINES

NORTH PIT

END OF YEAR FACE POSITIONS
20TH DECEMBER 1991

Scale: 1:1000 Plan No. Date: 13-MAR-92