3327

REVISIONS	

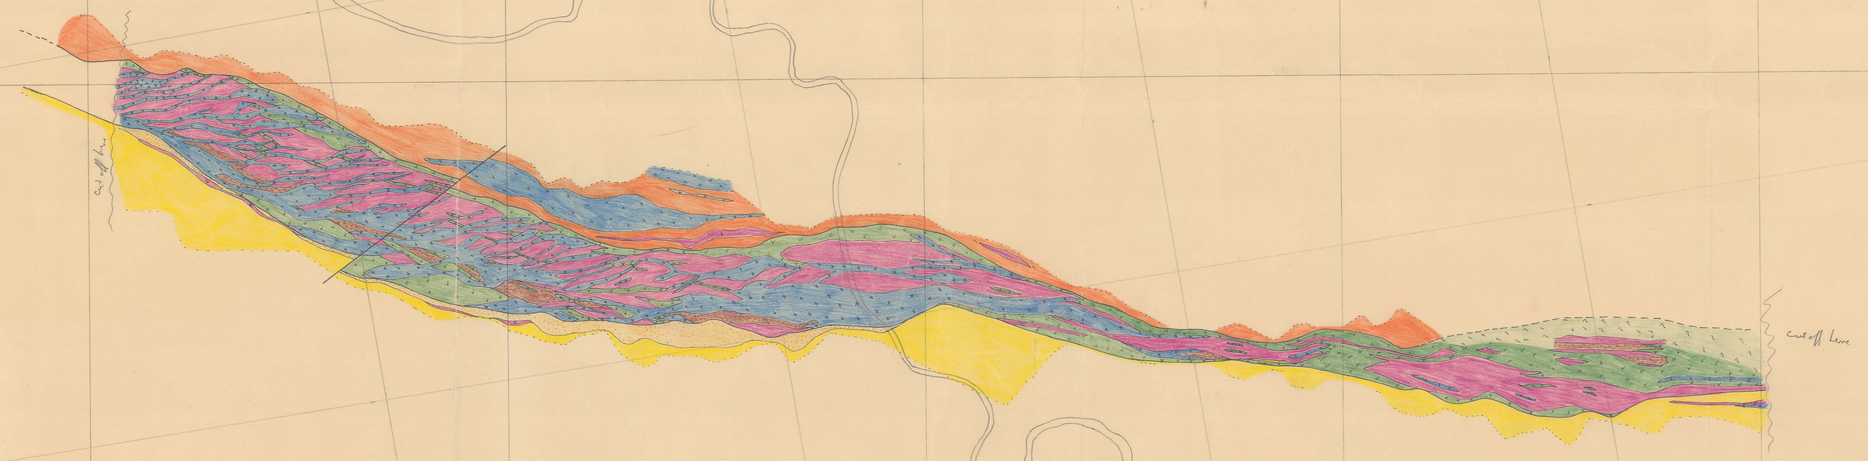

Number rings + AMG coordinates

EXPANDED LEGEND

- INTRUSIVE
- VOLCANICS
- SERPENTINE
- INSIDE ENVELOPE ORE – OUTSIDE SCHIST

black

explain

5 cm

LOC'n	ITEM	QTY.	DESCRIPTION	DRG.	STORE CODE

TOLERANCES UNLESS OTHERWISE STATED			
LINEAR DIMENSION	LINEAR TOLERANCE	ANGULAR DIMENSION	ANGULAR TOLERANCE
0	± 1.5	0°	± 0.5°
0.0	± 0.25	0.0°	± 0.1°
0.00	± 0.025	0.00°	± 0.01°

THIRD ANGLE PROJECTION

ALL DIMENSIONS ARE IN MILLIMETRES UNLESS OTHERWISE STATED

DATE 14/12/94

DRAWN G.B.S.

APP.

SAVAGE RIVER MINES

PICKANDS MATHER & CO. INTERNATIONAL
MANAGING AGENT
P.O. BOX 353, WYNYARD, TASMANIA, 7325

SAVAGE RIVER MINE SEQUENCE PLAN AT 200m RL

SCALE 1 : 6000

AREA

FILE

DRG. No.

0400 — 054