




MICROFILMED

SAVAGE RIVER MINES	Scale: 1 : 1000
END OF YEAR SURVEY	Drawn: L. Somerville
NORTH DUMP	Date: 2/80
	FILE: V-36-5

0400 - 065

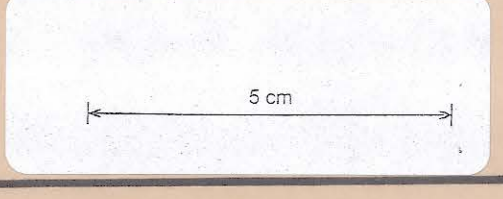

80043

80043