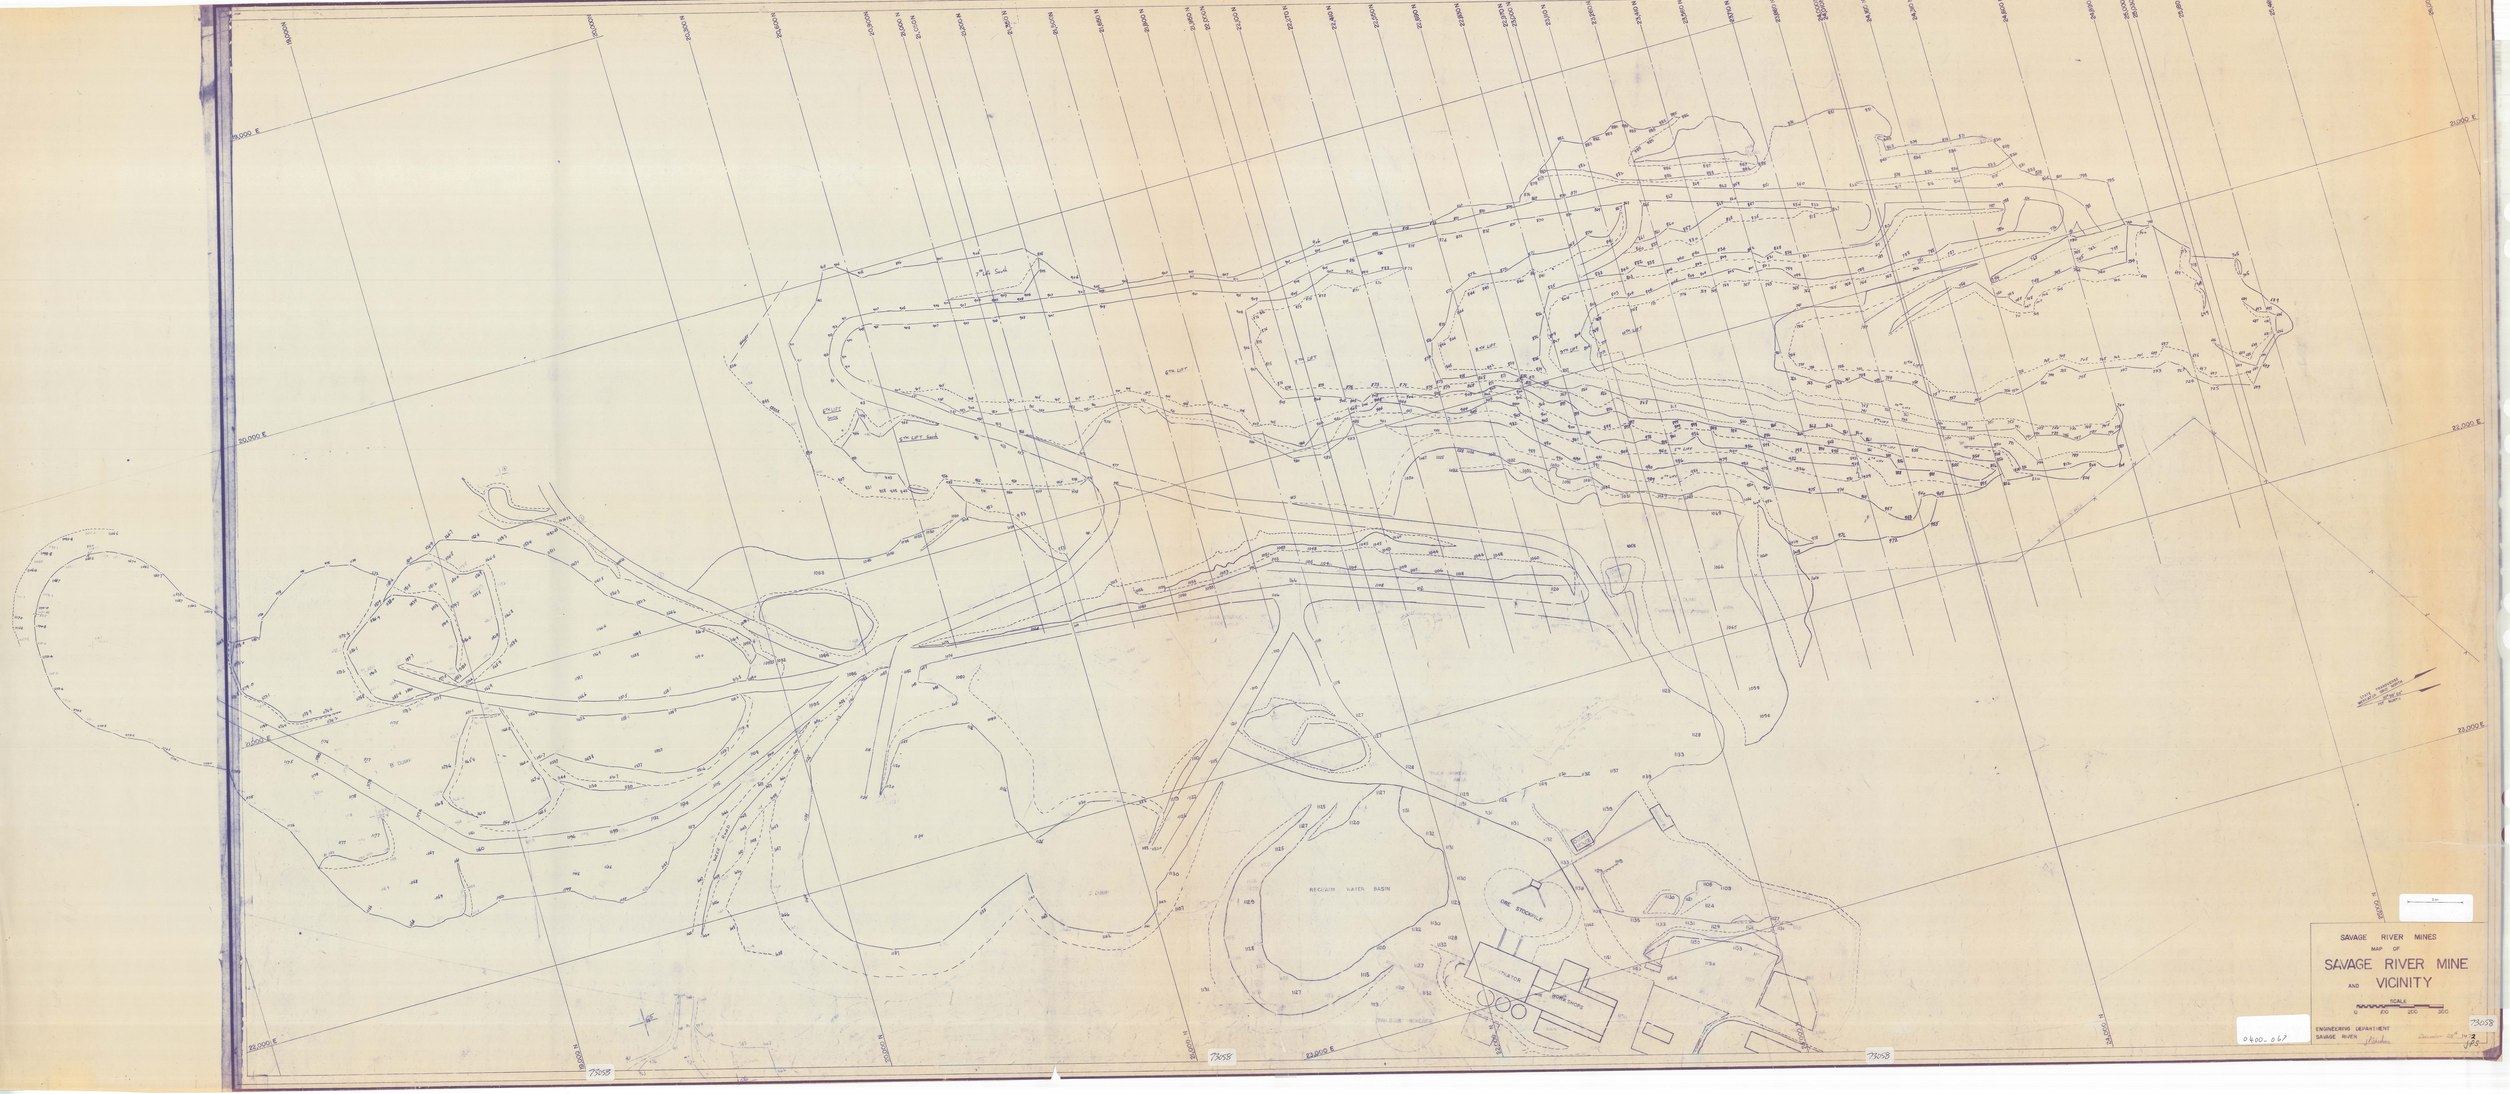
SAVAGE RIVER MINES
MAP OF
SAVAGE RIVER MINE
AND
VICINITY
SCALE
0 100 200 300
ENGINEERING DEPARTMENT
SAVAGE RIVER
0460-067
73058
2
REGRADE WATER BASIN
ORE STOCKPILE
CRUSHER
WORK SHOPS
73058