



SECTION A-A

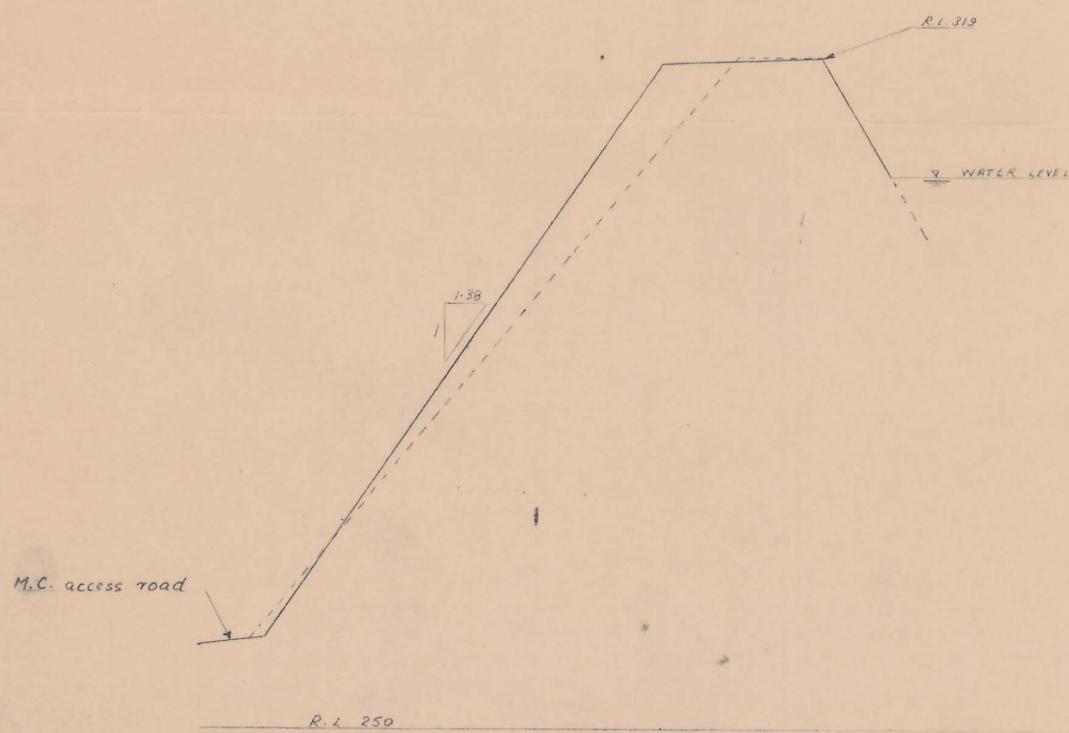

SECTION B-B




SECTION C-C

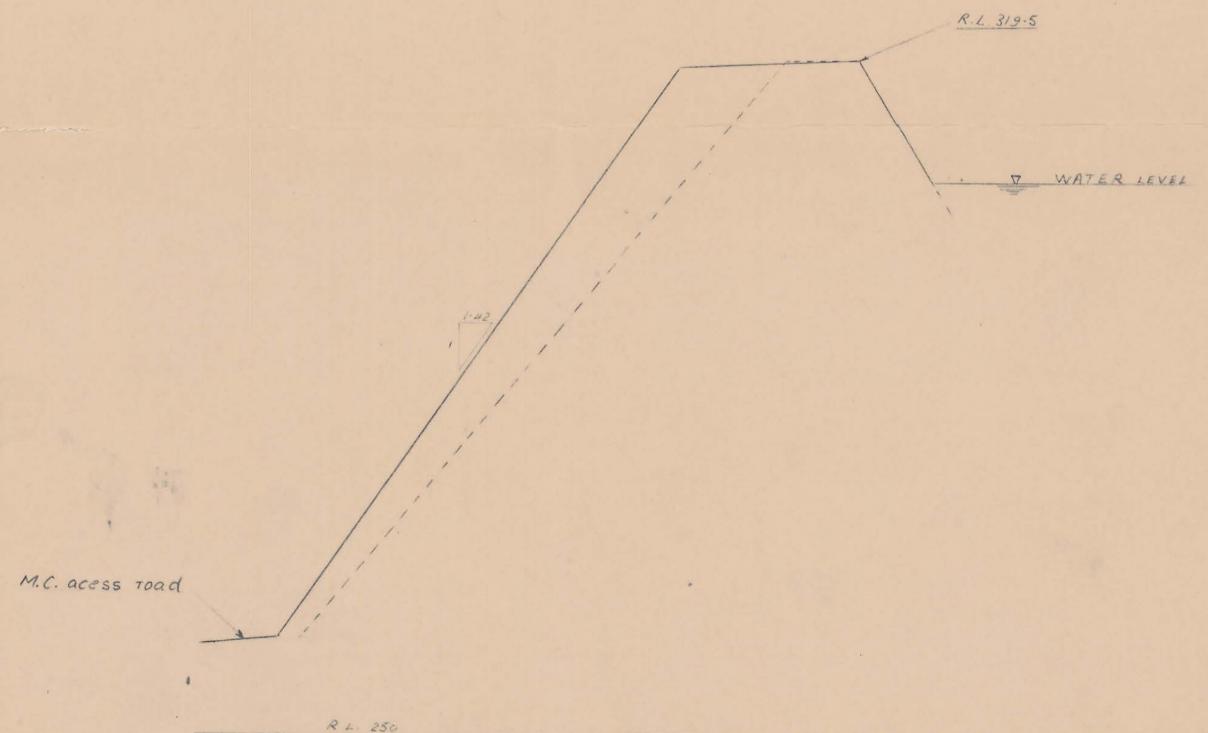

SECTION D-D

Vertical Scale 1:500
Horizontal Scale 1:1000

EMERGENCY TAILINGS DAM
CROSS SECTIONS (For plan see GS-19-02)

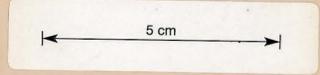

Broken line is design cross section as given by H.F.C.

| | |
|------------------|----------|
| SRM ETD | |
| Drawn: J. HOLMES | |
| DATE: 5-6-80 | GS-19-03 |