


SAVAGE RIVER MINES GENERAL AREA PLAN

SCALE 1:5,000

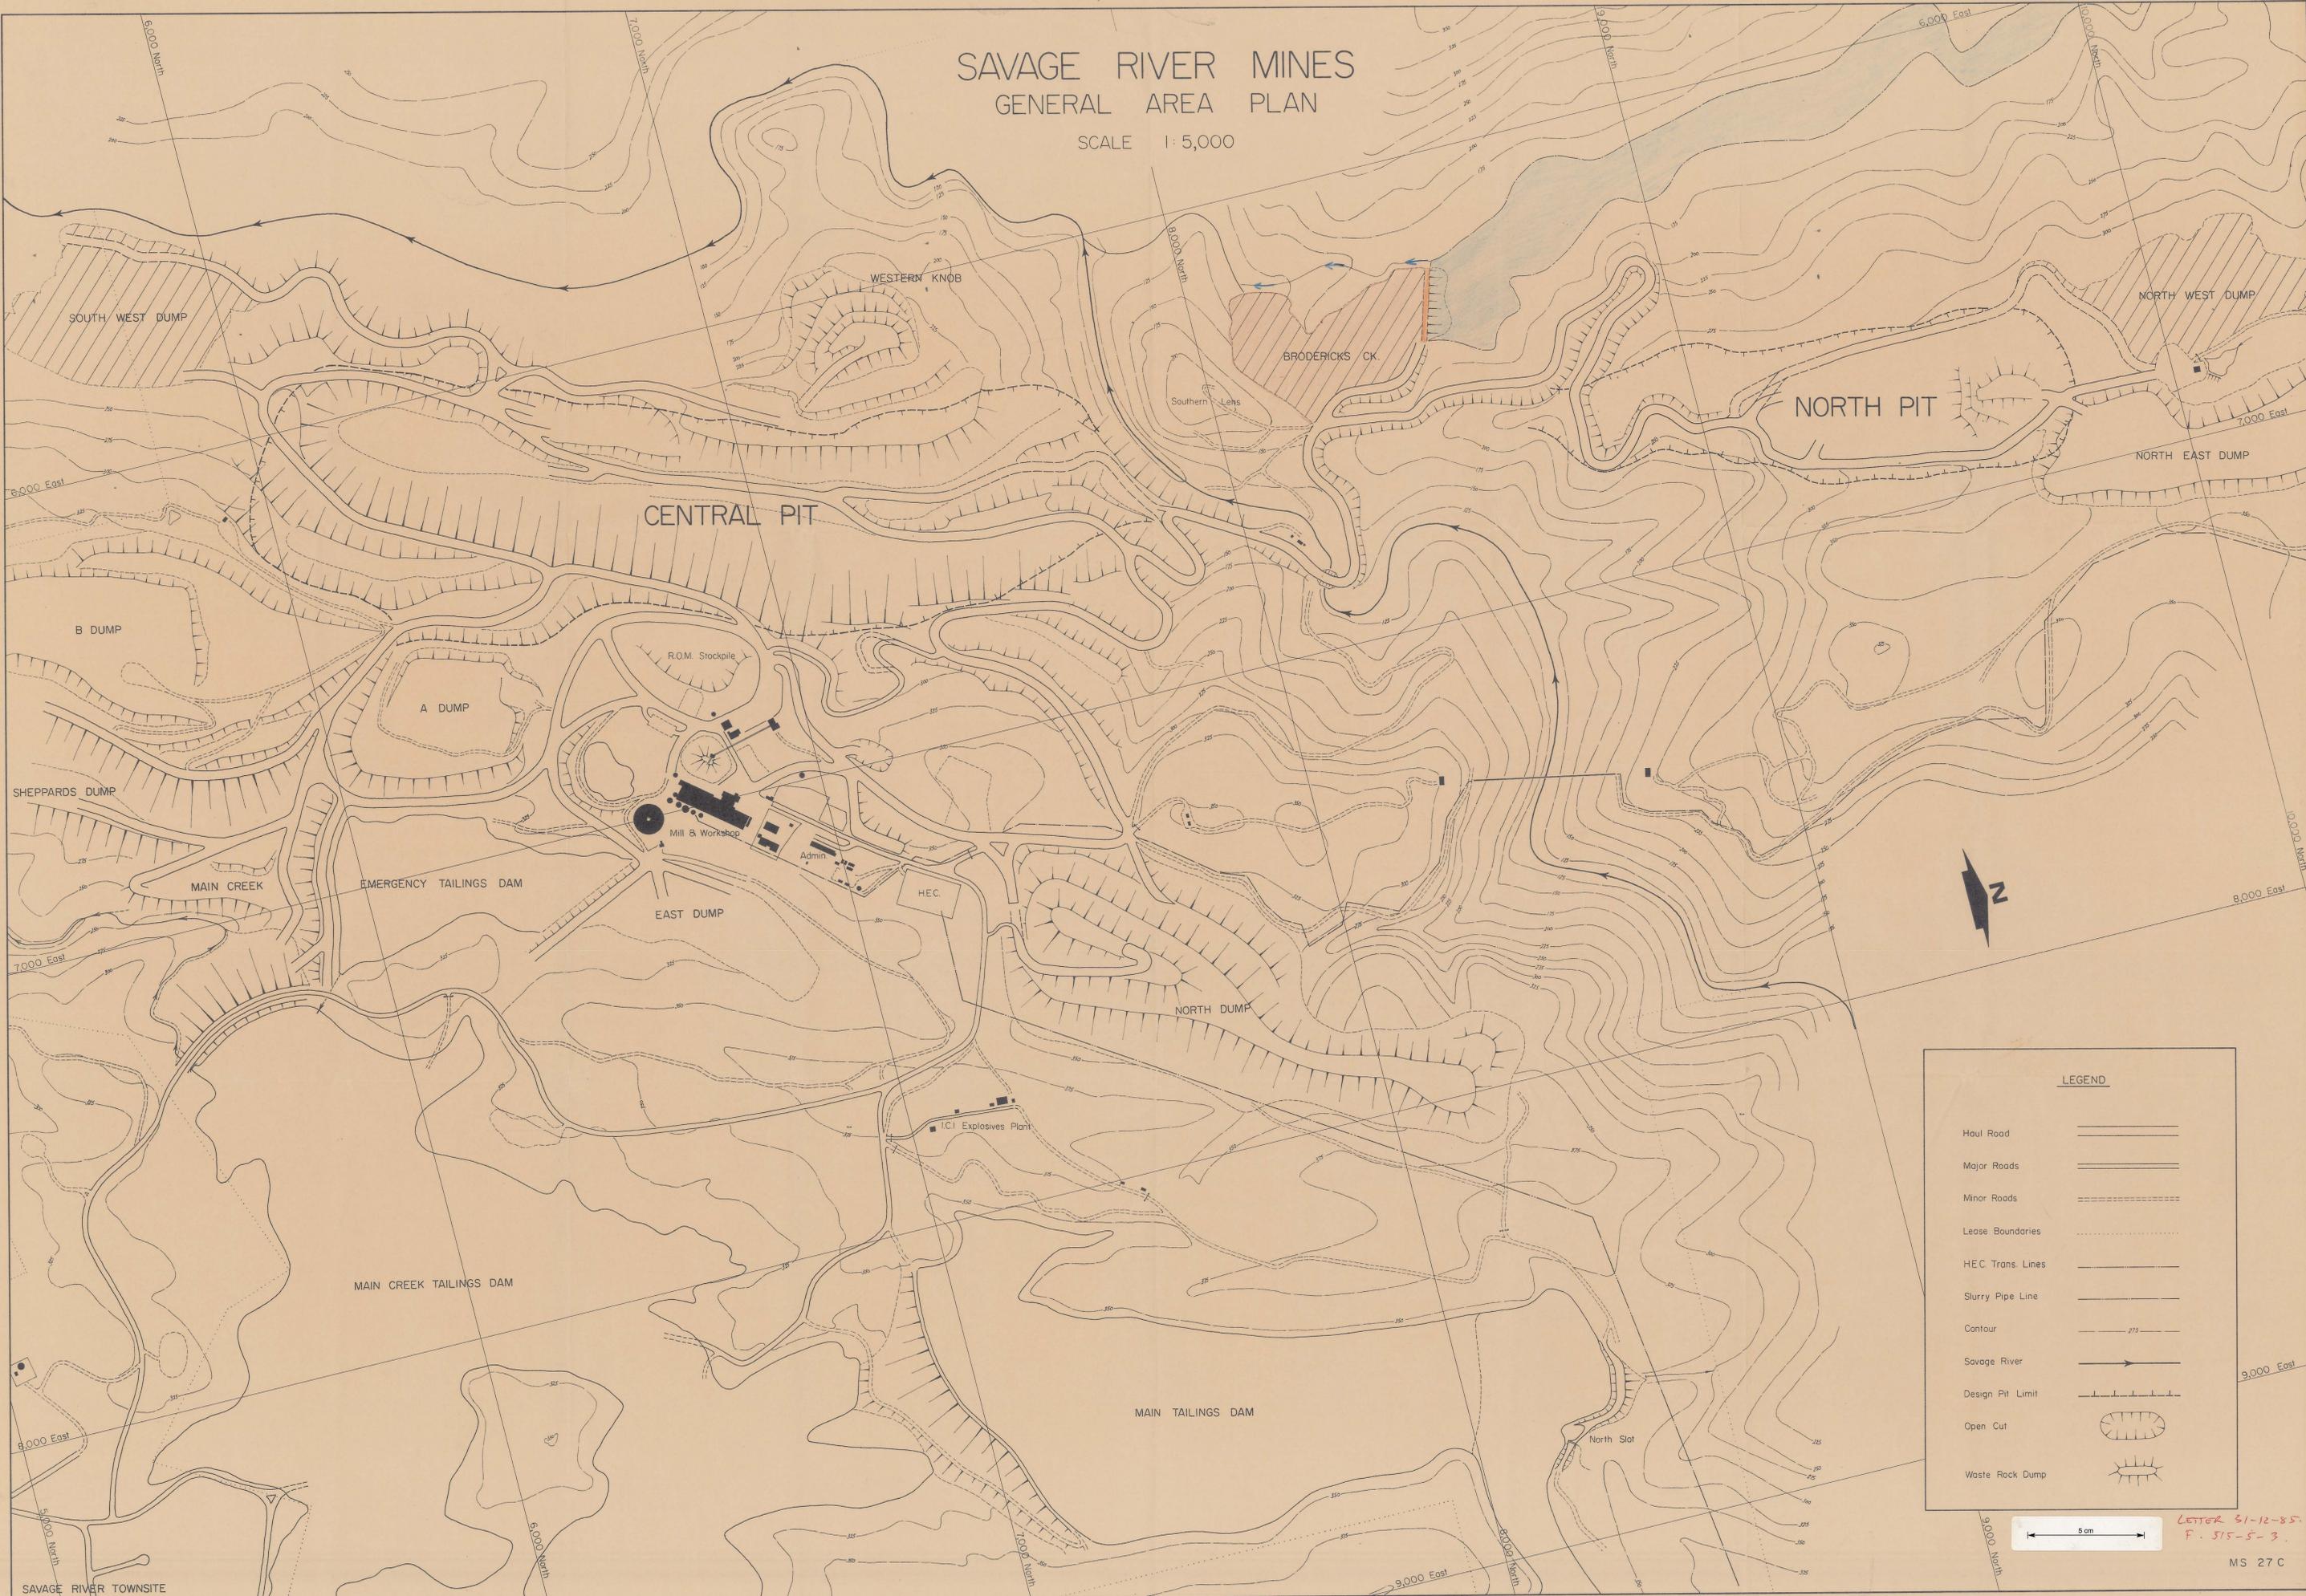

LEGEND	
Haul Road	———
Major Roads	====
Minor Roads	-----
Lease Boundaries
HEC Trans. Lines	———
Slurry Pipe Line	———
Contour	———
Savage River	———>
Design Pit Limit	———
Open Cut	⊖
Waste Rock Dump	⊖

5 cm

LETTER 51-12-85
F. 515-5-3

MS 27 C

0400_120

0006/0048