0401_013

SCOTIA.

LOCATION OF HOLES NOT PREVIOUSLY SURVEYED OR HOLES PLACED IN DIFFERENT POSITIONS AS PER INSTRUCTION DUE TO NATURE OF TERRAIN.

1:3690

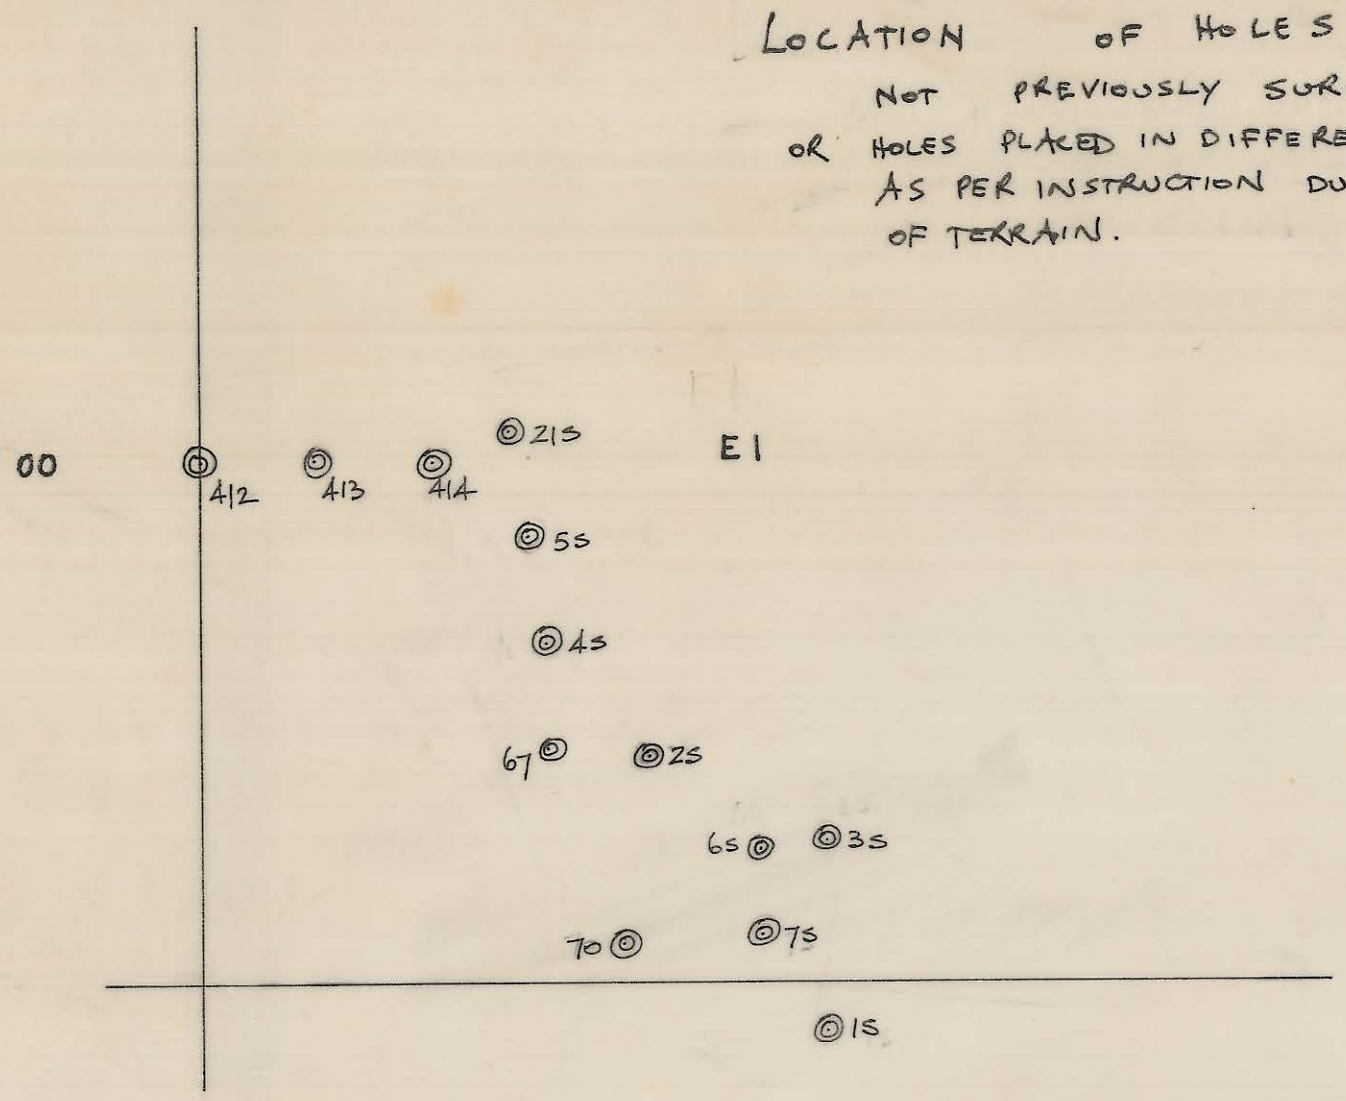

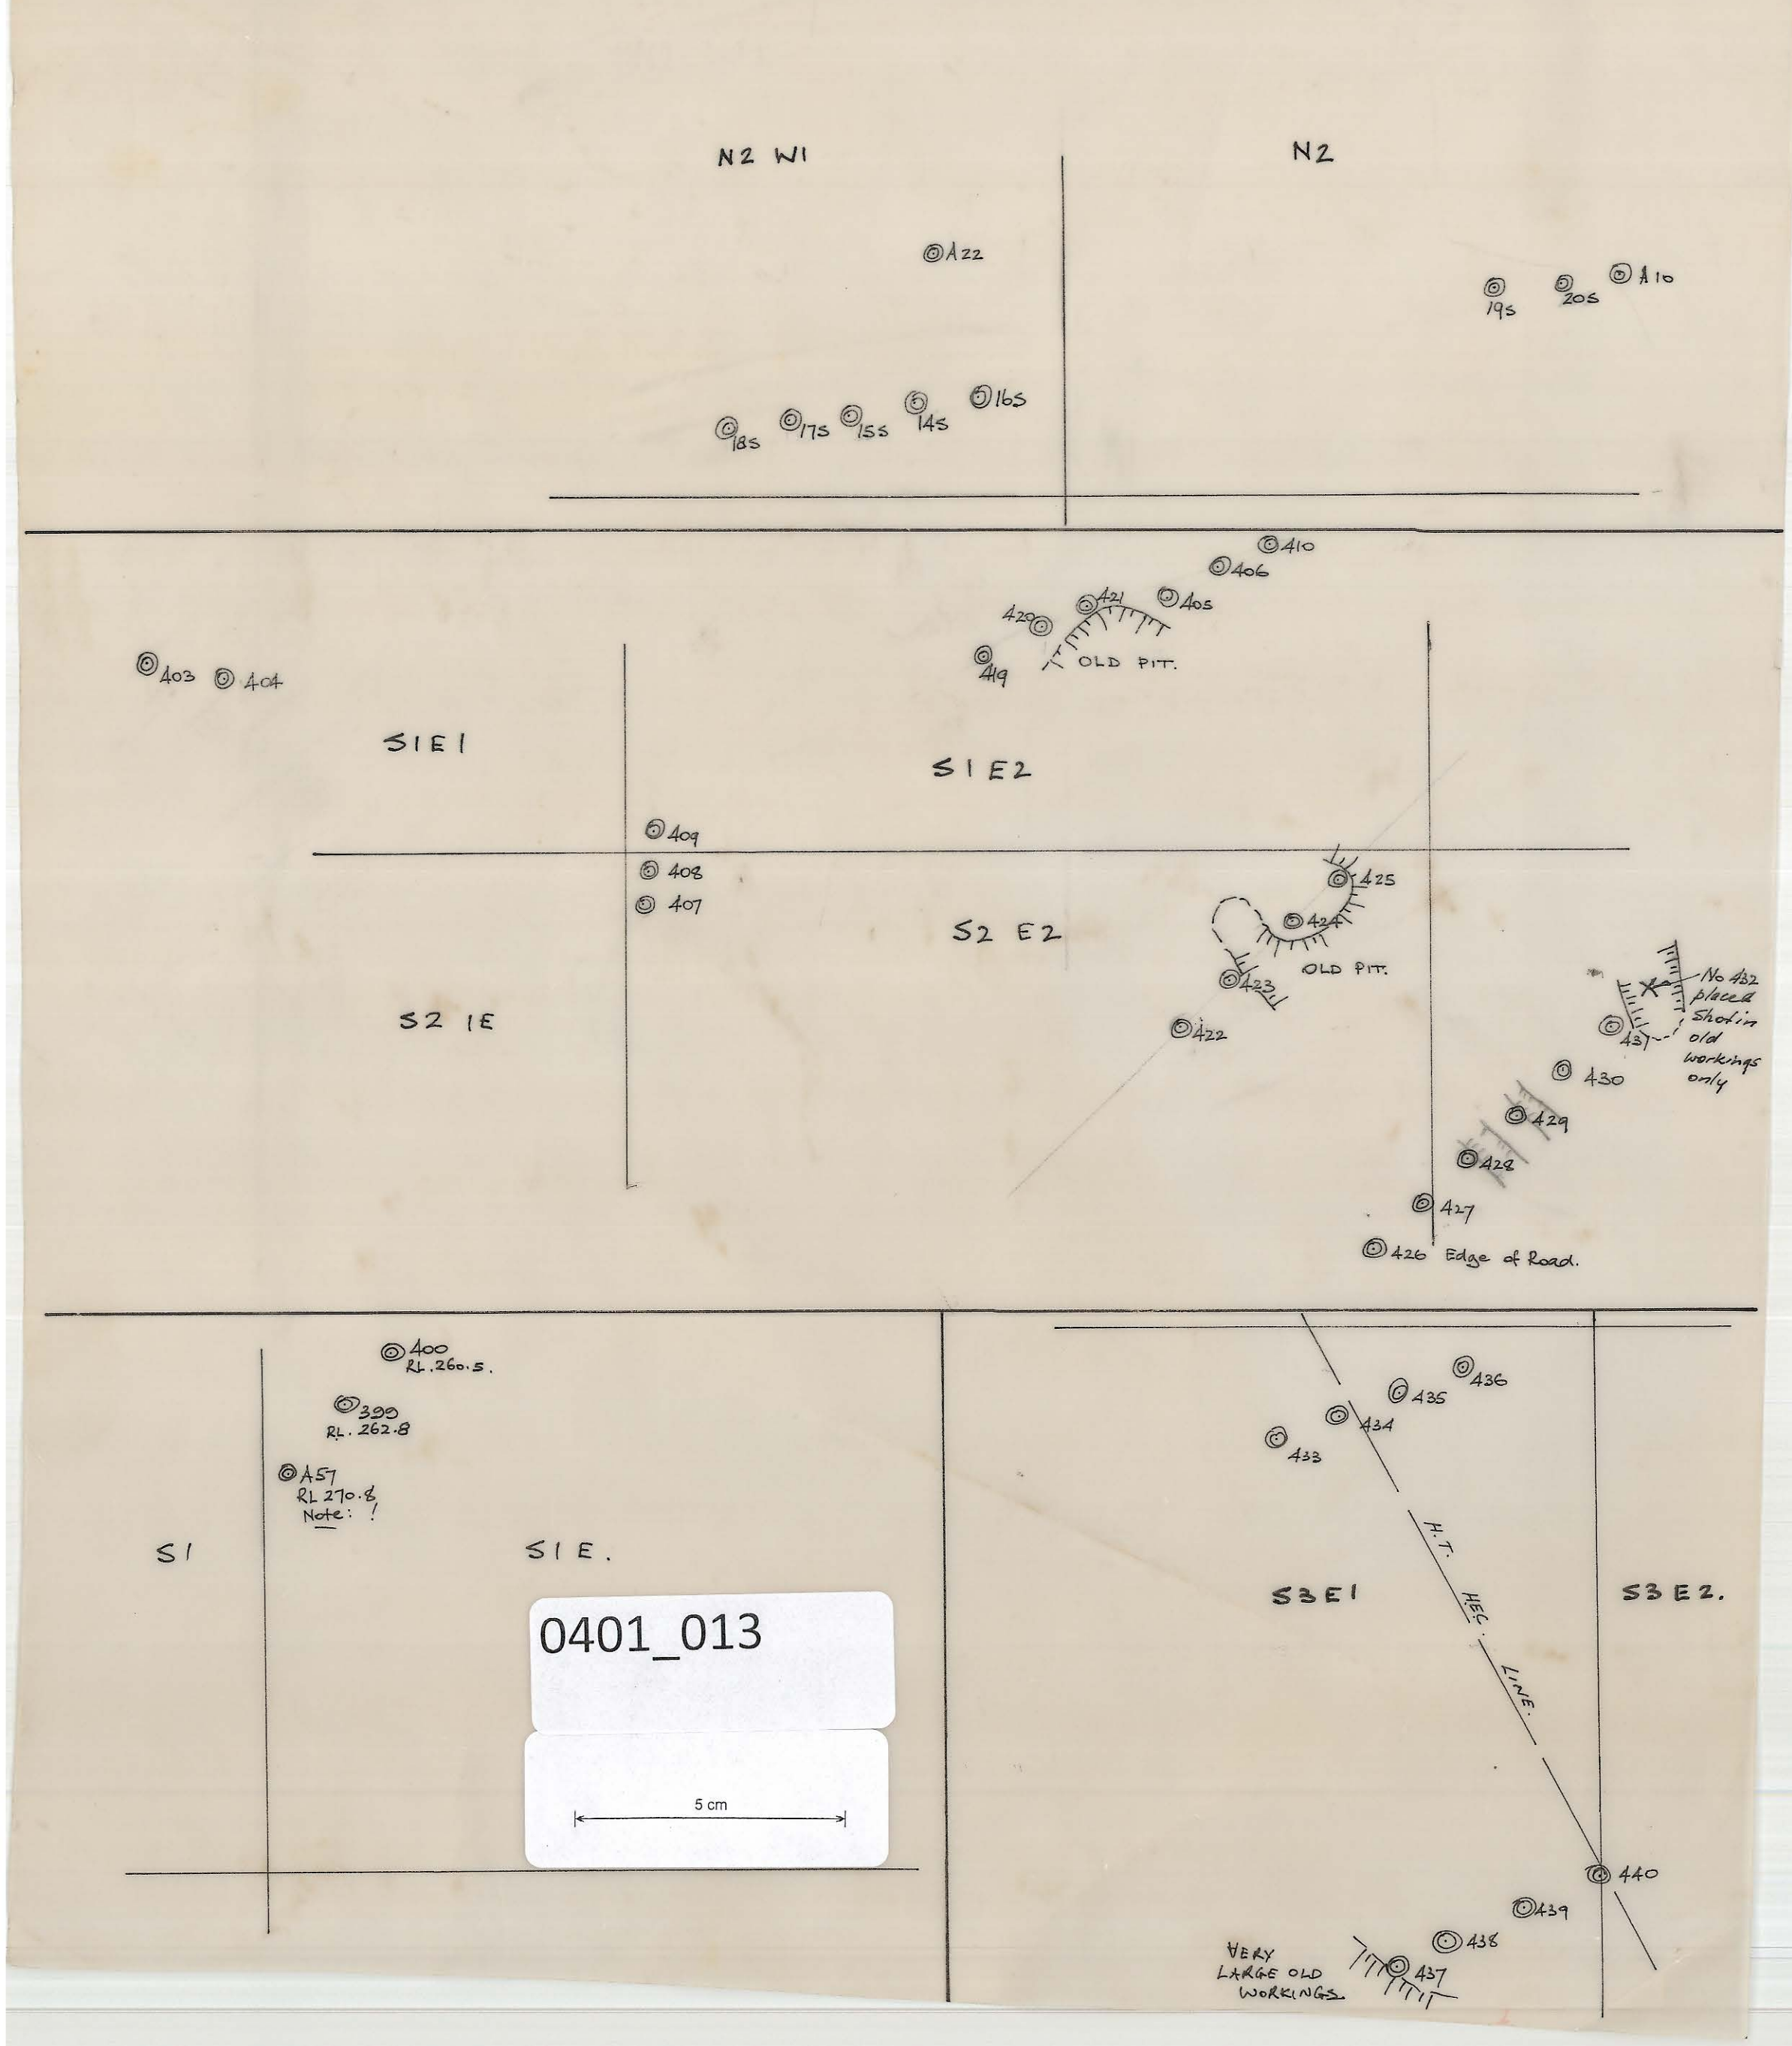

0401_013

5 cm