N1

FIG 11/72

0401_057

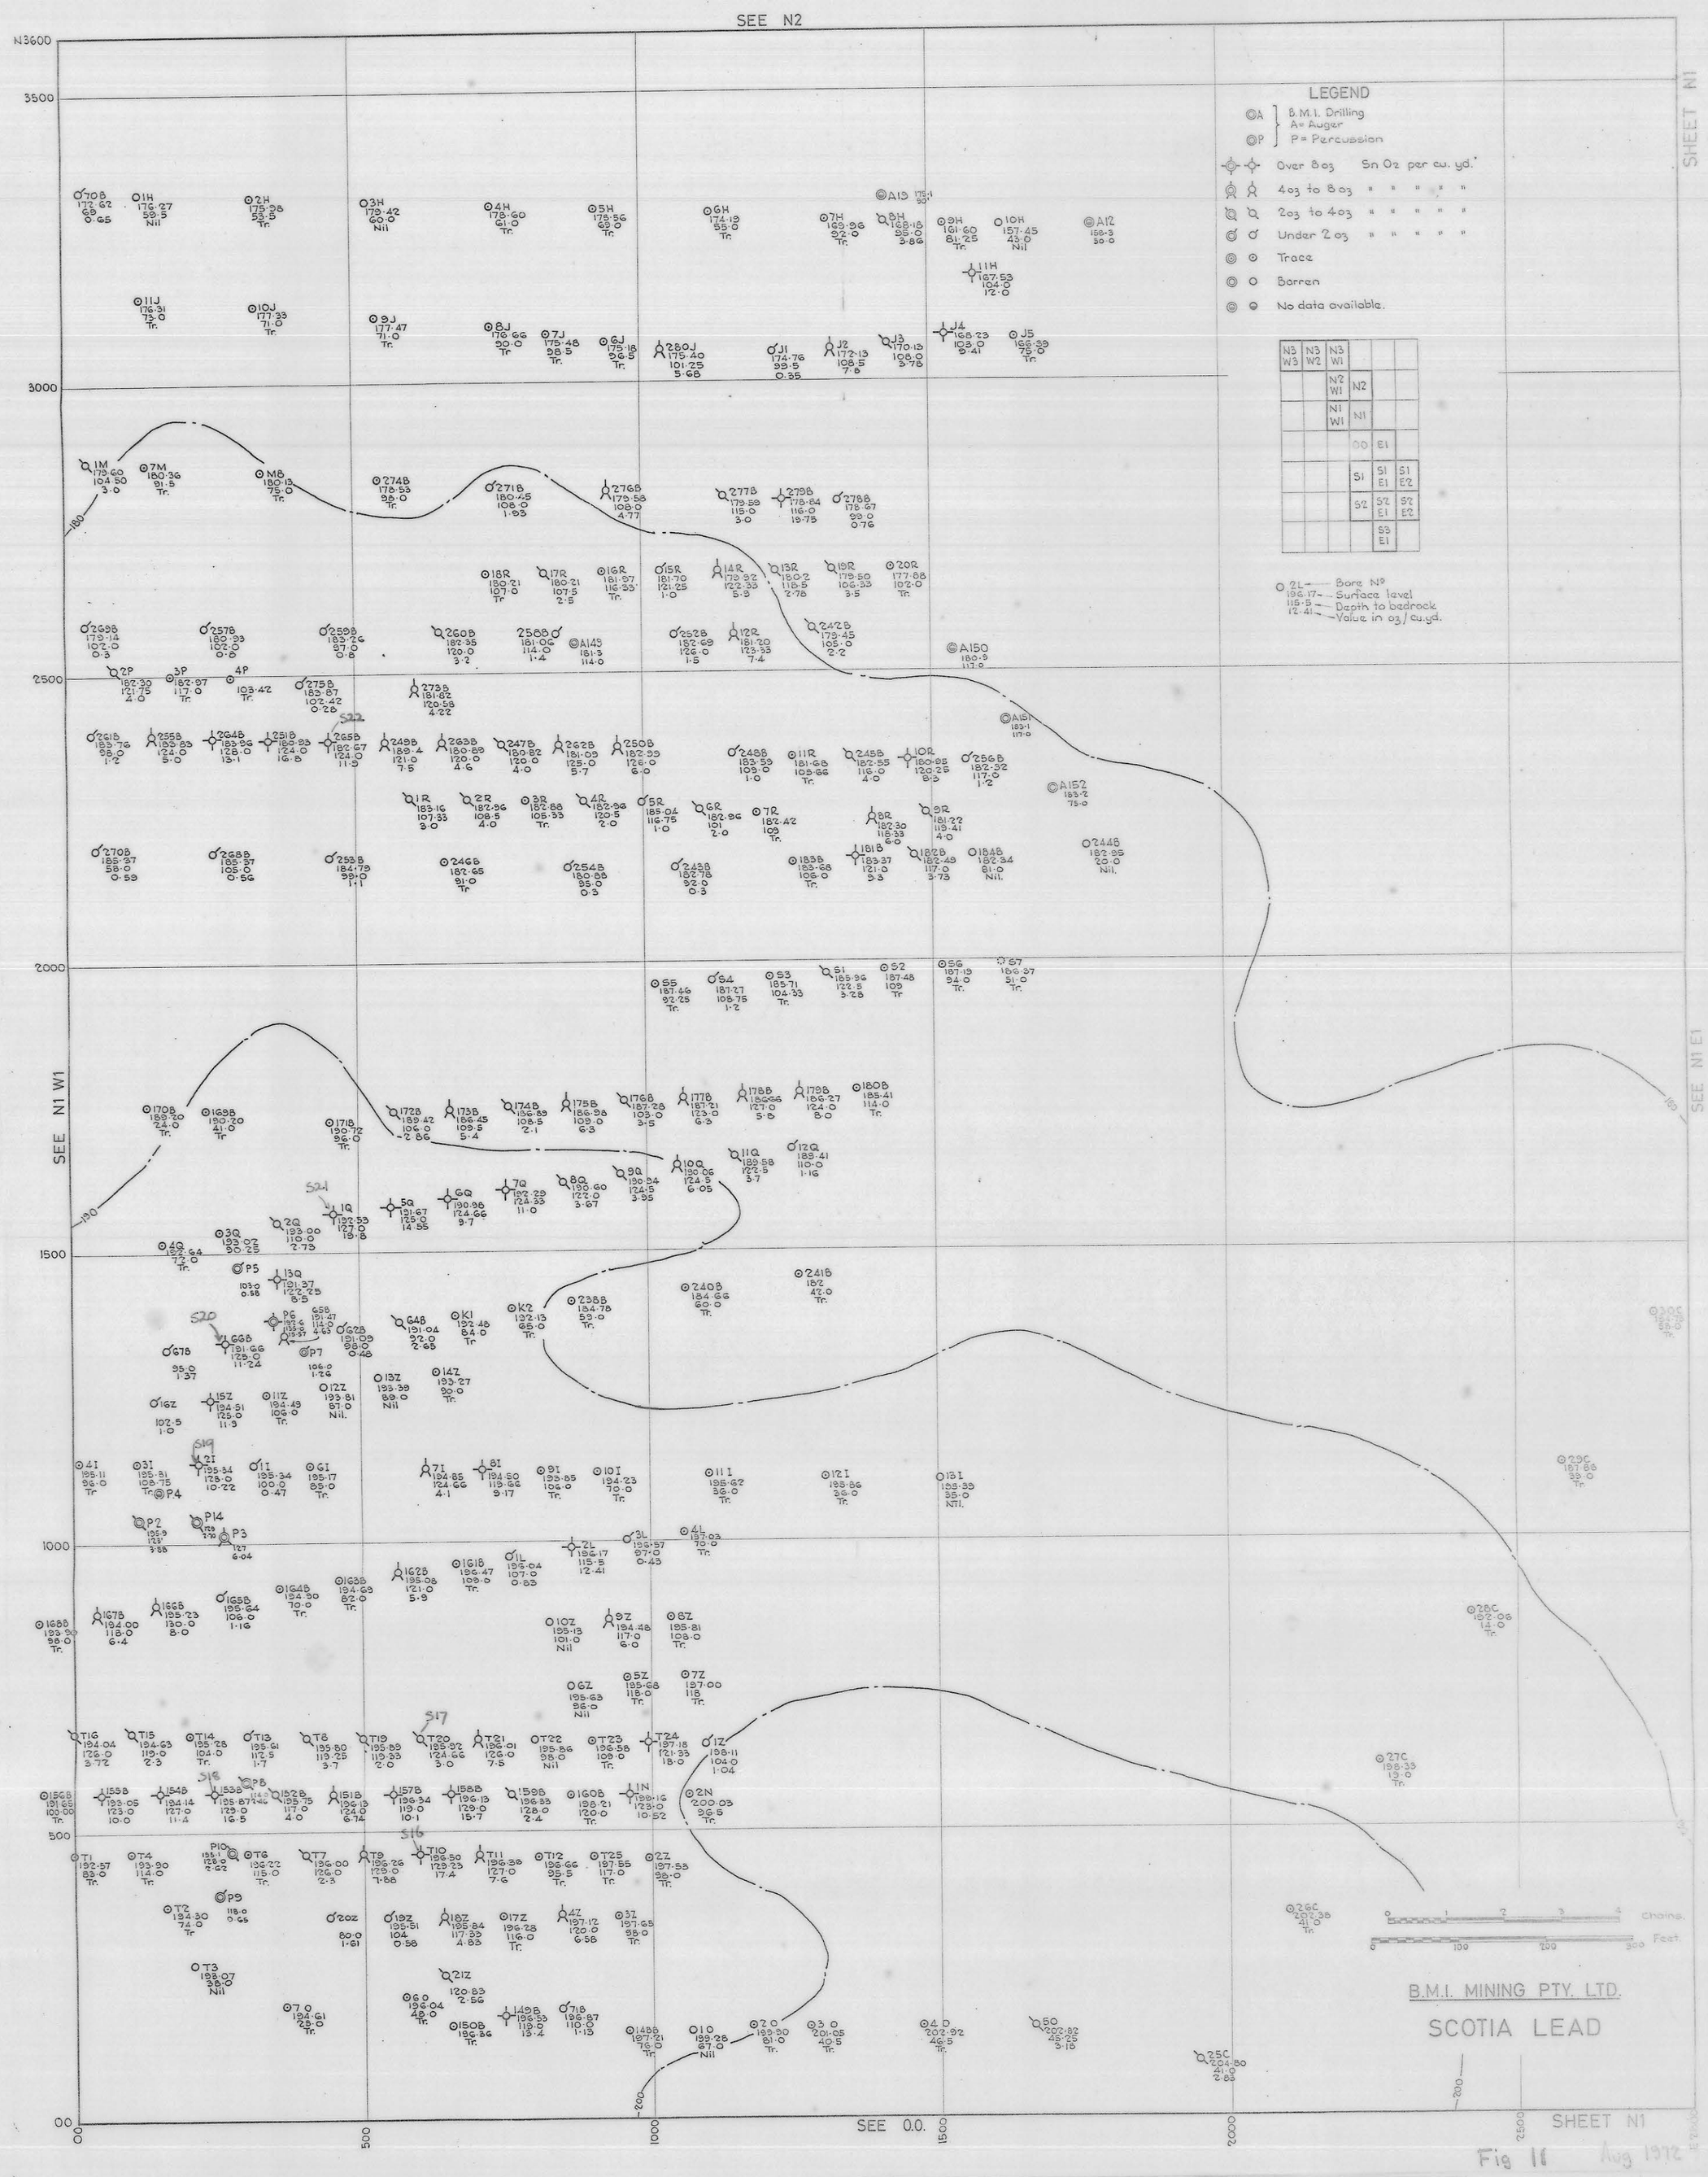

Fig 11 Aug 1972

0401_057

5 cm