DRILL HOLE LOCATIONS 00 FIG 38

0401 - 067

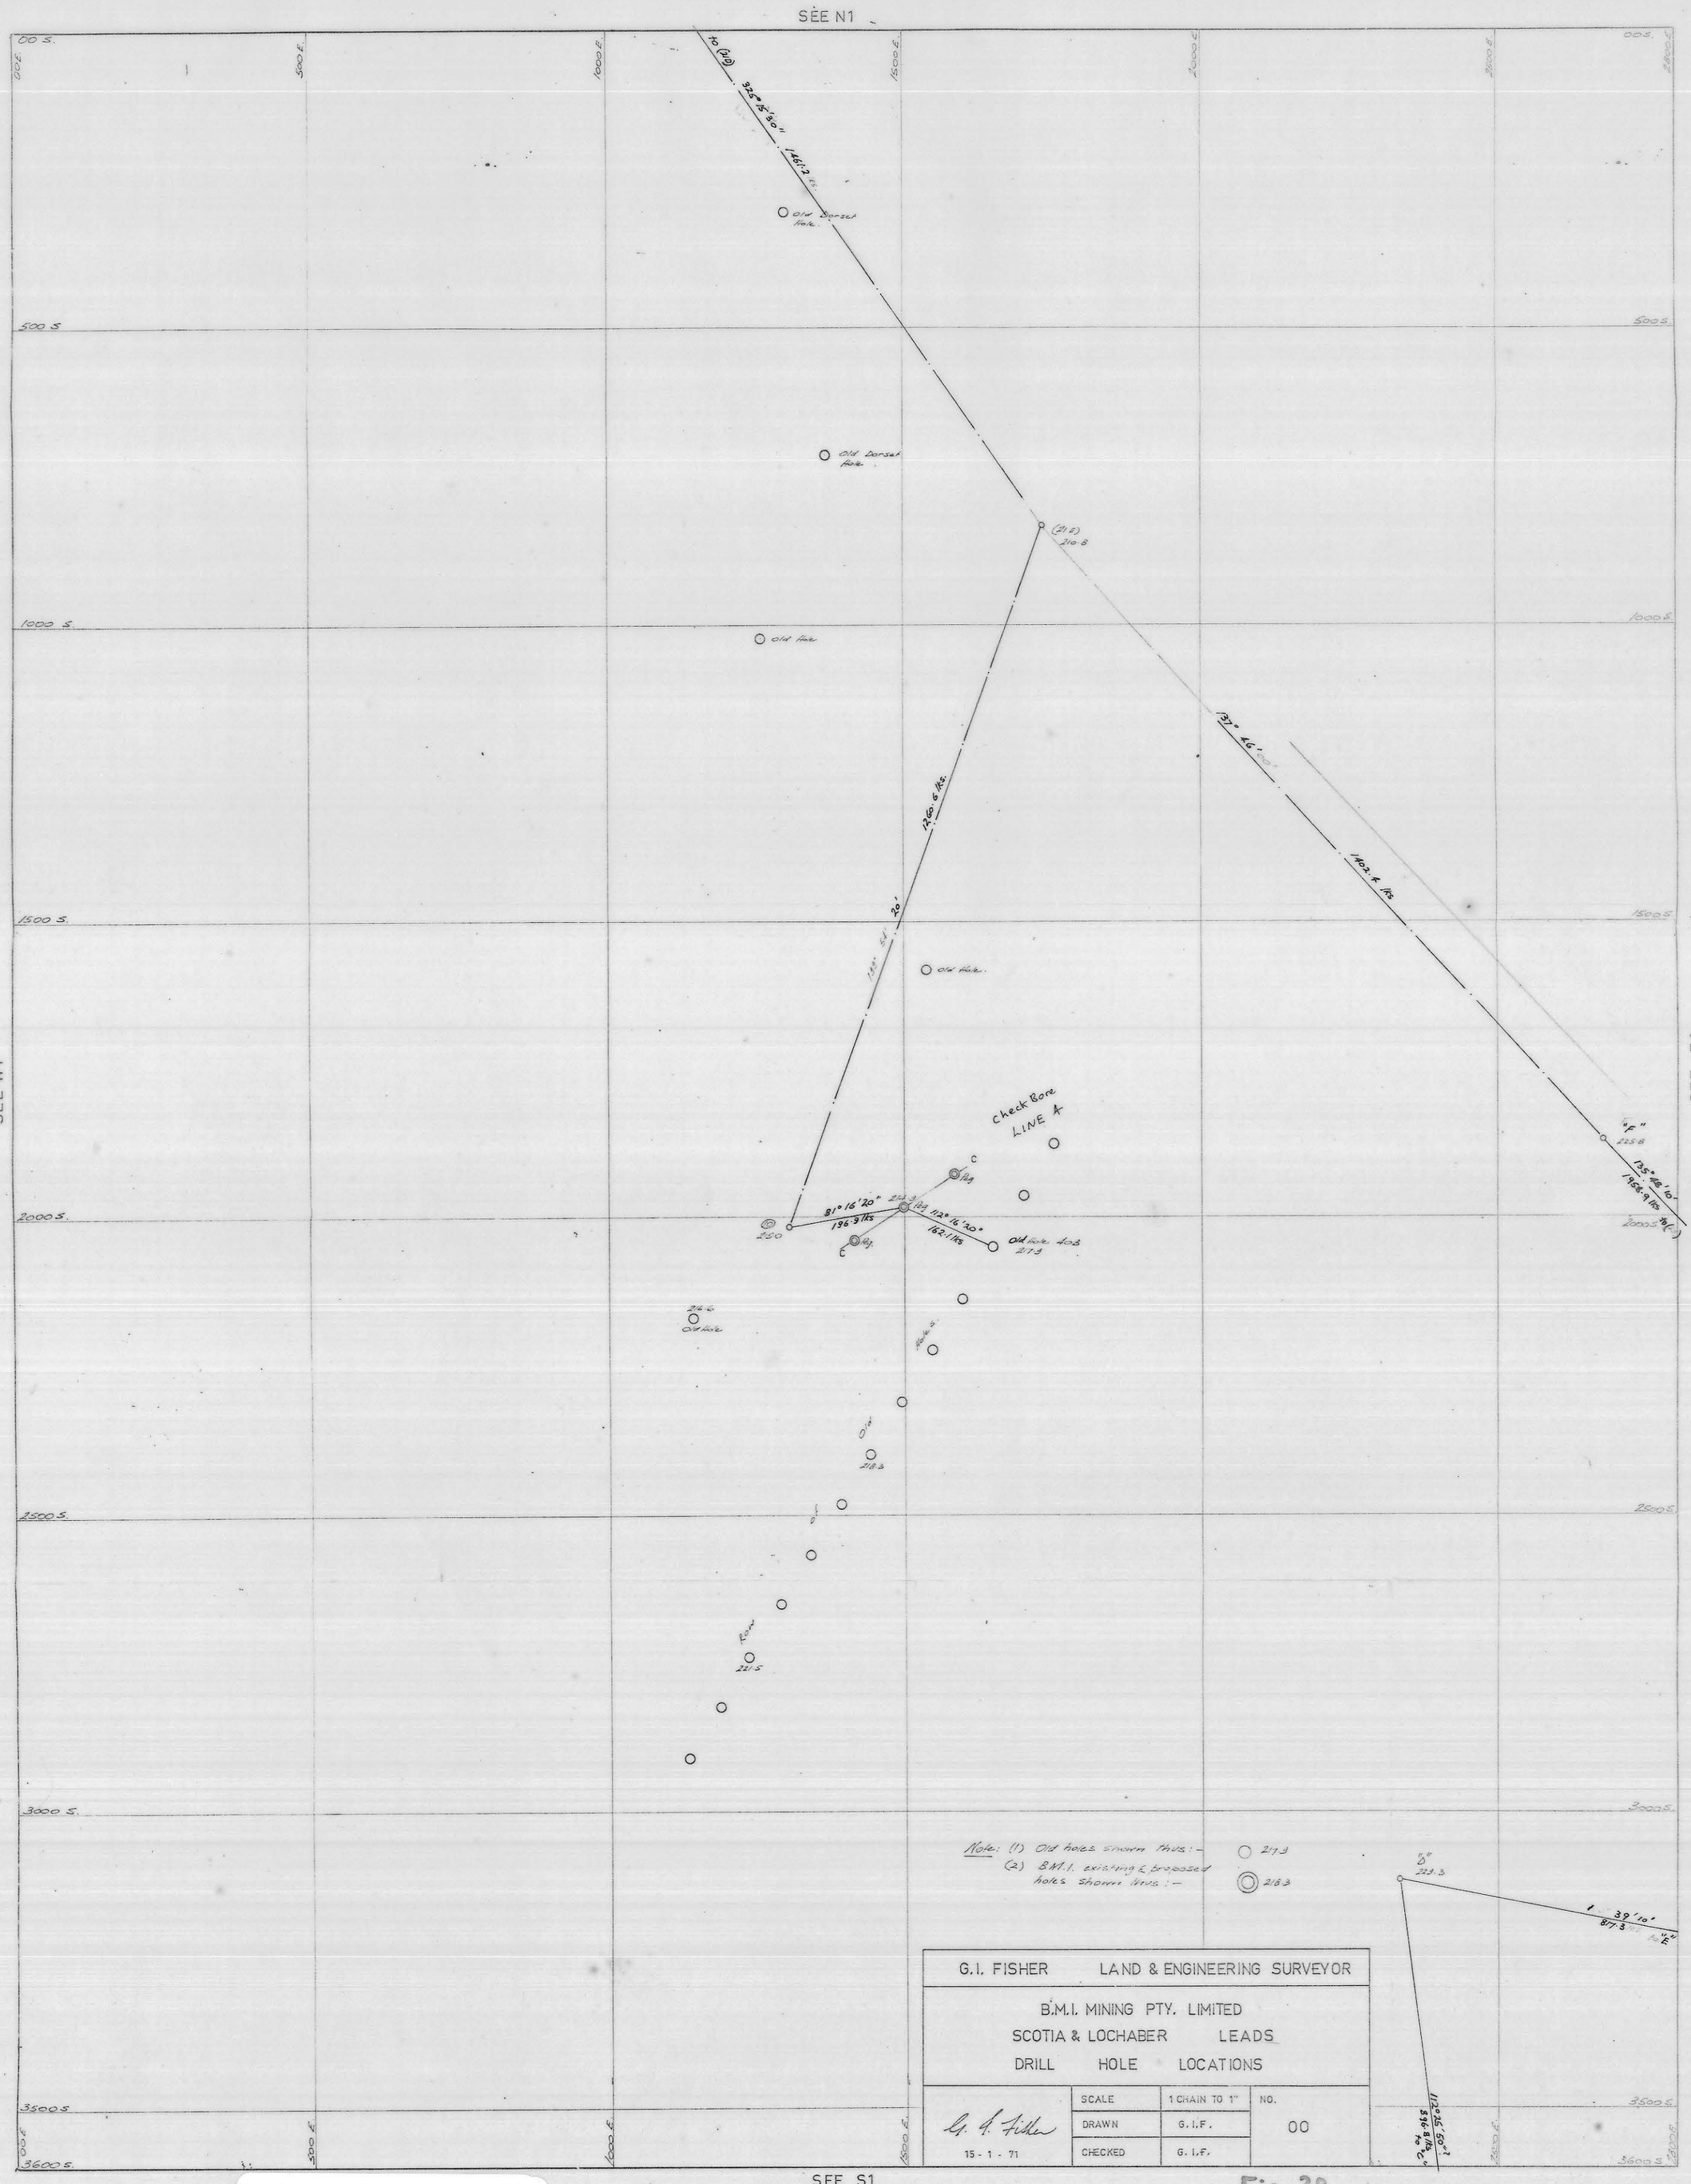

Fig 38

5 cm

0401 - 067