


0402-024

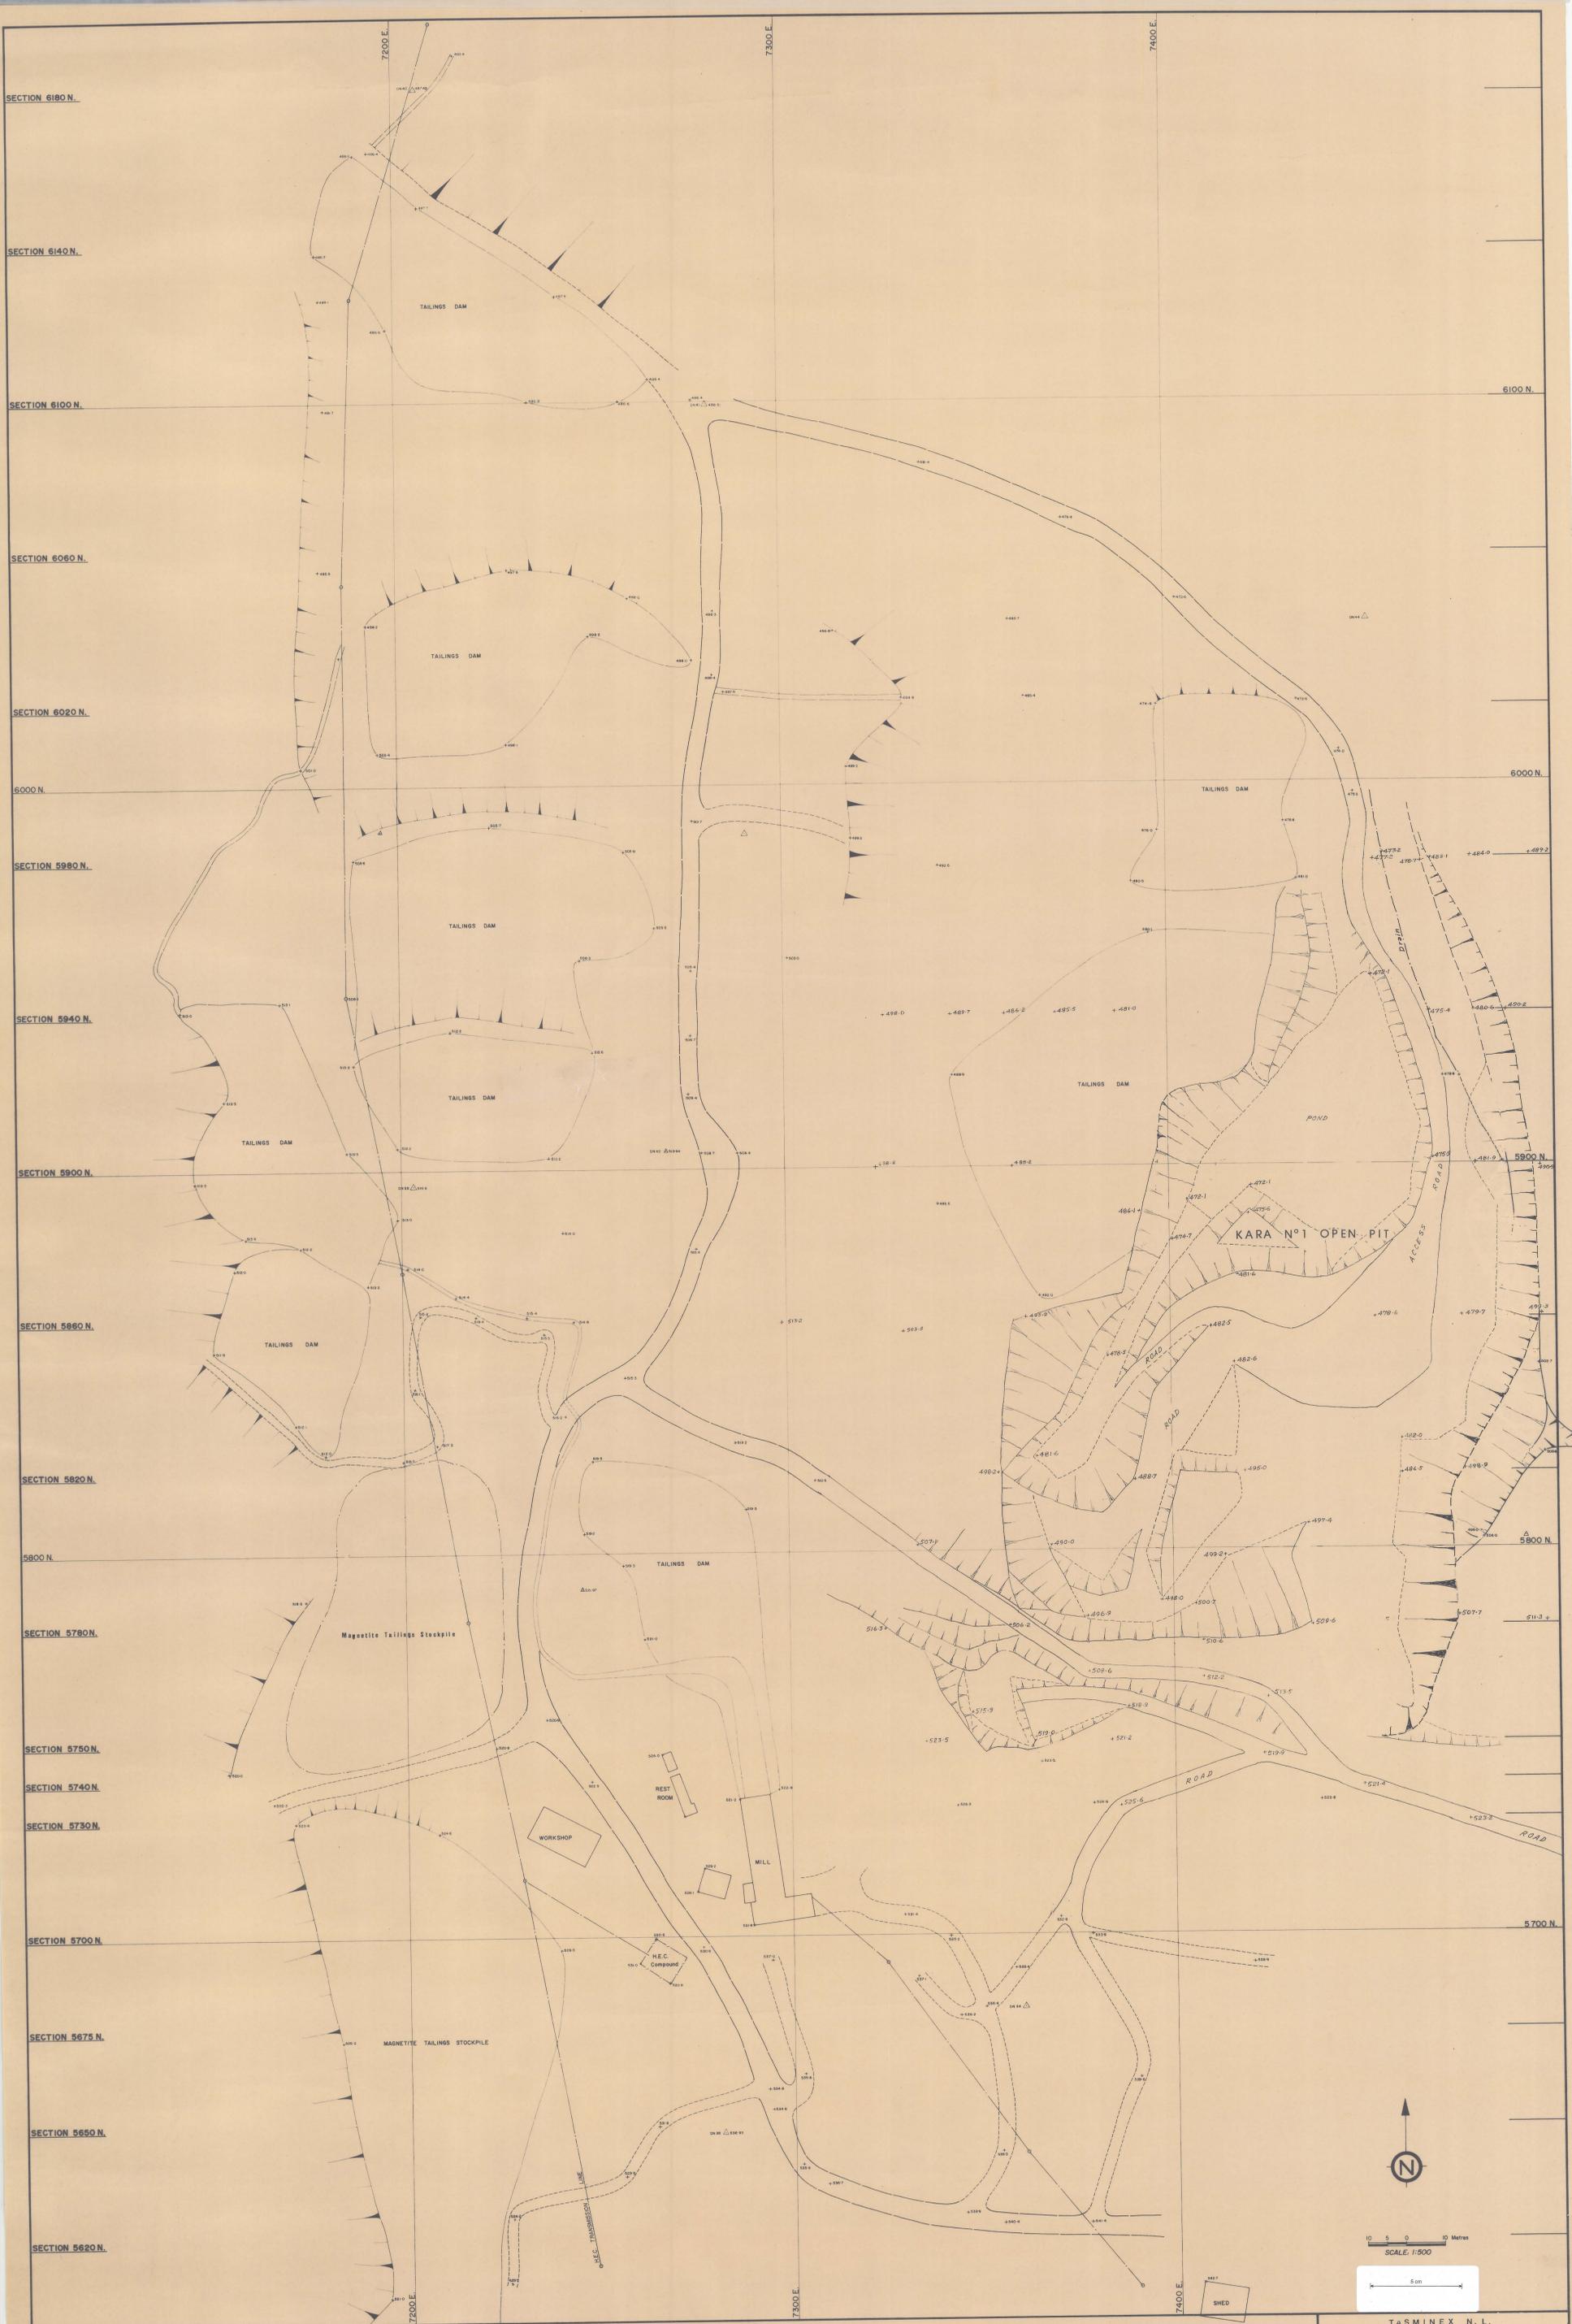

10 5 0 5 10 Metres
SCALE: 1:500



TASMINEX N. L.
 PLAN OF THE KARA TUNGSTEN MINE
 HAMPSHIRE, TASMANIA
 POSITION AT 1st JANUARY 1984
 Scale 1:500 PLAN No. 84/1
 Survey and Plotting Certified by: *[Signature]* 8/3/84