


0402-025
5 cm

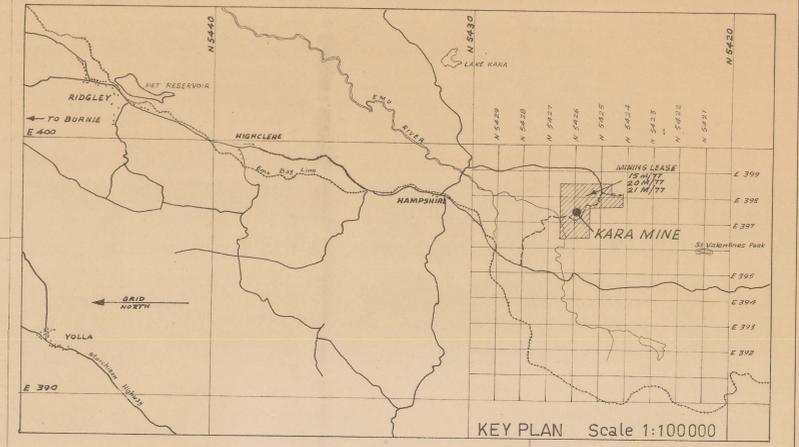

E 397 500

E 397 400

E 397 300

E 397 200

N 425 000

N 425 900

N 425 800

N 425 700

N 425 600



Pop
R.L. 542.44

"KARA NY"
TRIG. STK.

MICROFILMED

TASMINEX N.L.

PLAN OF THE KARA TUNGSTEN MINE
HAMPSHIRE, TASMANIA

SCALE 1 : 500

DATE : 17th MARCH 1978

PLAN No 78/1

SURVEY & PLOTTING CERTIFIED BY
E. N. CHARLTON
Mining Engineer

GRID : Universal Transverse Mercator
LEVELS : Metres Above Sea Level