


0402-026

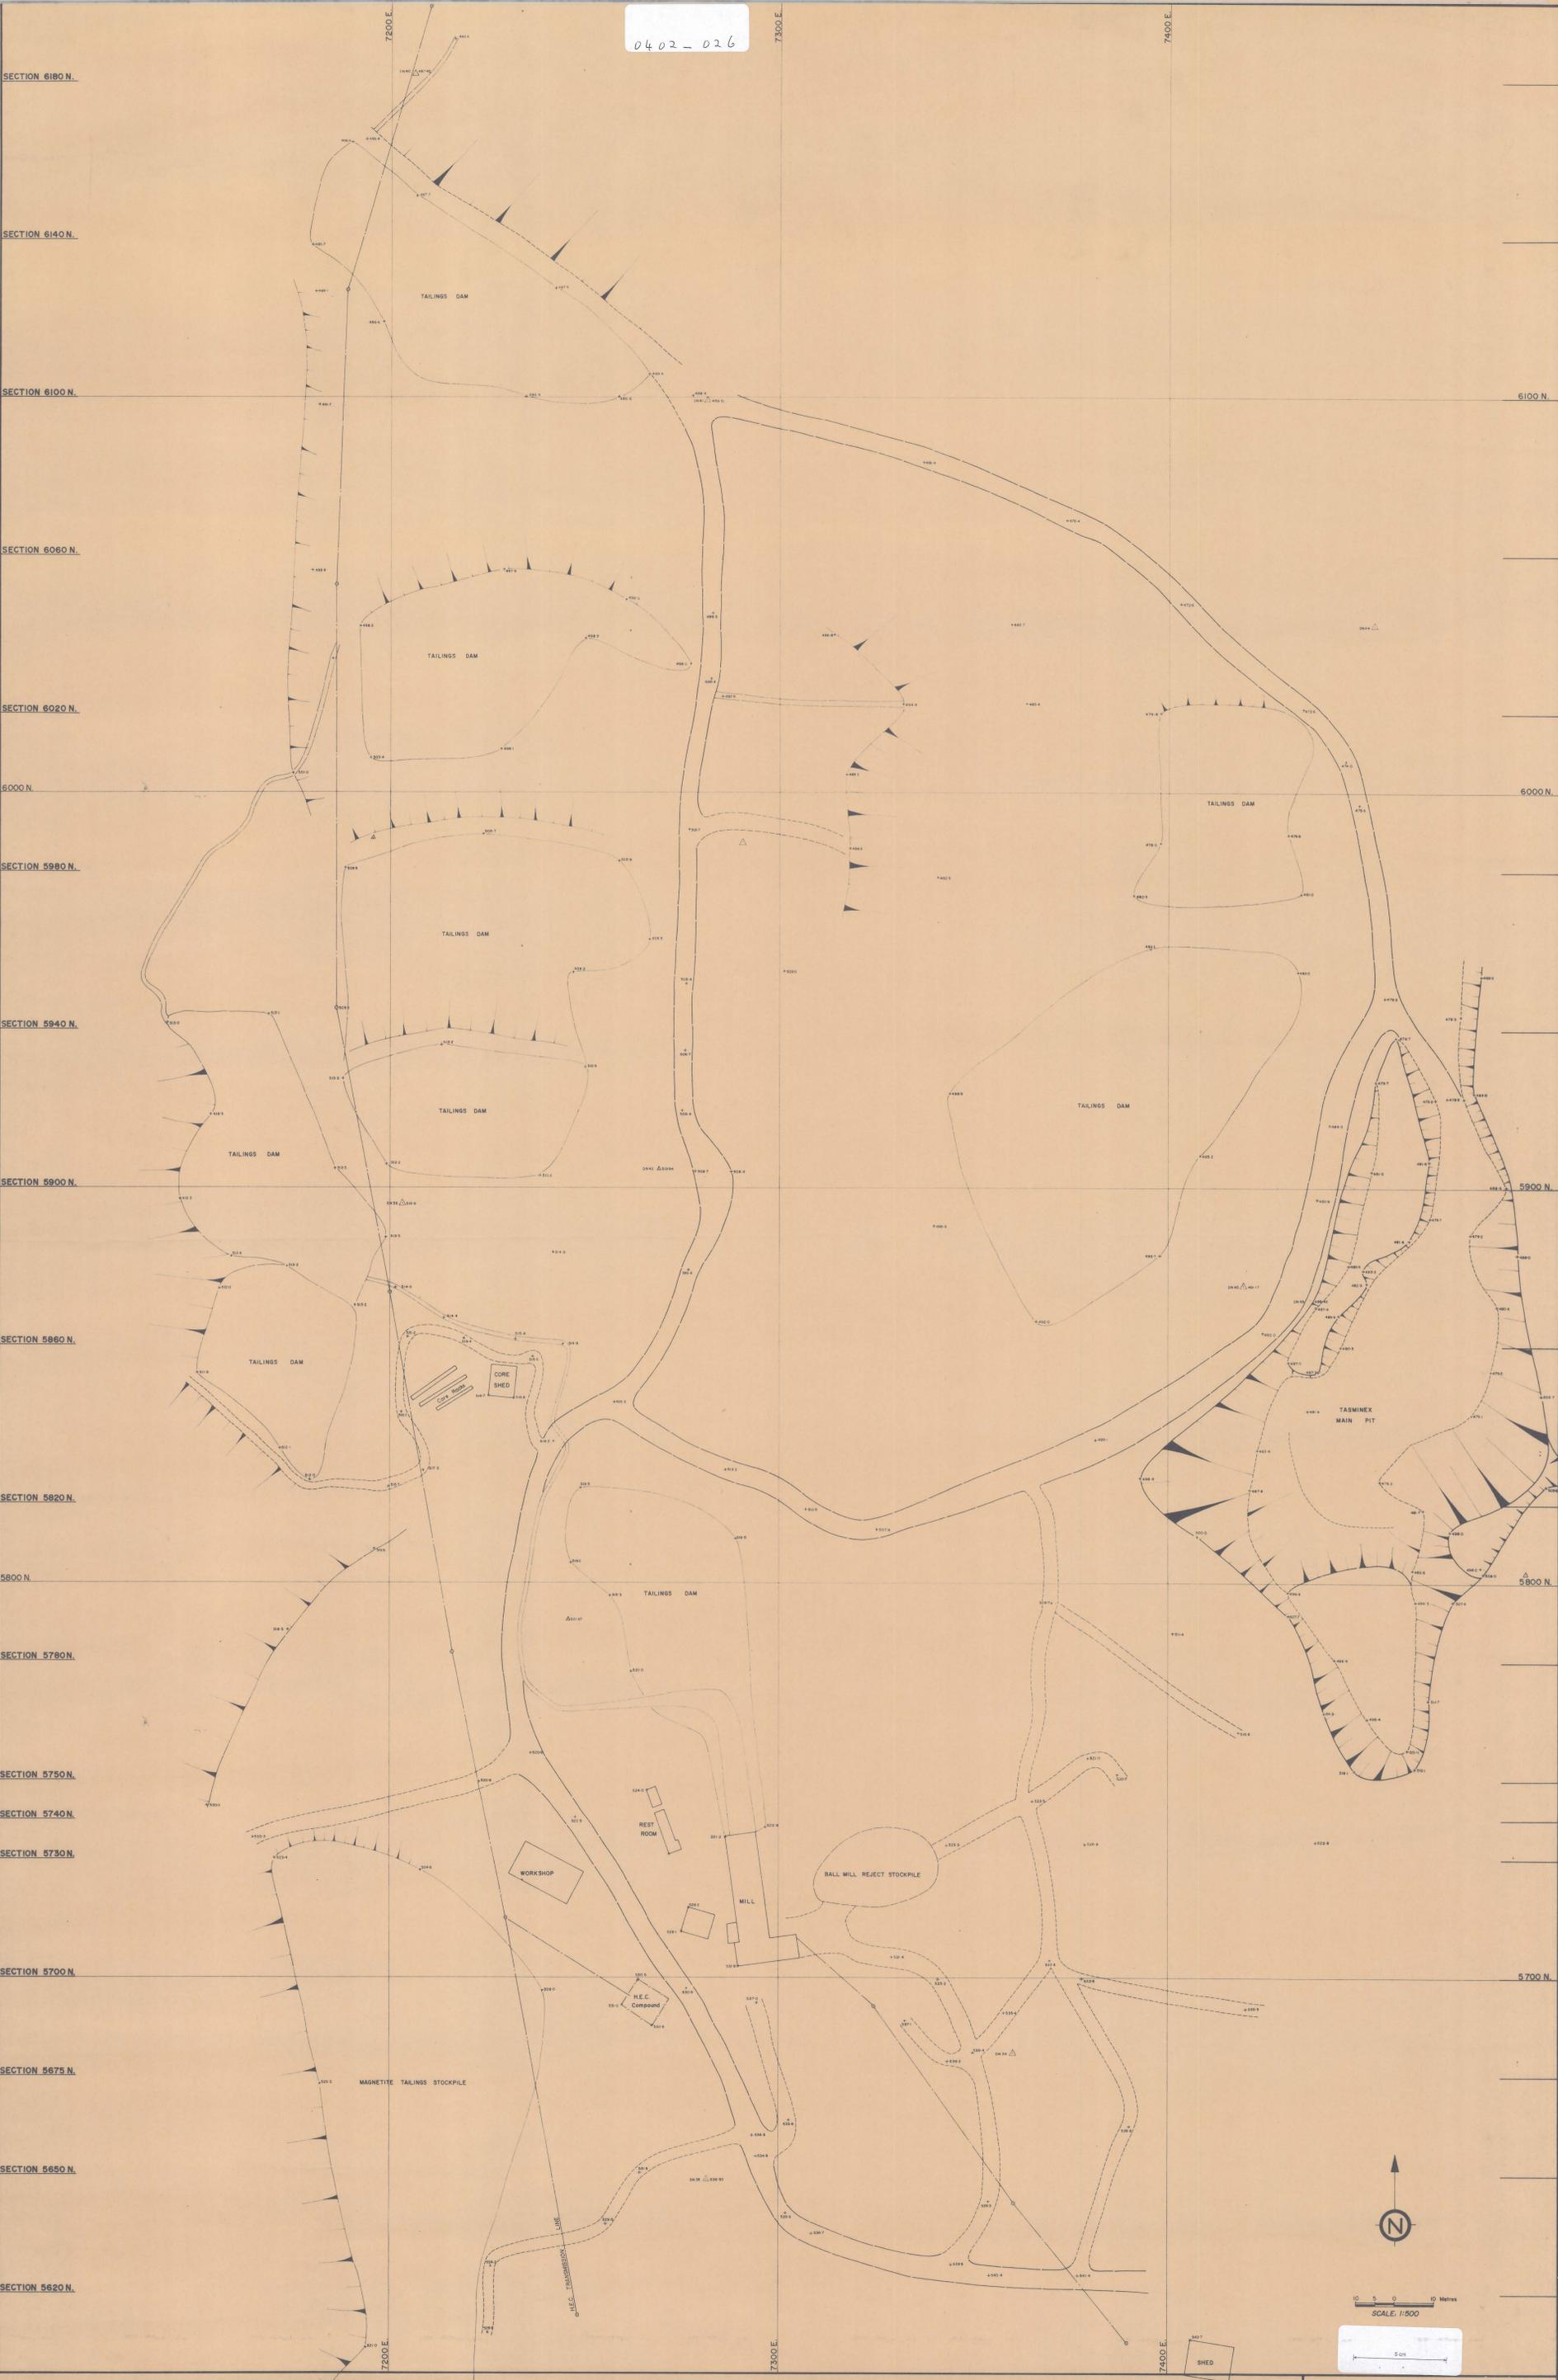

SECTION 6180 N.  
SECTION 6140 N.  
SECTION 6100 N.  
SECTION 6060 N.  
SECTION 6020 N.  
6000 N.  
SECTION 5980 N.  
SECTION 5940 N.  
SECTION 5900 N.  
SECTION 5860 N.  
SECTION 5820 N.  
5800 N.  
SECTION 5780 N.  
SECTION 5750 N.  
SECTION 5740 N.  
SECTION 5730 N.  
SECTION 5700 N.  
SECTION 5675 N.  
SECTION 5650 N.  
SECTION 5620 N.

6100 N.  
6000 N.  
5900 N.  
5800 N.  
5700 N.

7200 E.  
7300 E.  
7400 E.



0 5 10 Metres  
SCALE 1:500



TASMINEX N. L.  
PLAN OF THE KARA TUNGSTEN MINE  
HAMPSHIRE, TASMANIA  
POSITION AT 1st JANUARY 1982  
Scale 1:500 PLAN No. 82/1  
Survey and Plotting Certified by: *[Signature]* 3/3/82