
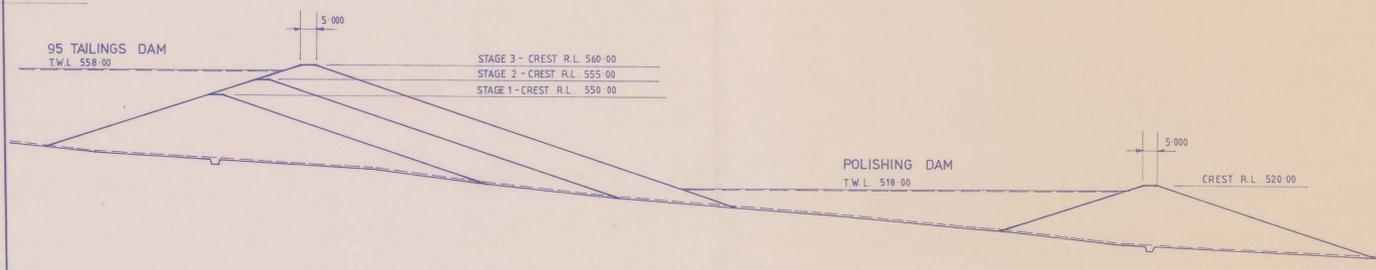


0008/0030

0402_056

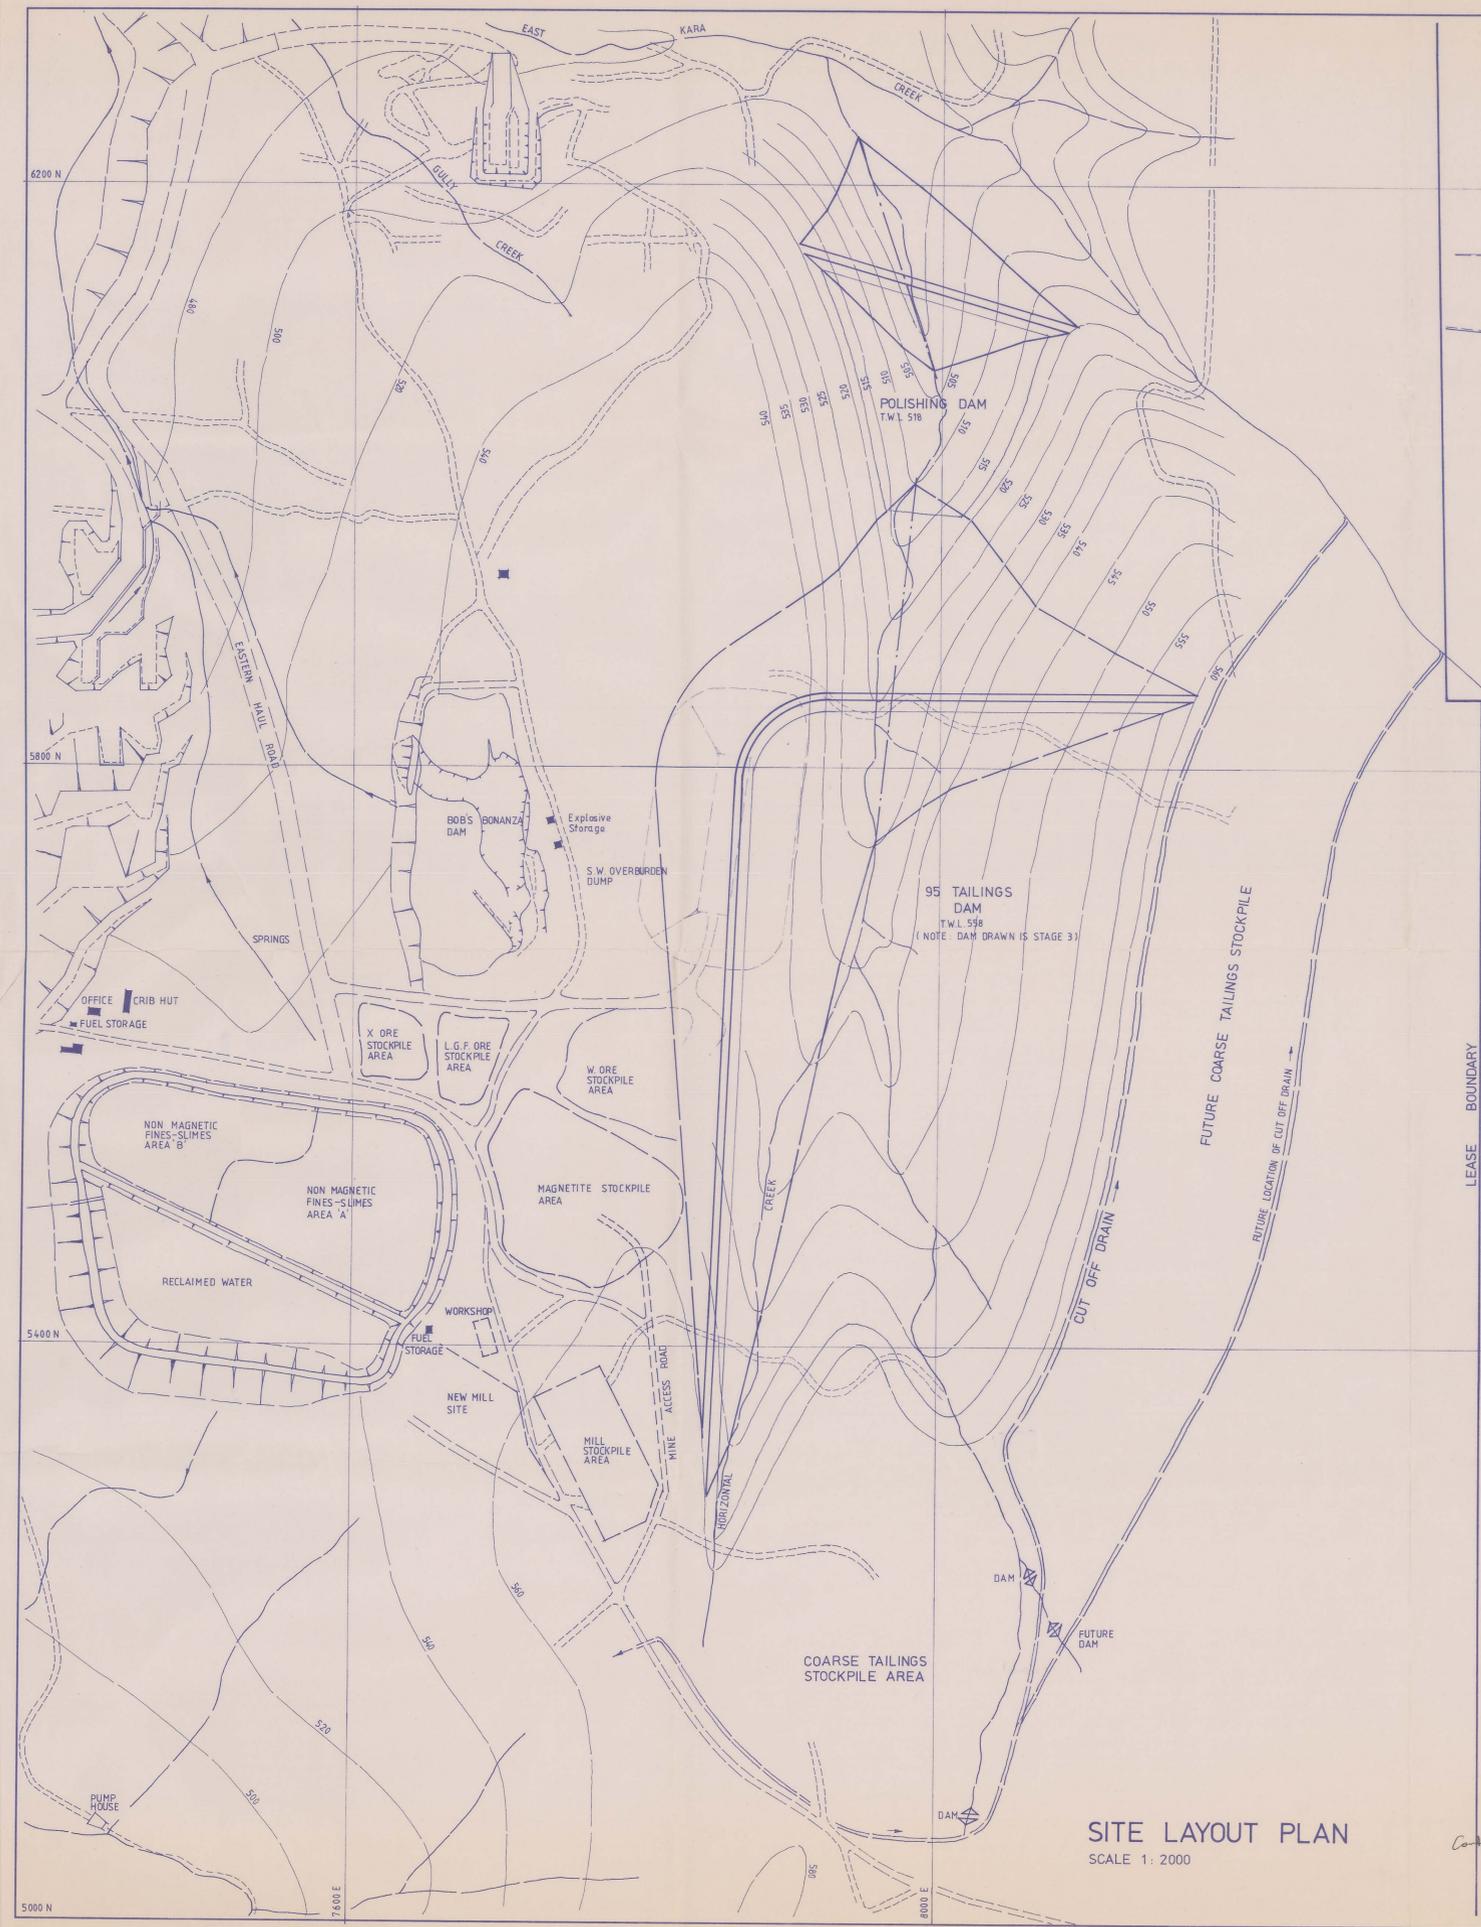

TYPICAL CROSS SECTION THROUGH DAMS
SCALE 1:1000

SITE LAYOUT PLAN
SCALE 1:2000

Spilling? Capacity, anticipated water flow - catchment
Keyway
Horizontal At Division - Coffey Dam.
Further investigation
Geology - Some line trenches or pits to confirm leakage, strength and
weathering.
Comd Spilling - Design - Capacity

REVISION	DATE	DESCRIPTION	
		APPROVED	
NOT FOR CONSTRUCTION			
TASMANIAN CONSULTING SERVICE <small>ACTL 009 579 433</small> ENGINEERING AND BUILDING CONSULTANTS CONSTRUCTION AND PROJECT MANAGERS 74 OLDMAKER STREET, DEVONPORT 7310 P.O. BOX 1047, DEVONPORT 7310 TELEPHONE (004) 24 9085, FACSIMILE (004) 24 5709			
PROJECT: TASMANIAN MINES LIMITED KARA MINE HAMPSHIRE 95 TAILINGS DAM			
DRAWING:			
PRELIMINARY PLAN AND SECTION			
SCALE	DATUM		
1:2000 1:1000			
DESIGNED	G.H.A.	DRAWING NUMBER	
DRAWN	C.F.J.		20-08-95
CHECKED	C.H.A.		
APPROVED	C.H.A.		13-0-95
		3413-01	