0406 - 045

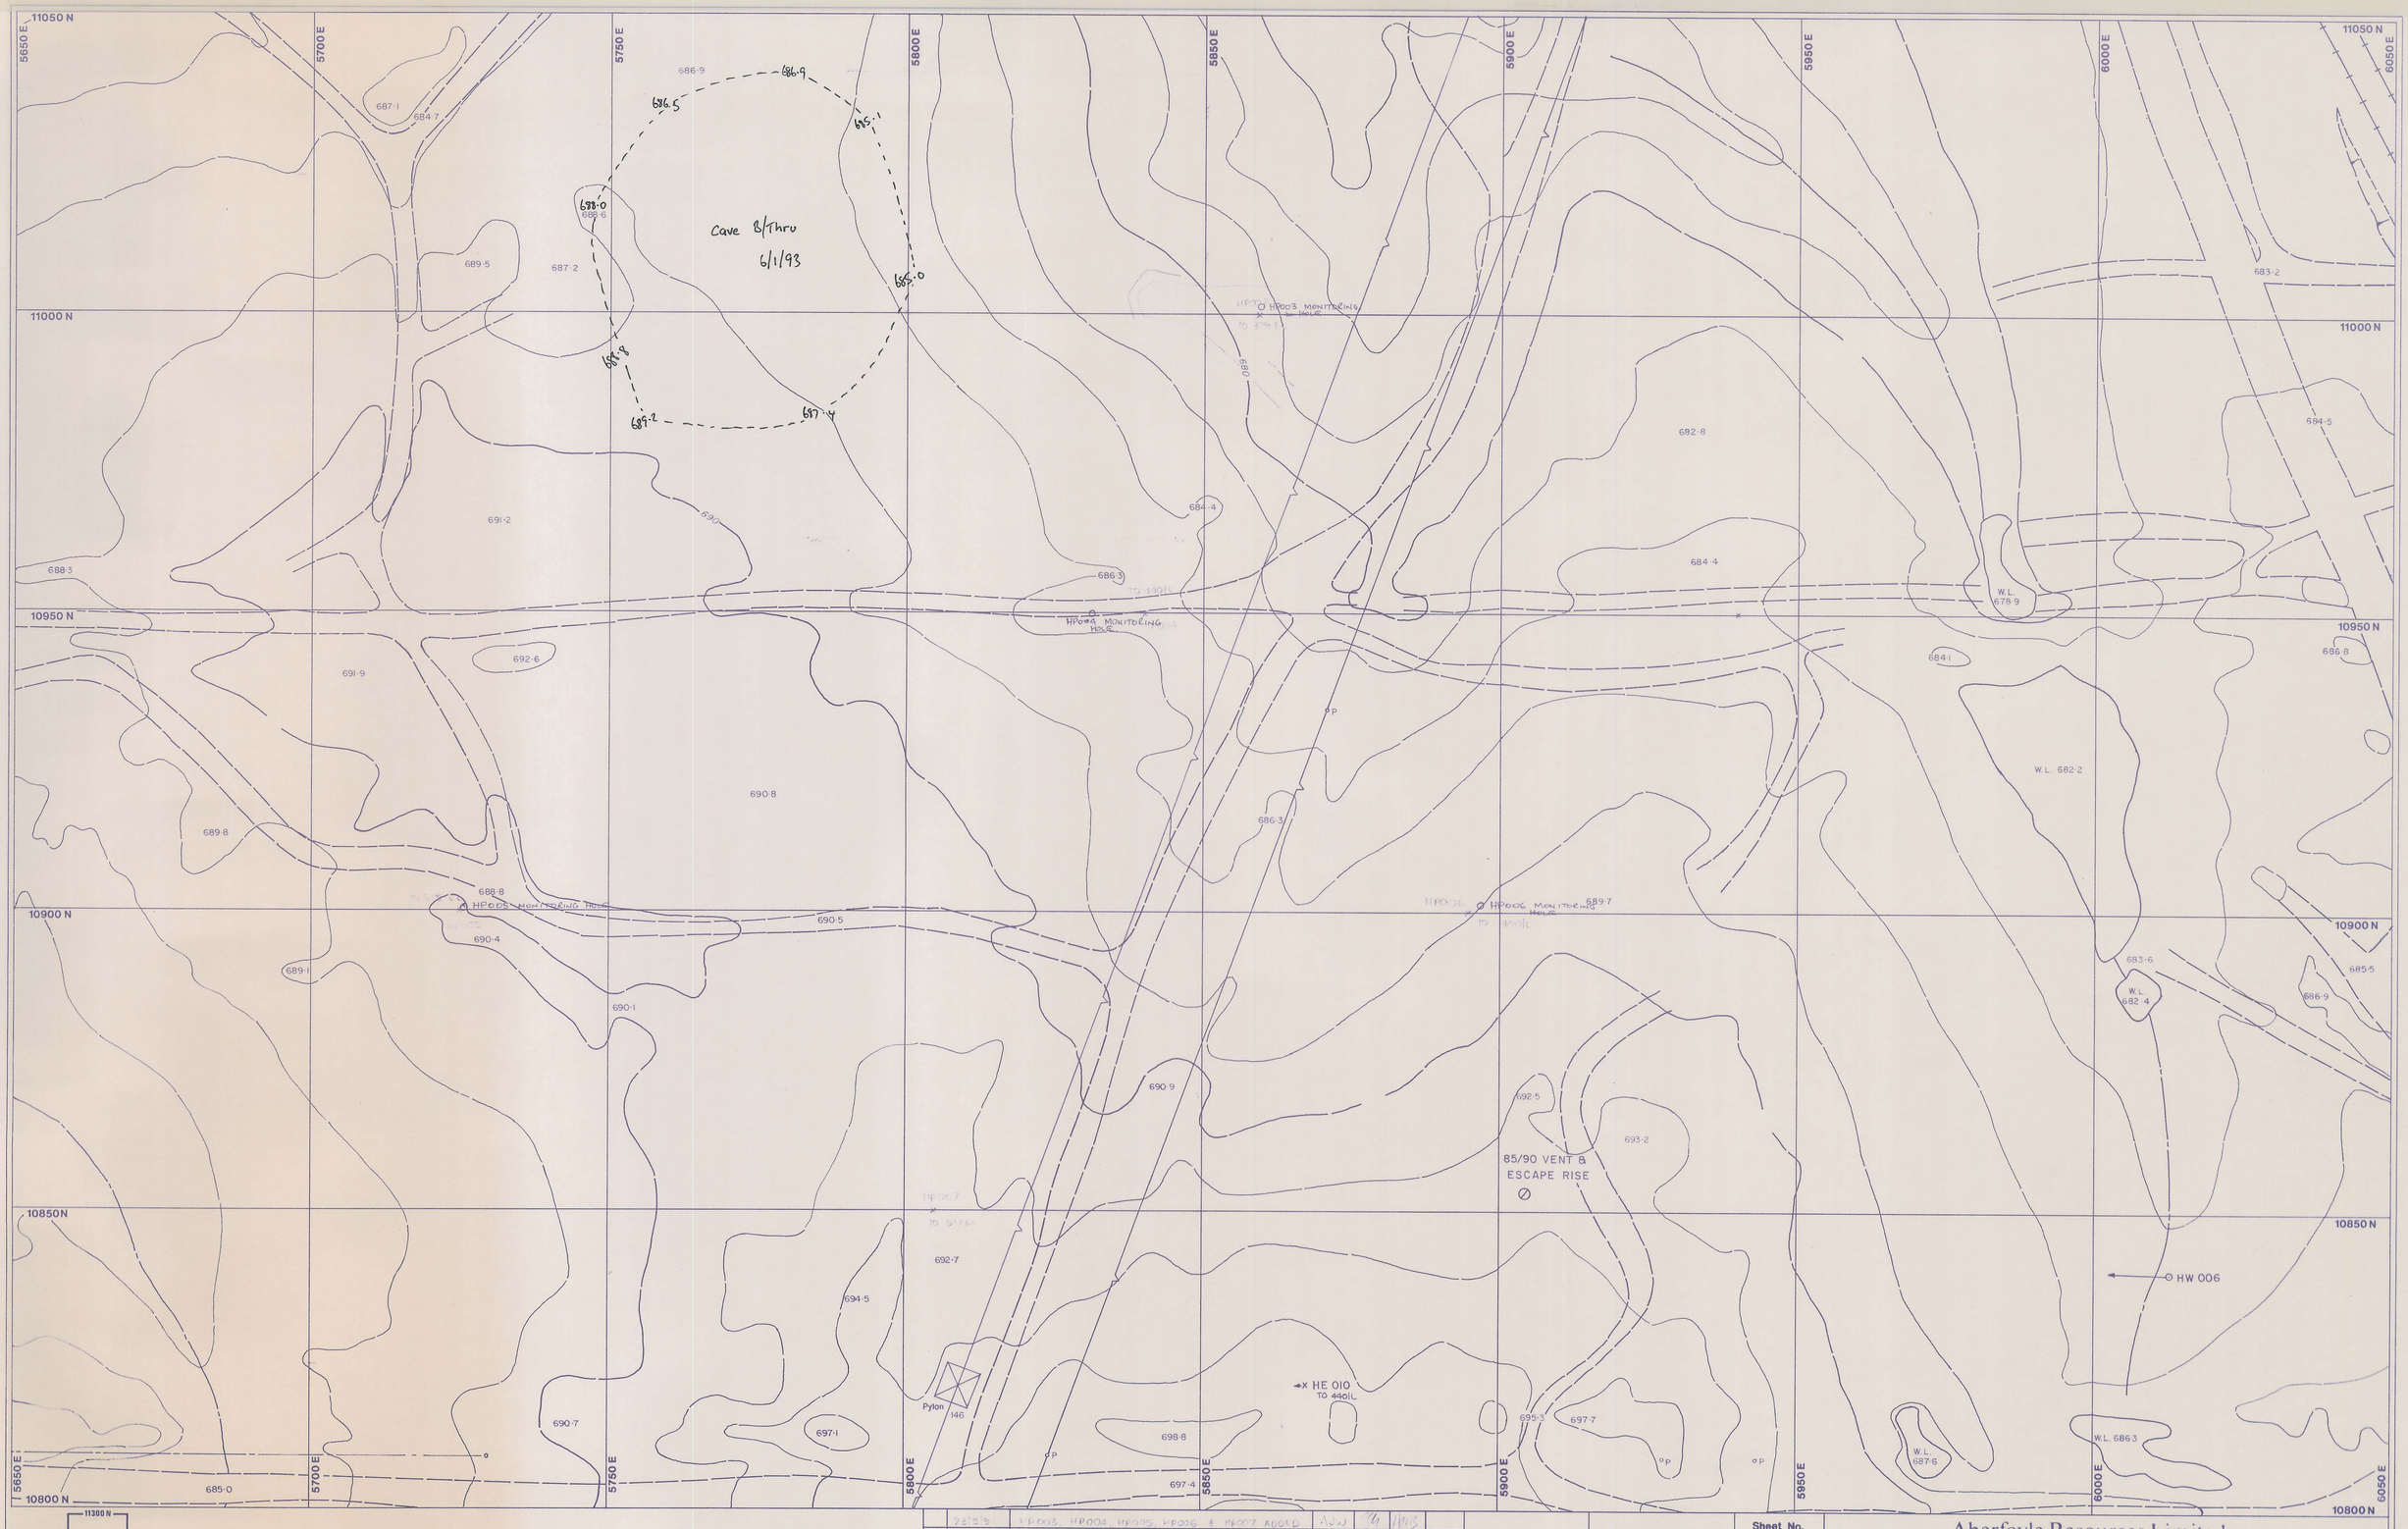

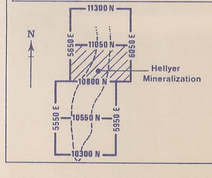

5 cm

REV	DATE	REVISION	DRAWN	CKD	APP	APP
	22/3/93	HP003, HP004, HP005, HP006 & HP007 ADDED	AJW			
	6-1-93	SURVRY CAVED AREA	DAS			

NORTH

SCALE 1:500		Sheet No. 1105-605
DRAWN	AJW	30/4/90
CHECKED		
DESIGNED		
DESIGN CKD		
DESIGN APP		
PROJECT APP		

Aberfoyle Resources Limited
HELLYER DIVISION

PROJECT :

DEVELOPMENT DESIGN
SURFACE

DRAWING NO.

REVISION