0406 - 046

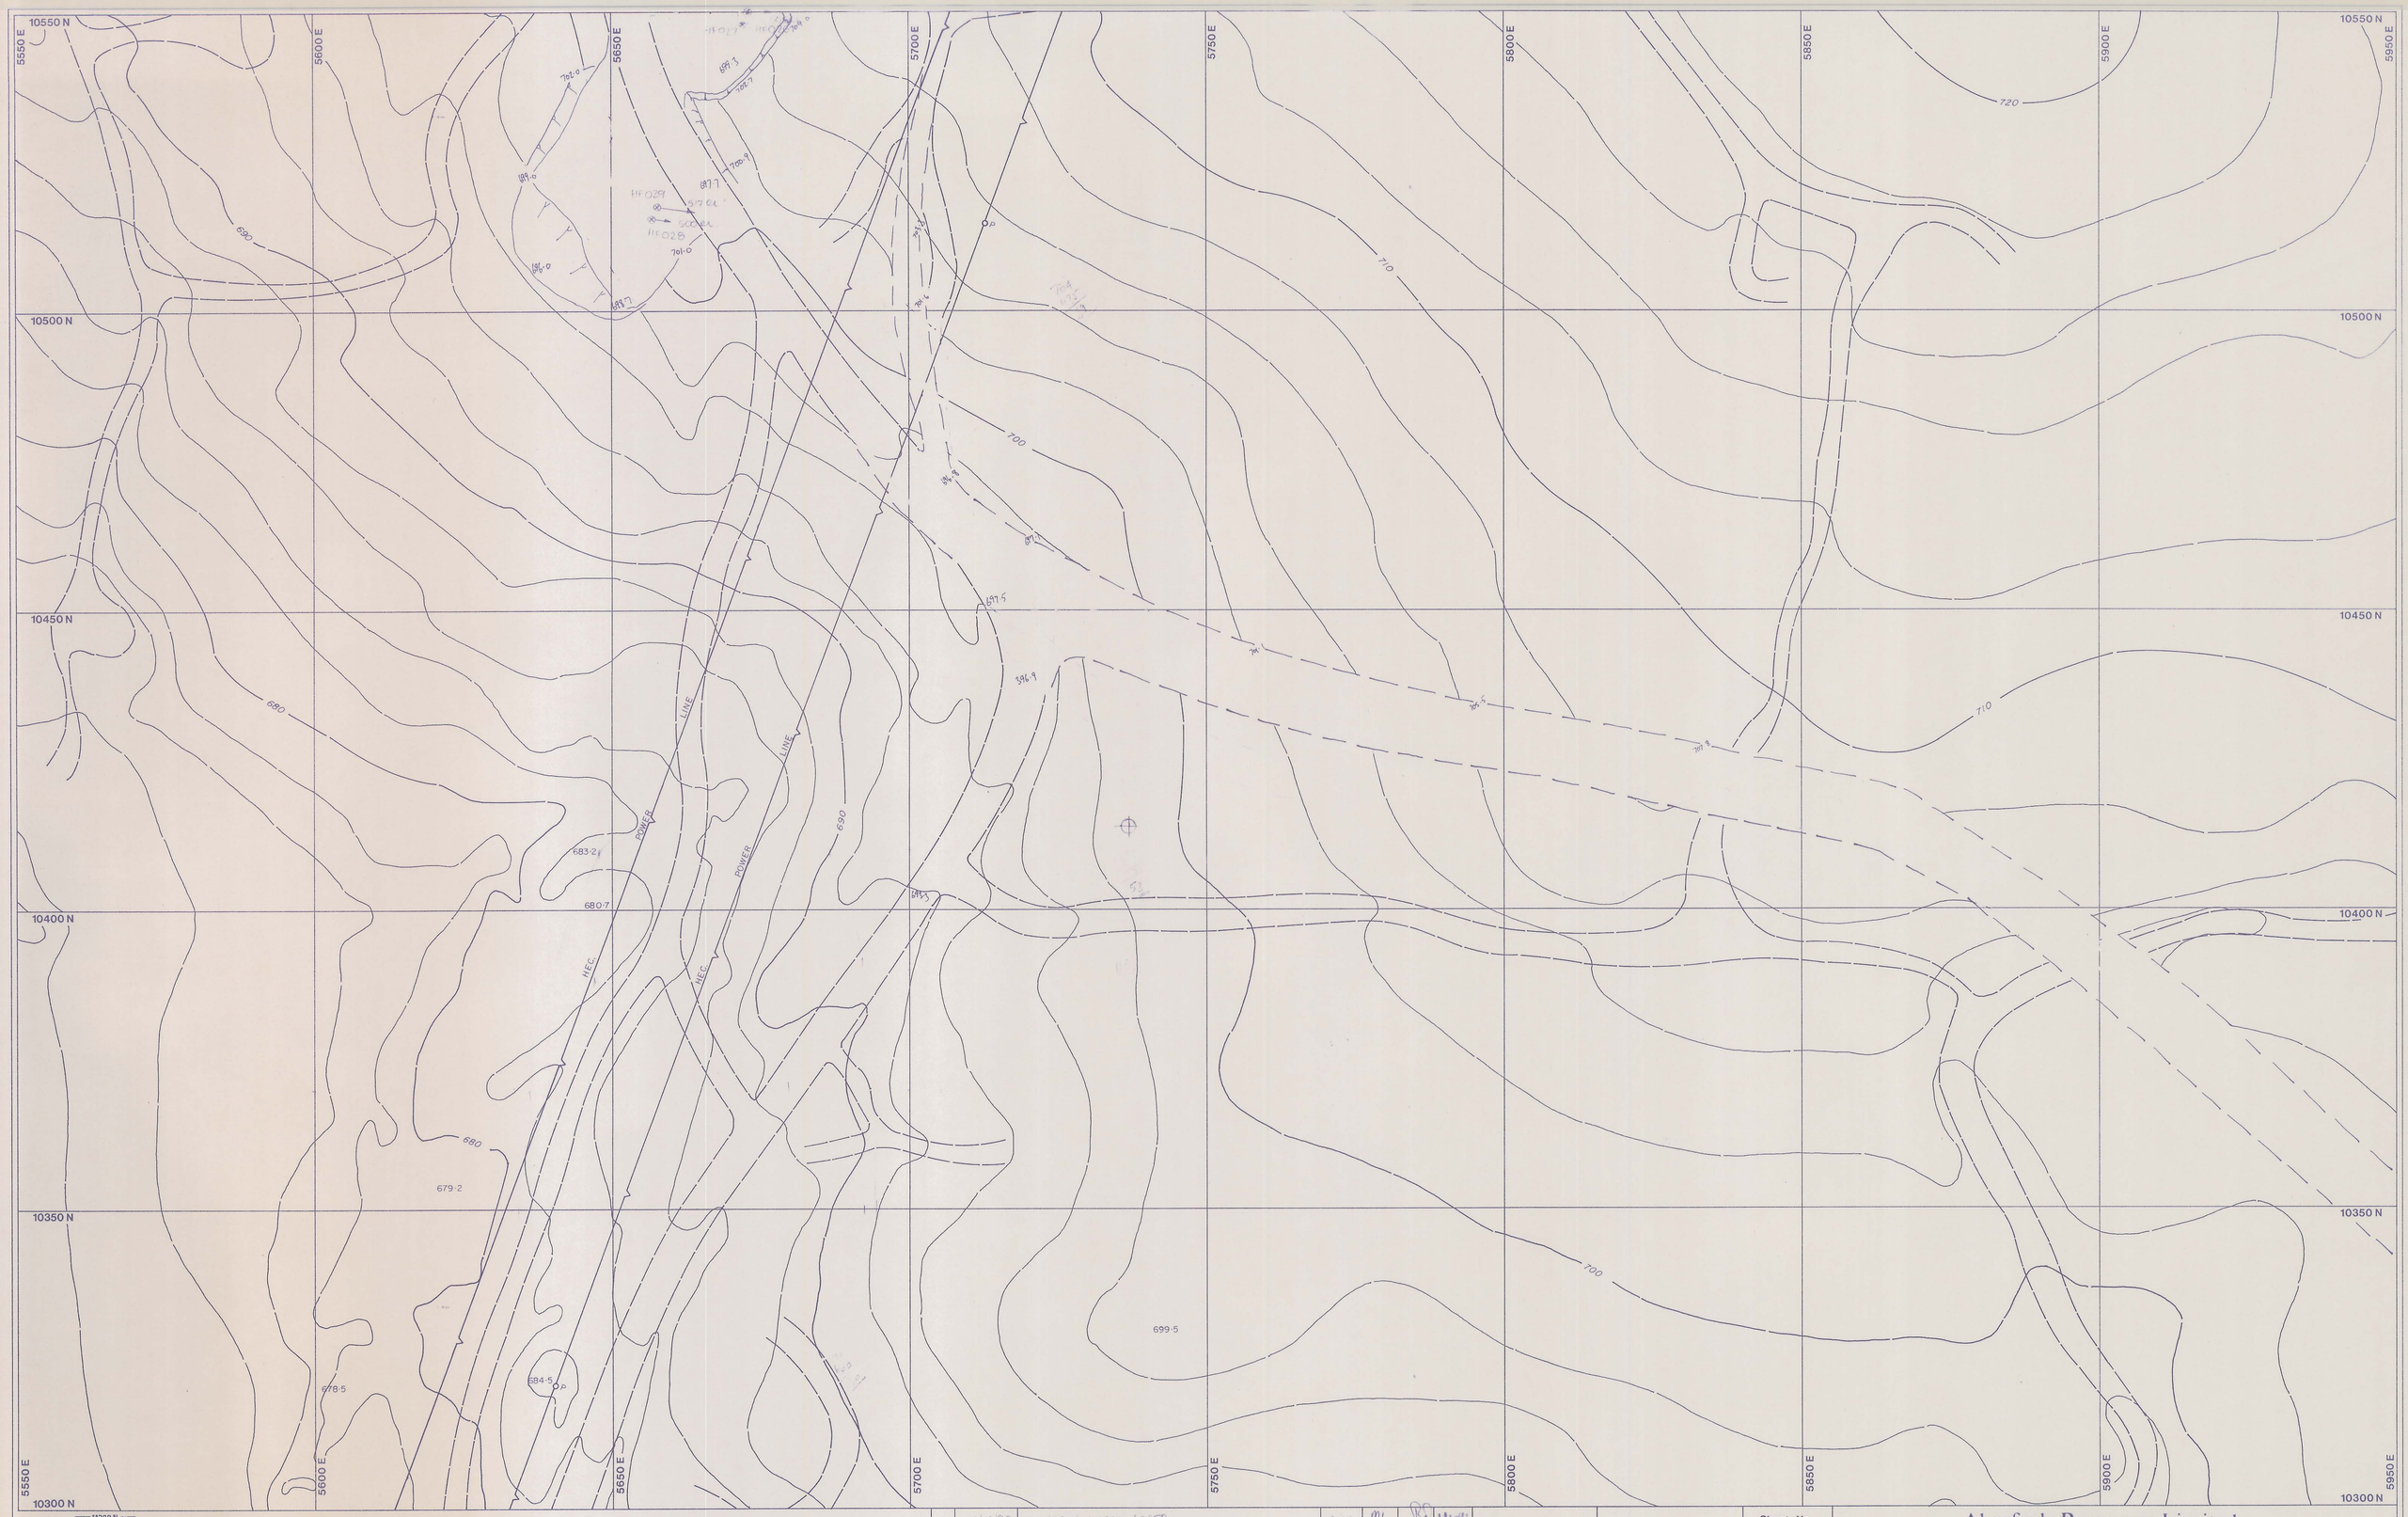

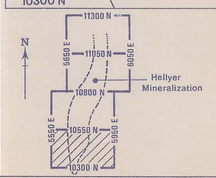

5 cm

REV	DATE	REVISION	DRAWN	CKD	APP	DIGIT DATE
1	13/5/92	HF026 & HF027 ADDED.	AJW	ML		
2	17/11/92	HF028 & HF029 ADDED	AJW	ML		
3	17-11-92	SURVEY EXCAVATION HF029	AMS		15-3-93	

NORTH

SCALE 1:500		Sheet No. 1055-595
DRAWN	AJW	30/4/90
CHECKED		
DESIGNED		
DESIGN CKD		
DESIGN APP		
PROJECT APP		

Aberfoyle Resources Limited
HELLYER DIVISION

PROJECT :

DEVELOPMENT DESIGN
SURFACE

DRAWING NO.

REVISION