0406 - 062

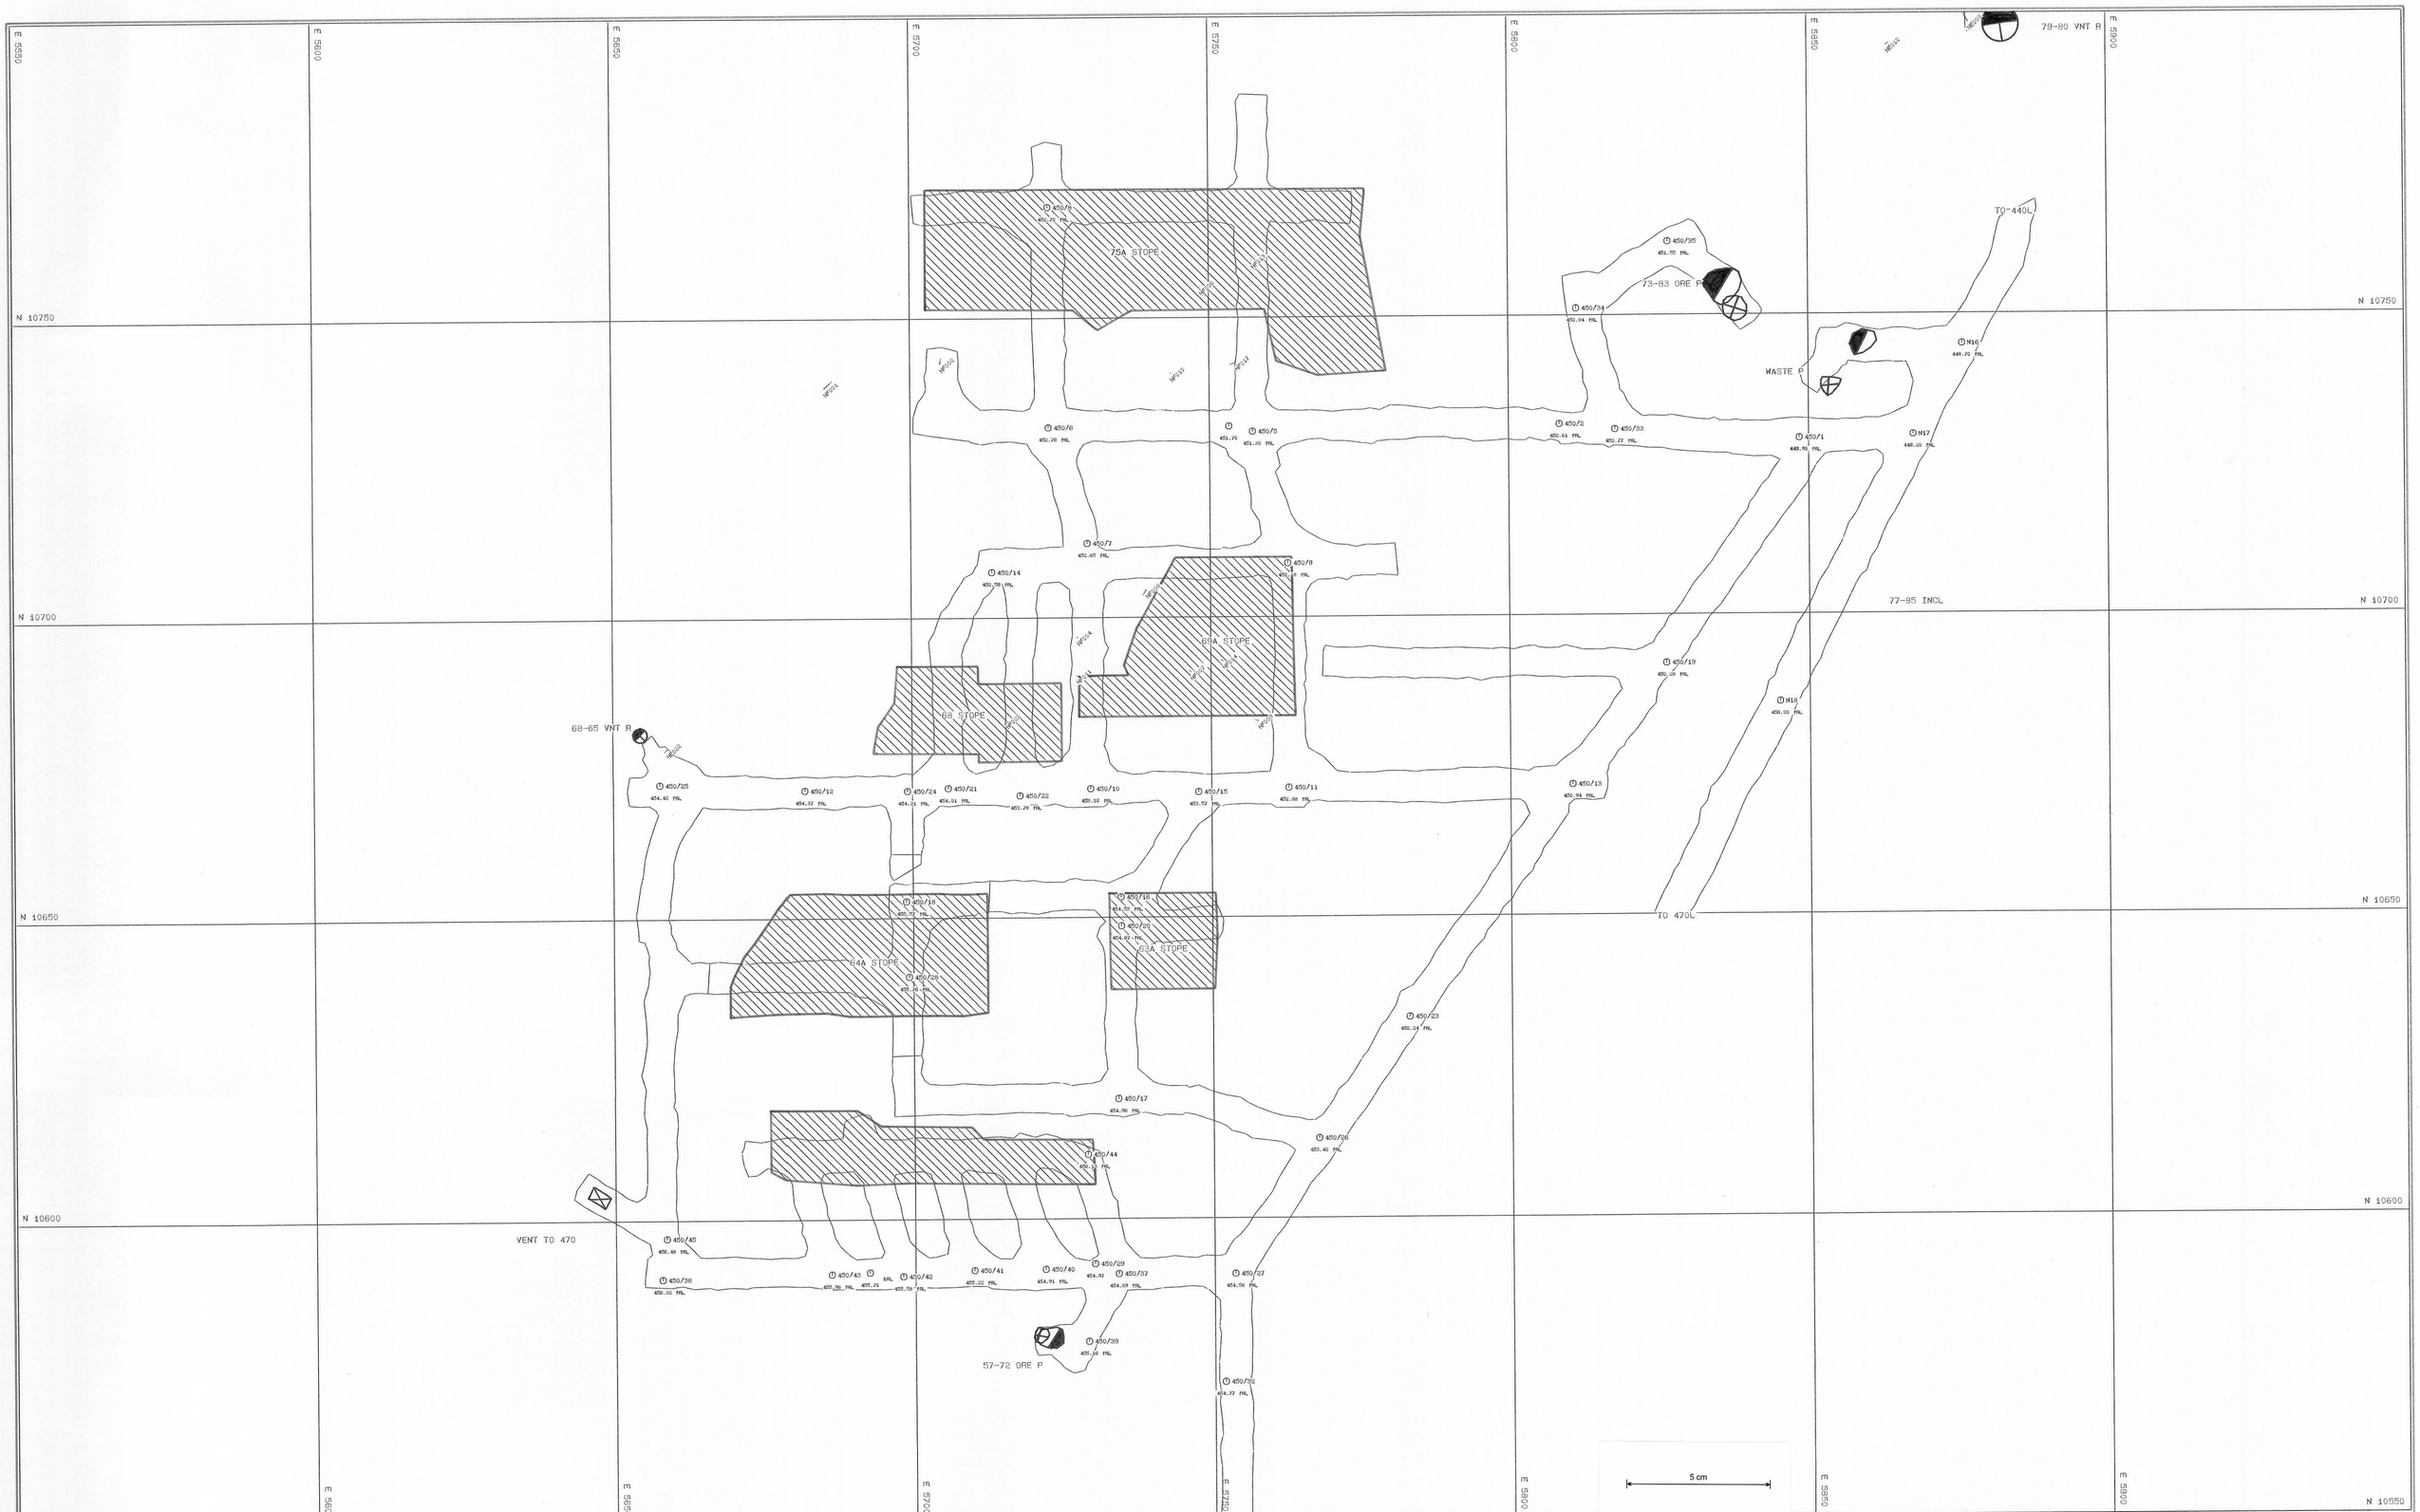

KEY

HP = PROBE HOLE

HA = COMP. AIR HOLE

HV = VENT HOLE

HE = ELECTRICAL HOLE

SCALE 1: 500

DRAWN	DS-AS	15-MAR-93
CHECKED		5-5-93
DESIGNED		
DESIGN CKD.		

ABERFOYLE RESOURCES LTD.
HELLYER DIVISION

HELLYER MINE
LEVEL PLAN

Drawing No. HEL

REVISION