0406 - 075

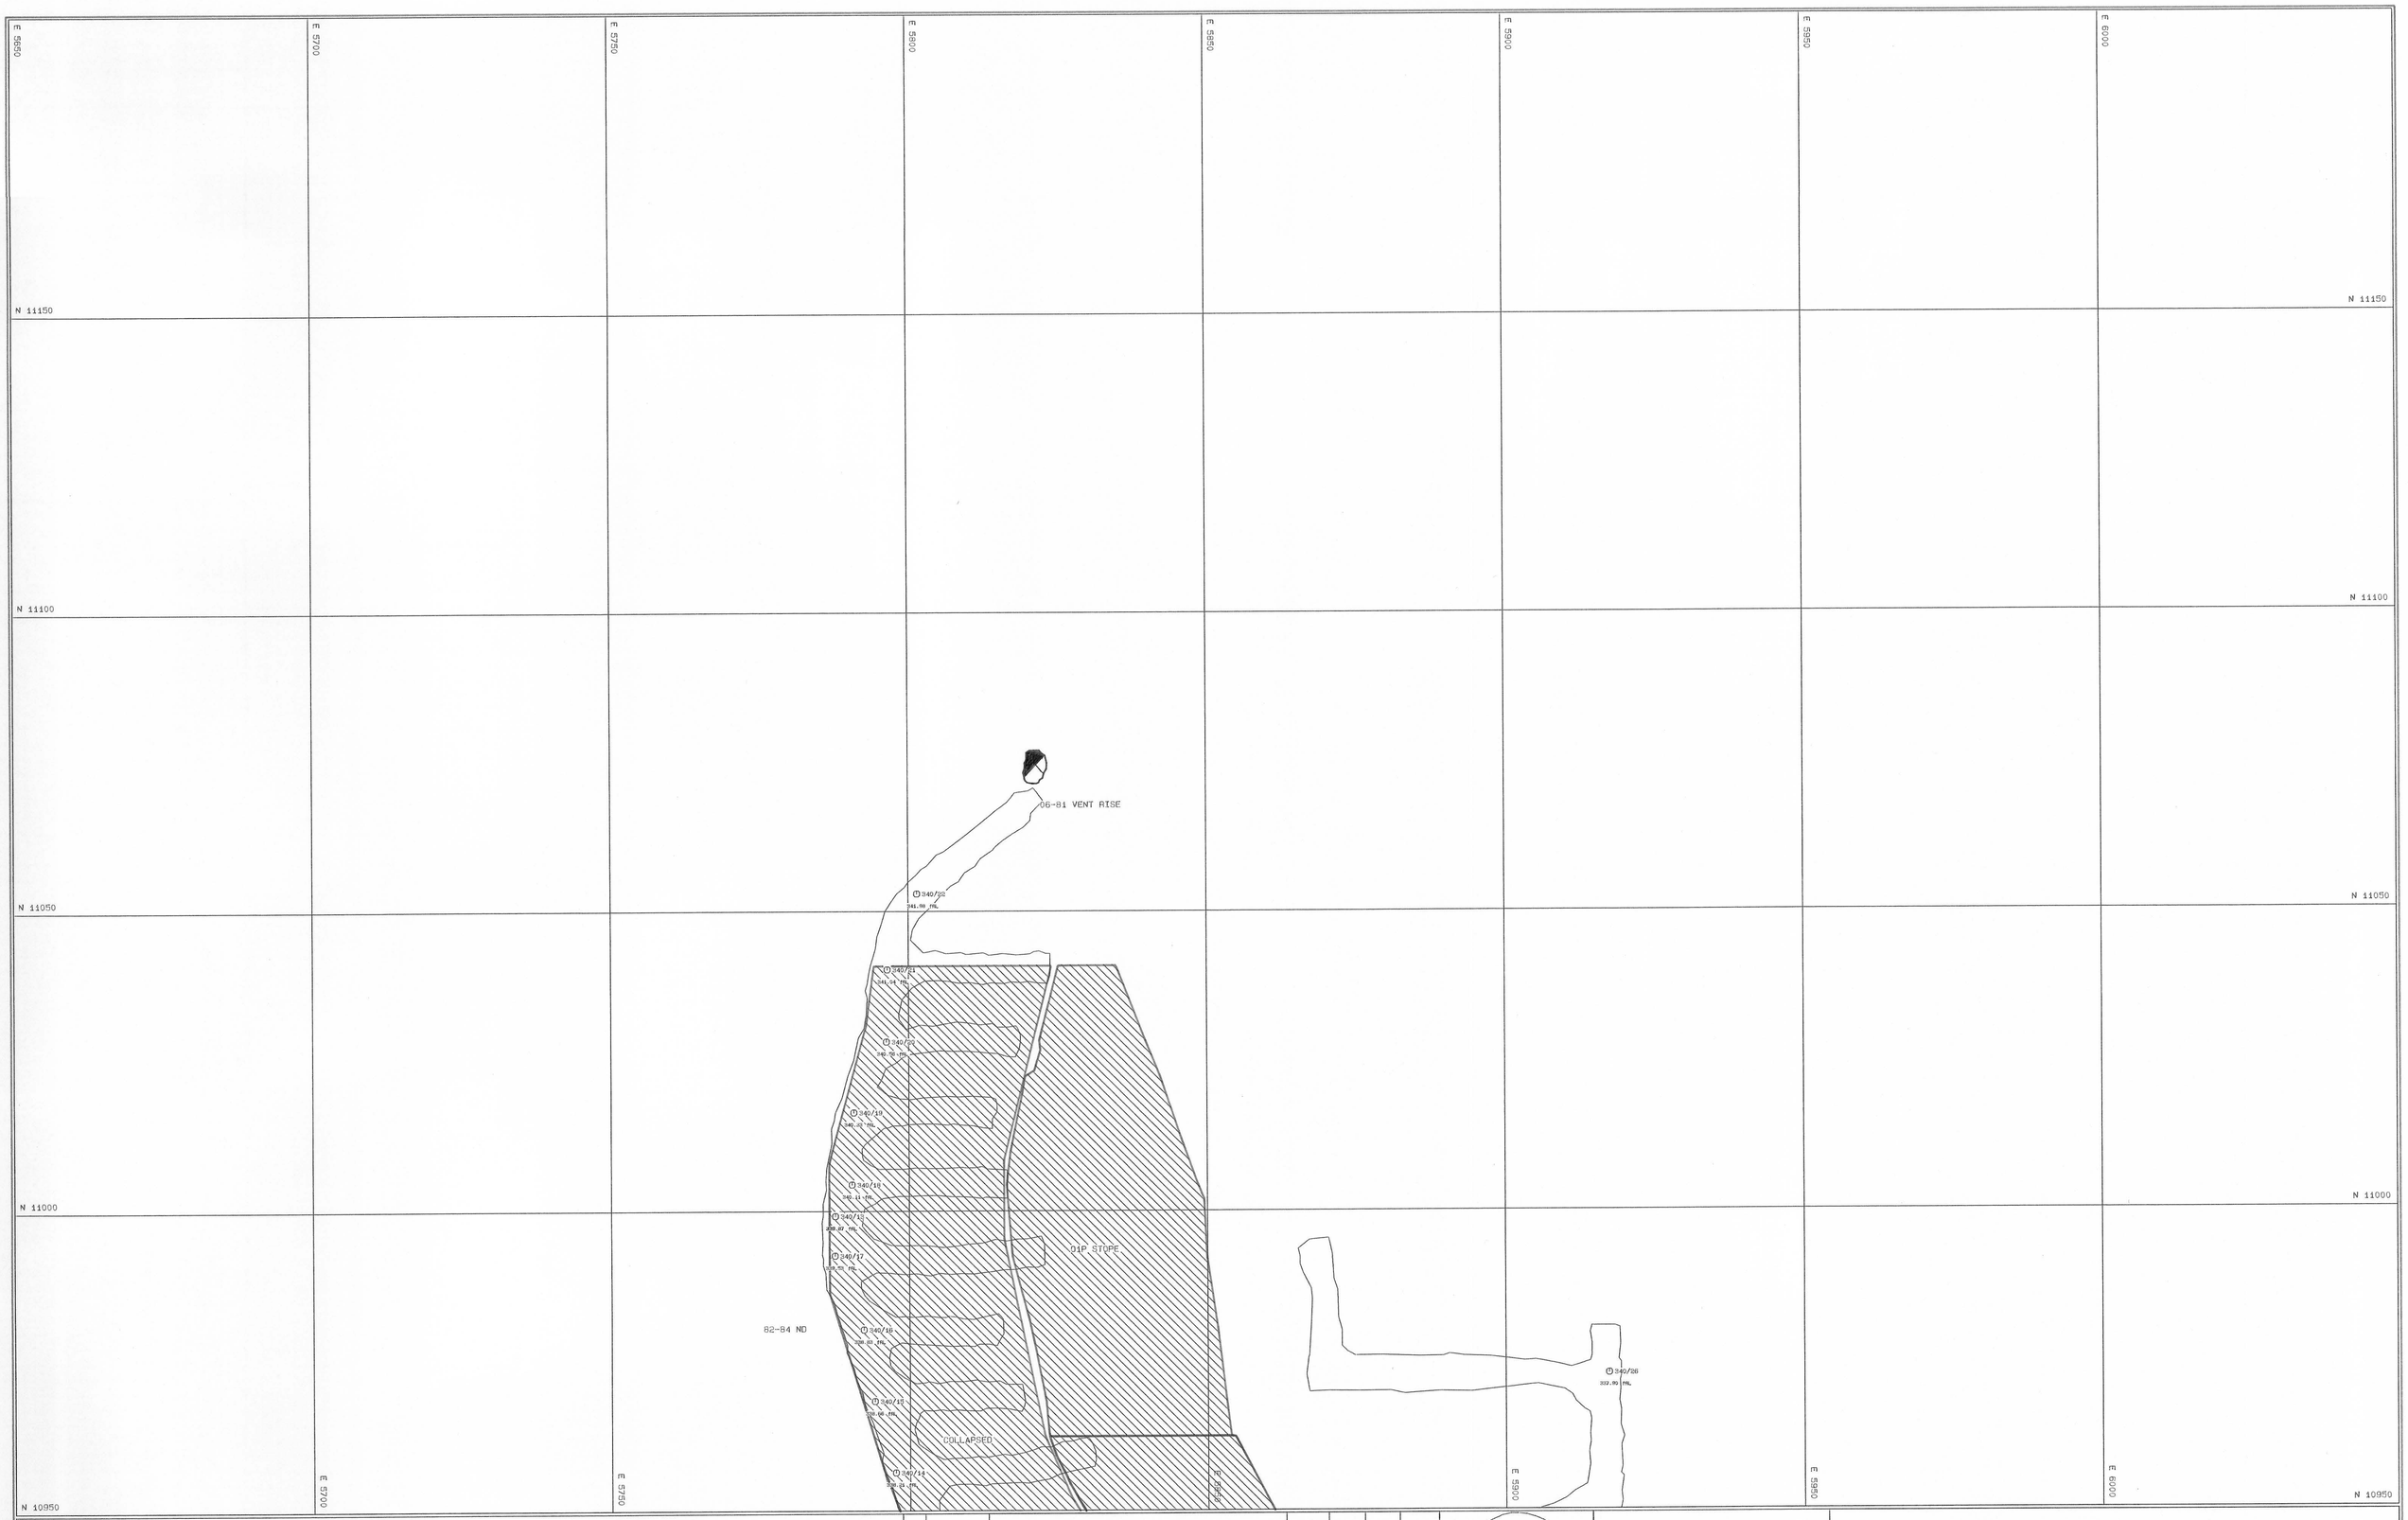

KEY

HP = PROBE HOLE
HA = COMP. AIR HOLE
HV = VENT HOLE
HE = ELECTRICAL HOLE
HW = WATER HOLE
HF = FILL HOLE

REV	DATE	REVISION	DRAWN	CKD	APP	APP

NORTH

SCALE 1: 500

DRAWN	AMS	5-MAR-93
CHECKED	MEZ.	5-3-93
DESIGNED		
DESIGN CKD.		
DESIGN APP.		
PROJECT APP.		

ABERFOYLE RESOURCES LTD.
HELLYER DIVISION

HELLYER MINE
LEVEL PLAN
340m HORIZON

Drawing No. HEL

REVISION

5 cm

ZZZA.PF

SURPAC SOFTWARE INTERNATIONAL, AUSTRALIA