0406 - 082

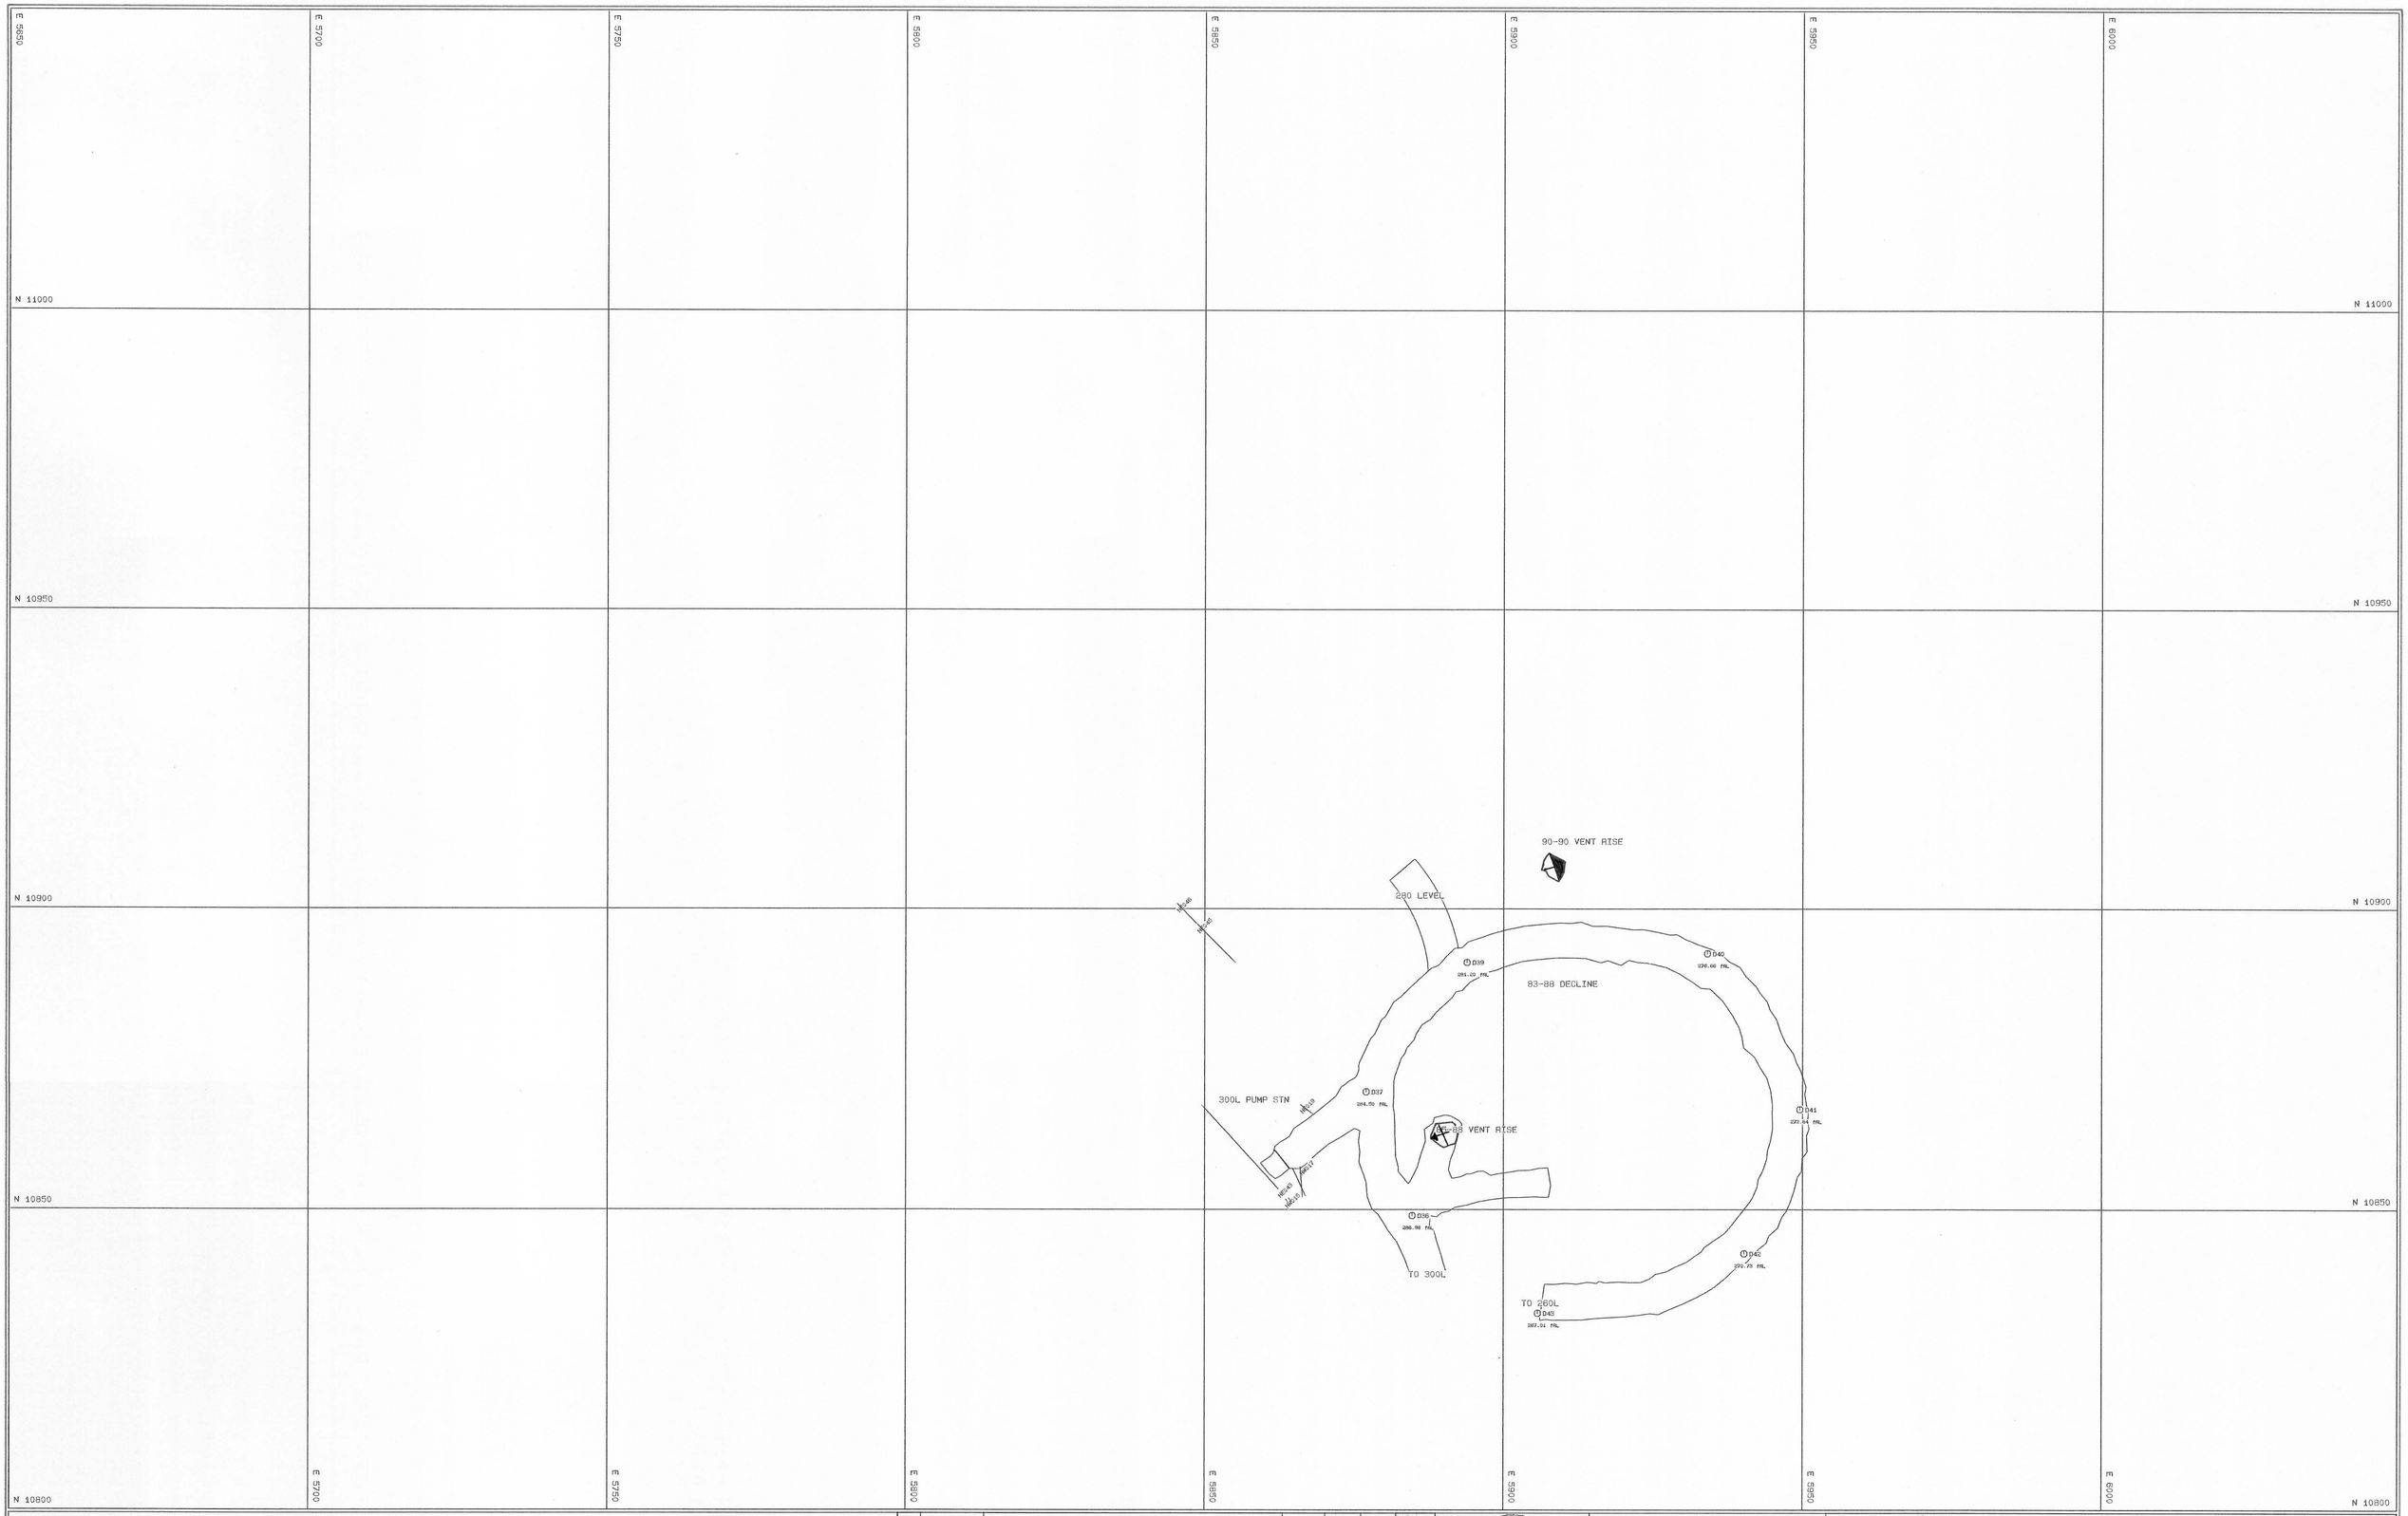


KEY

HP = PROBE HOLE
HA = COMP. AIR HOLE
HV = VENT HOLE
HE = ELECTRICAL HOLE
HW = WATER HOLE
HF = FILL HOLE

| REV | DATE | REVISION | DRAWN | CKD | APP | APP |
|---|---|---|---|---|---|---|

NORTH

SCALE 1: 500

| | | |
|---|---|---|
| DRAWN | AMS | 5-MAR-93 |
| CHECKED | | 5-3-93 |
| DESIGNED | | |
| DESIGN CKD. | | |
| DESIGN APP. | | |
| PROJECT APP. | | |

ABERFOYLE RESOURCES LTD.
HELLYER DIVISION

HELLYER MINE
LEVEL PLAN
280m HORIZON

Drawing No. HEL

REVISION

ZZZA.PF

SURPAC SOFTWARE INTERNATIONAL, AUSTRALIA