0406 - 083

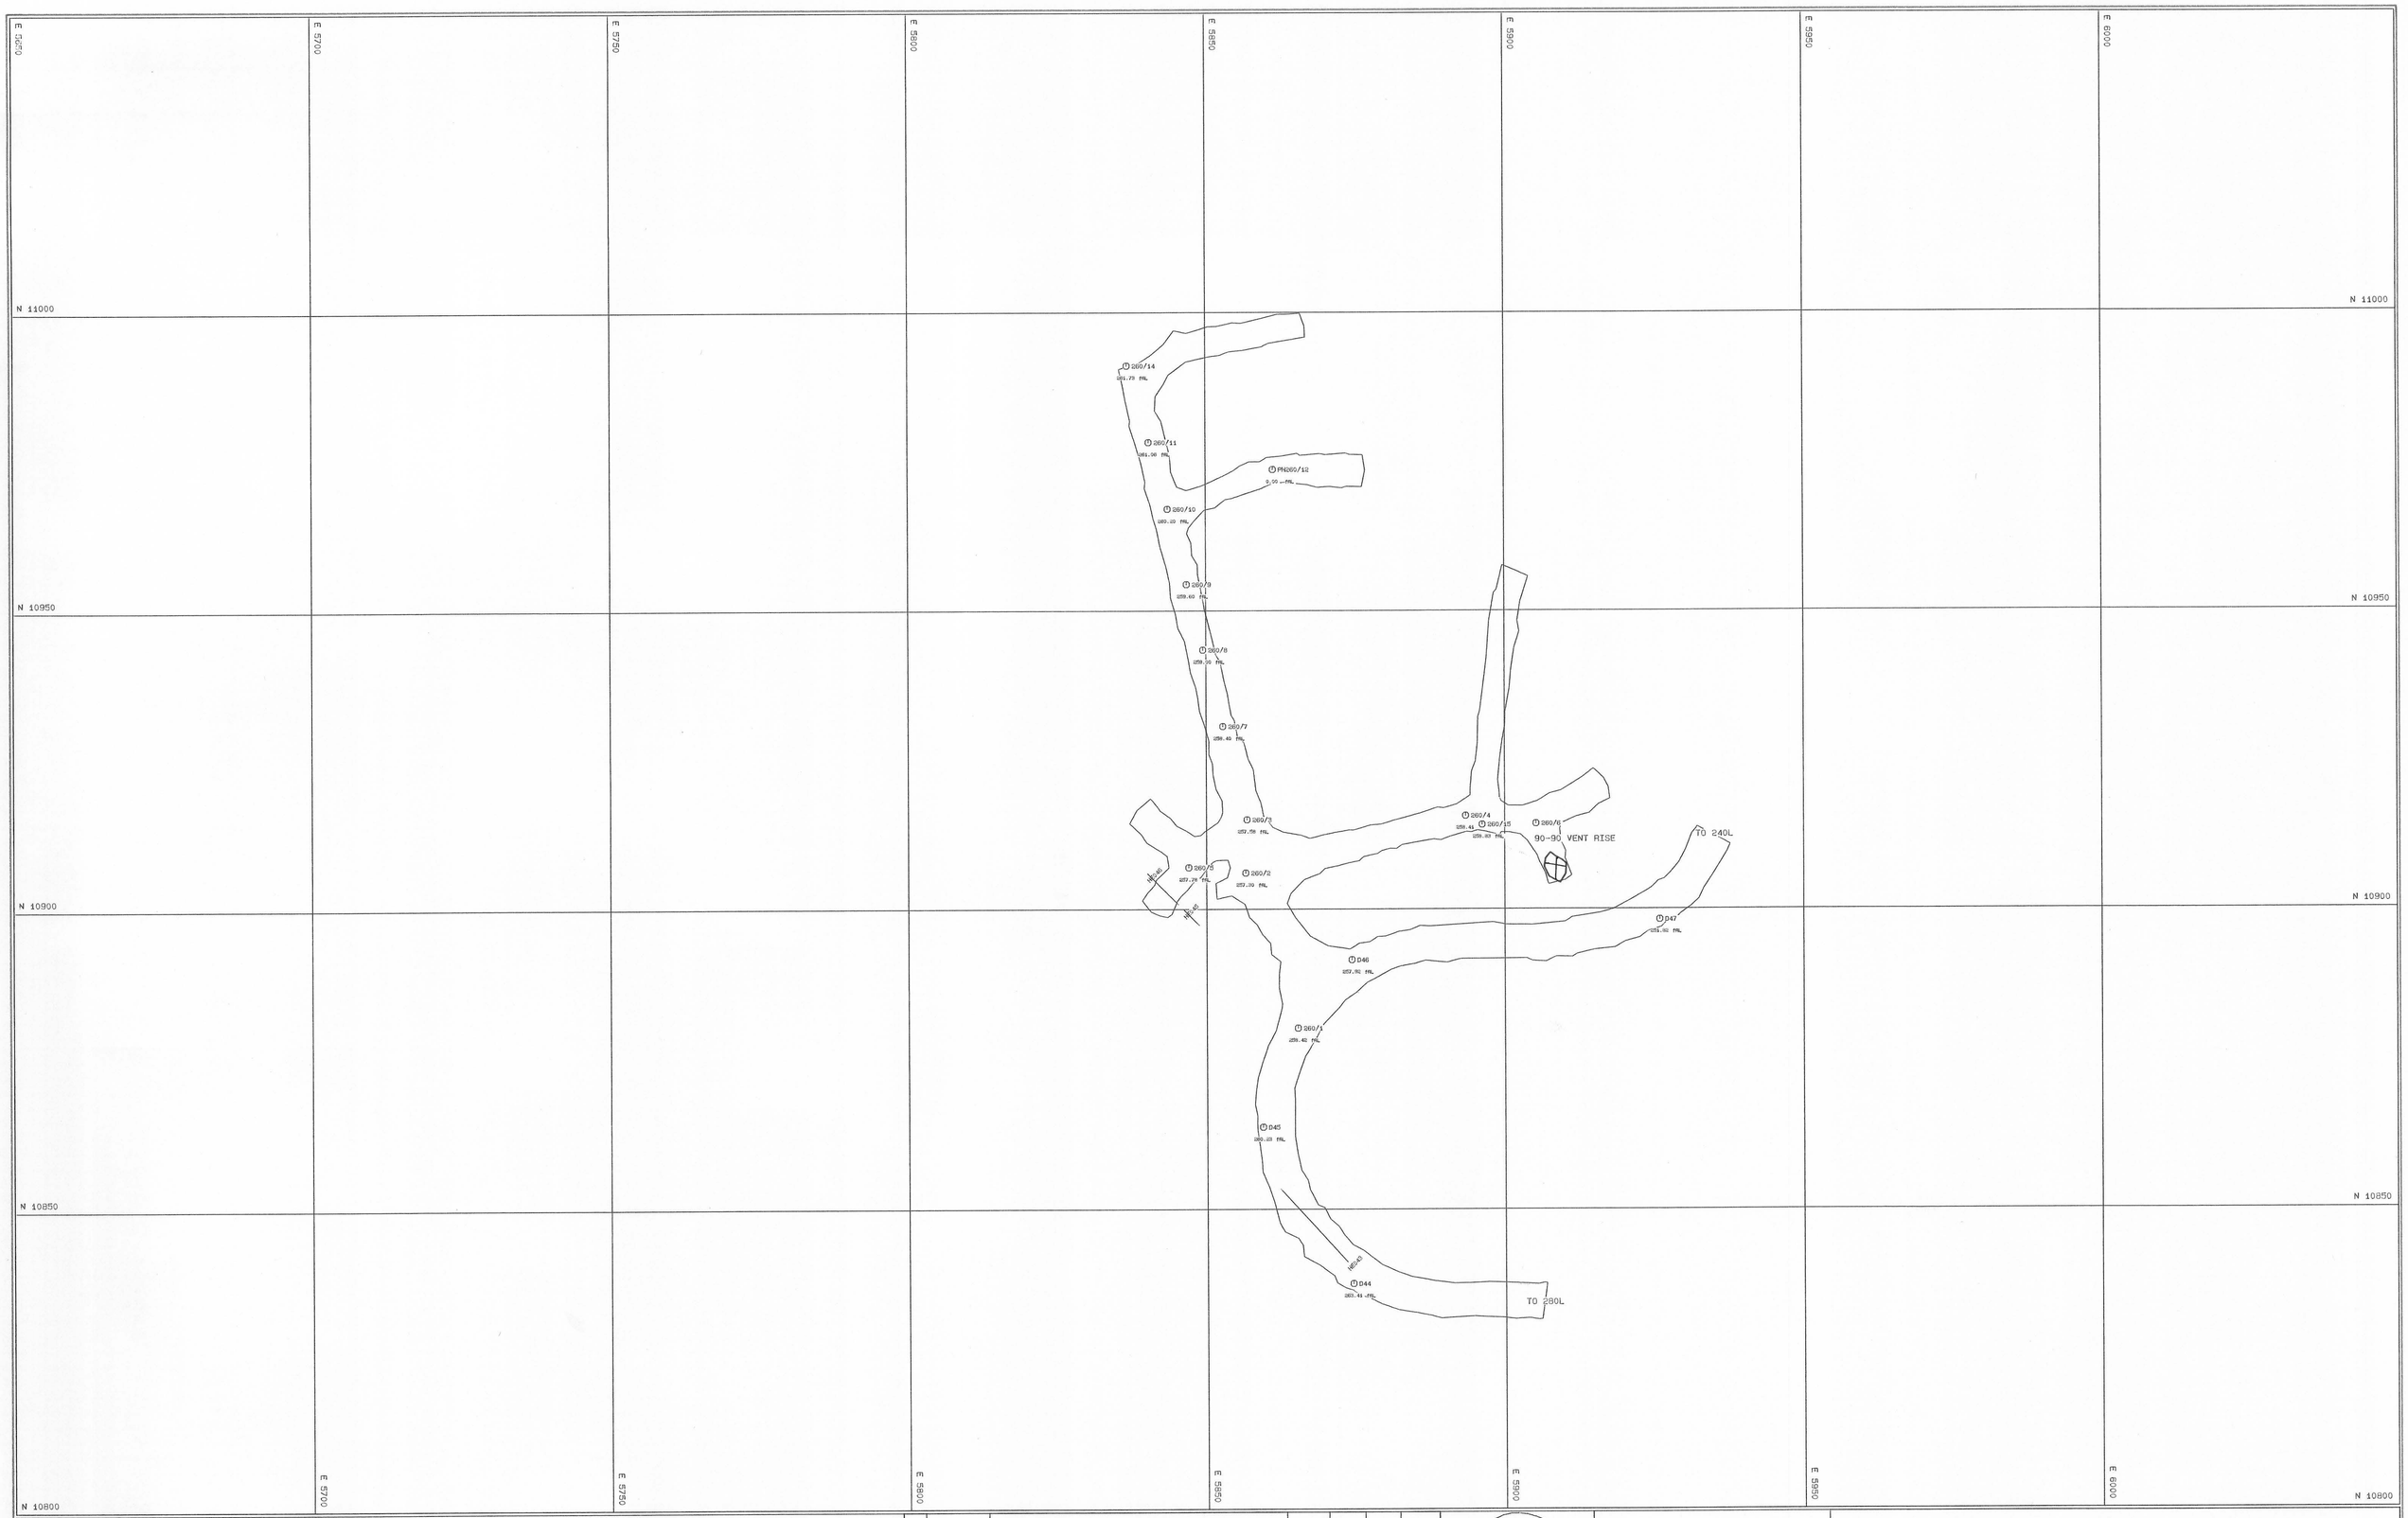

KEY

HP = PROBE HOLE

HA = COMP. ATR HOLE

SCALE 1: 500

DRAWN	ANS	5-MAR-93
CHECKED		5-3-93

ABERFOYLE RESOURCES LTD.
HELLYER DIVISION

Drawing No