0406 - 124

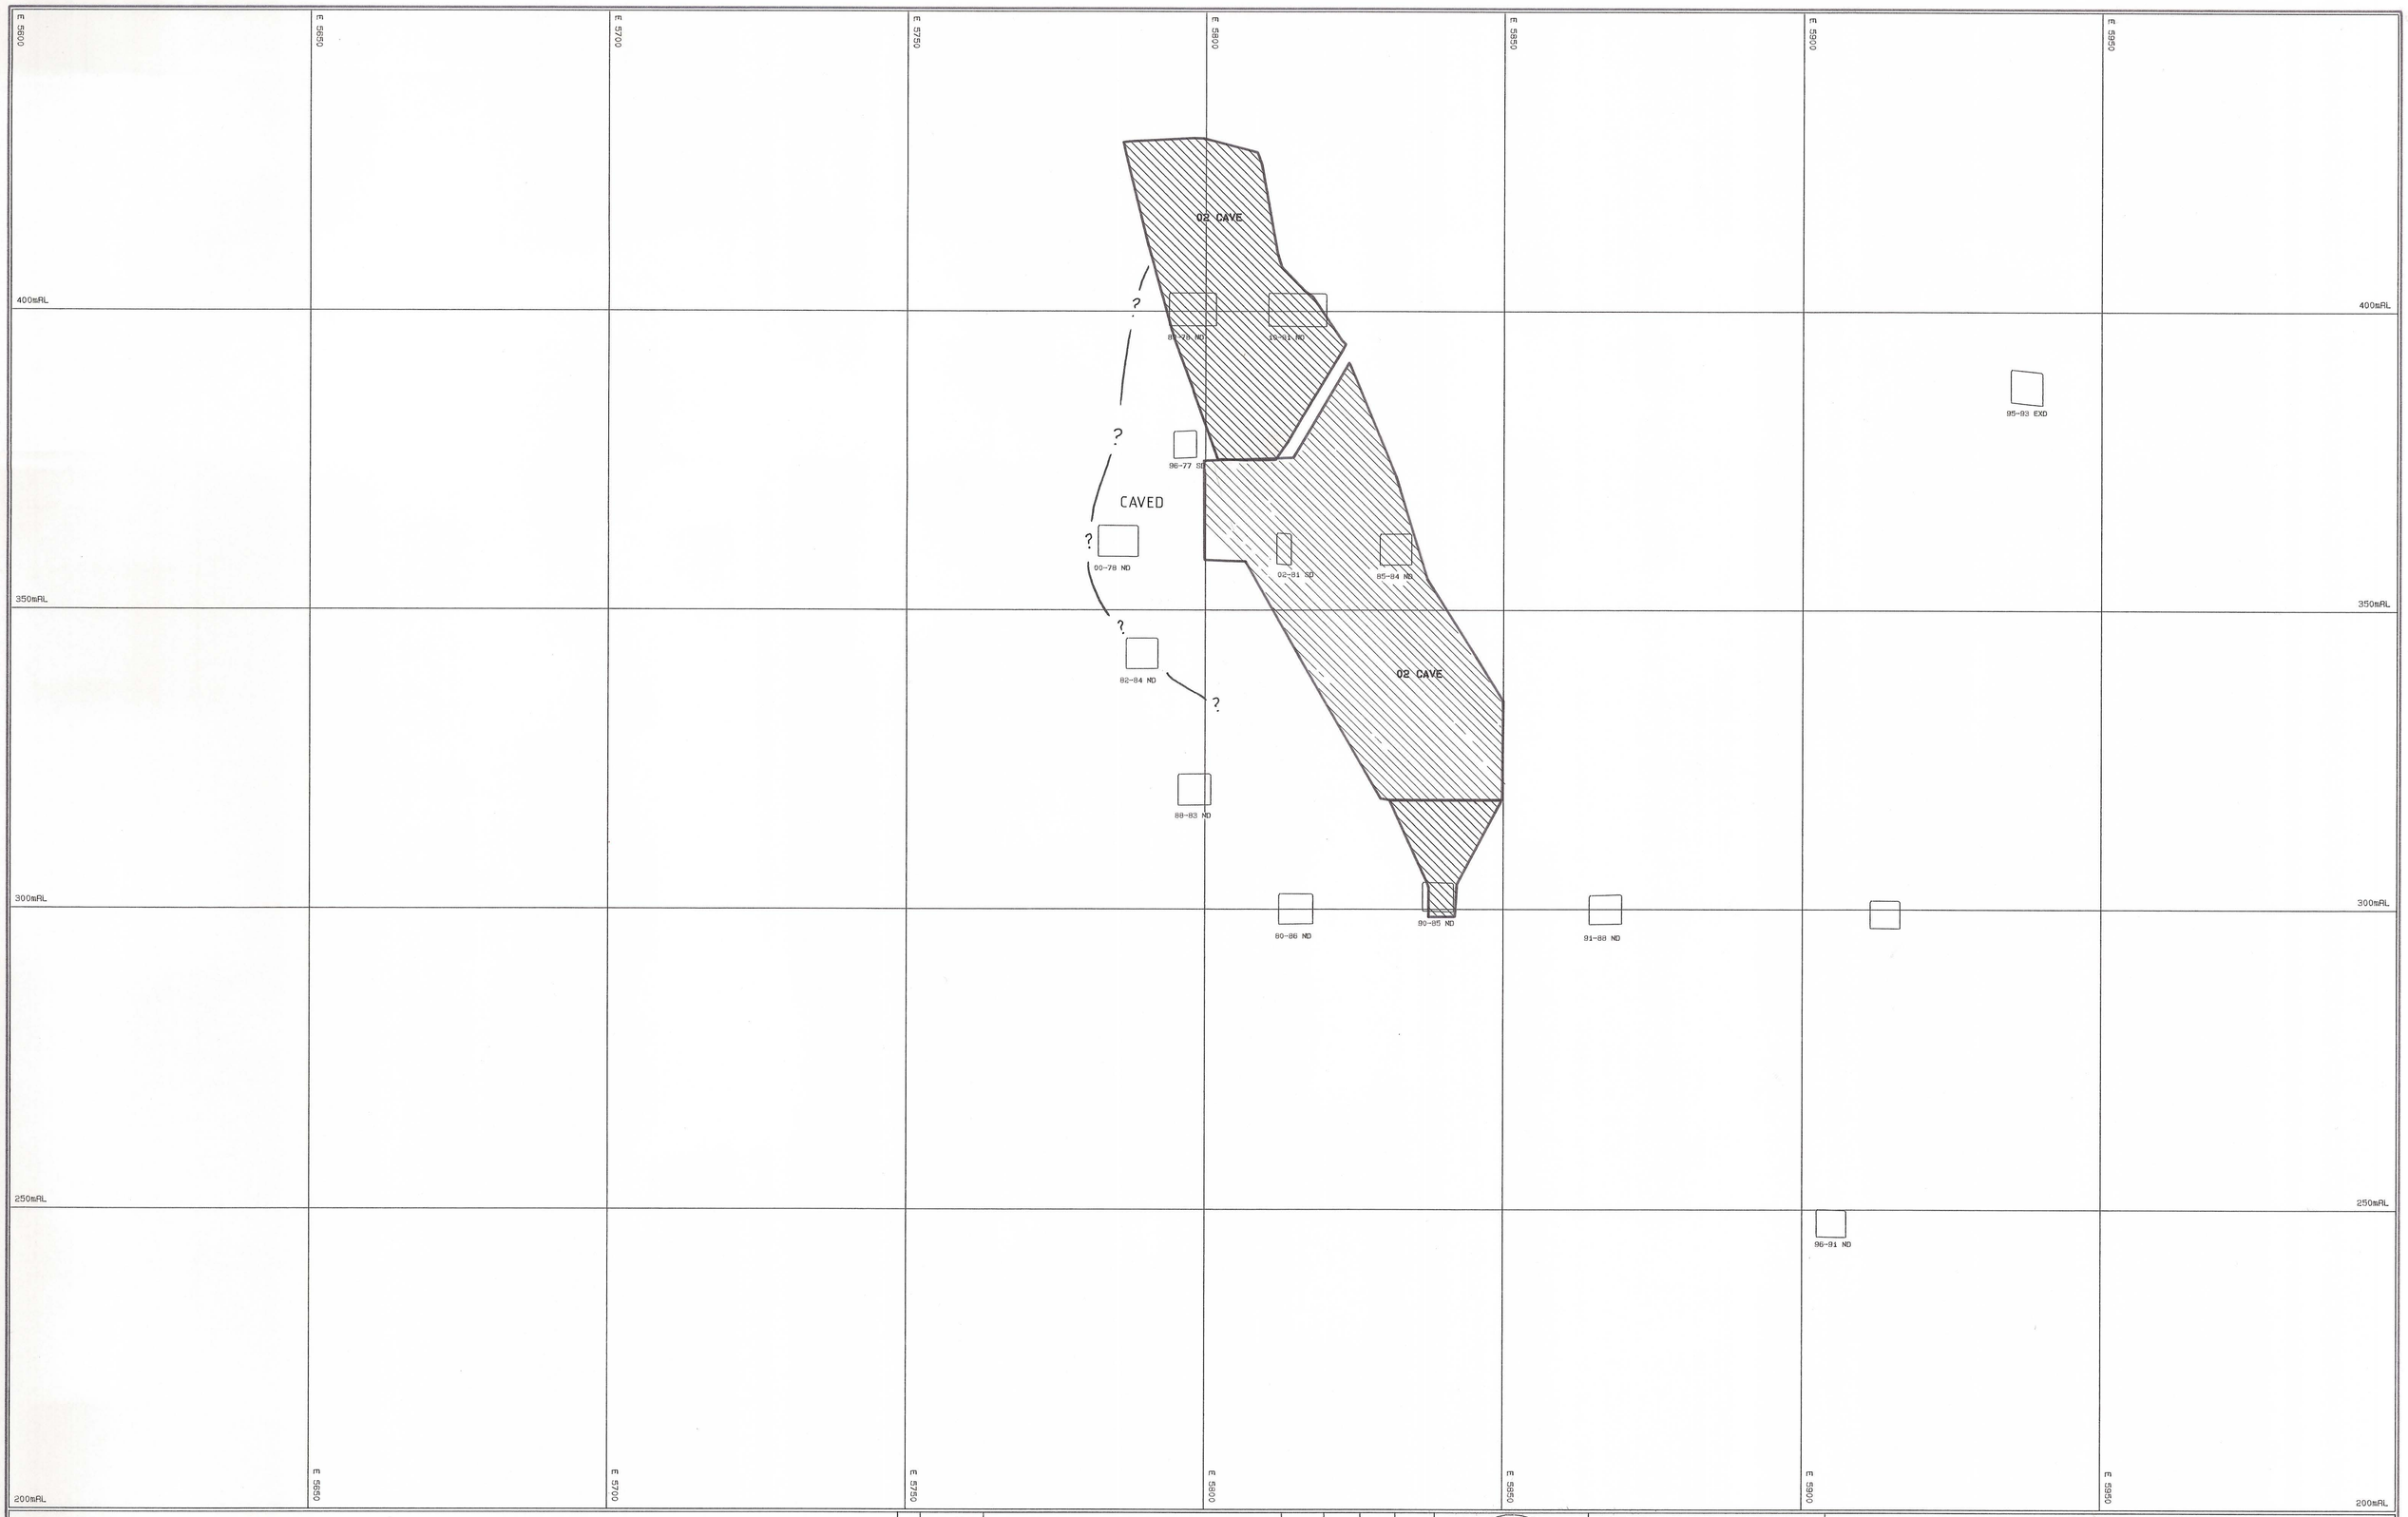

KEY

HP = PROBE HOLE
HA = COMP. AIR HOLE
HV = VENT HOLE
HE = ELECTRICAL HOLE
HW = WATER HOLE
HF = FILL HOLE

REV	DATE	REVISION	DRAWN	CKD	APP	APP

NORTH

SCALE 1: 500

DRAWN		5-MAR-93
CHECKED		5-3-93
DESIGNED		
DESIGN CKD.		
DESIGN APP.		
PROJECT APP.		

ABERFOYLE RESOURCES LTD.
HELLYER DIVISION

CROSS SECTION

11010 NORTH

Drawing No. REF 200 Y

REVISION

MINXG.CF

SURPAC SOFTWARE INTERNATIONAL, AUSTRALIA

5 cm