0406-130

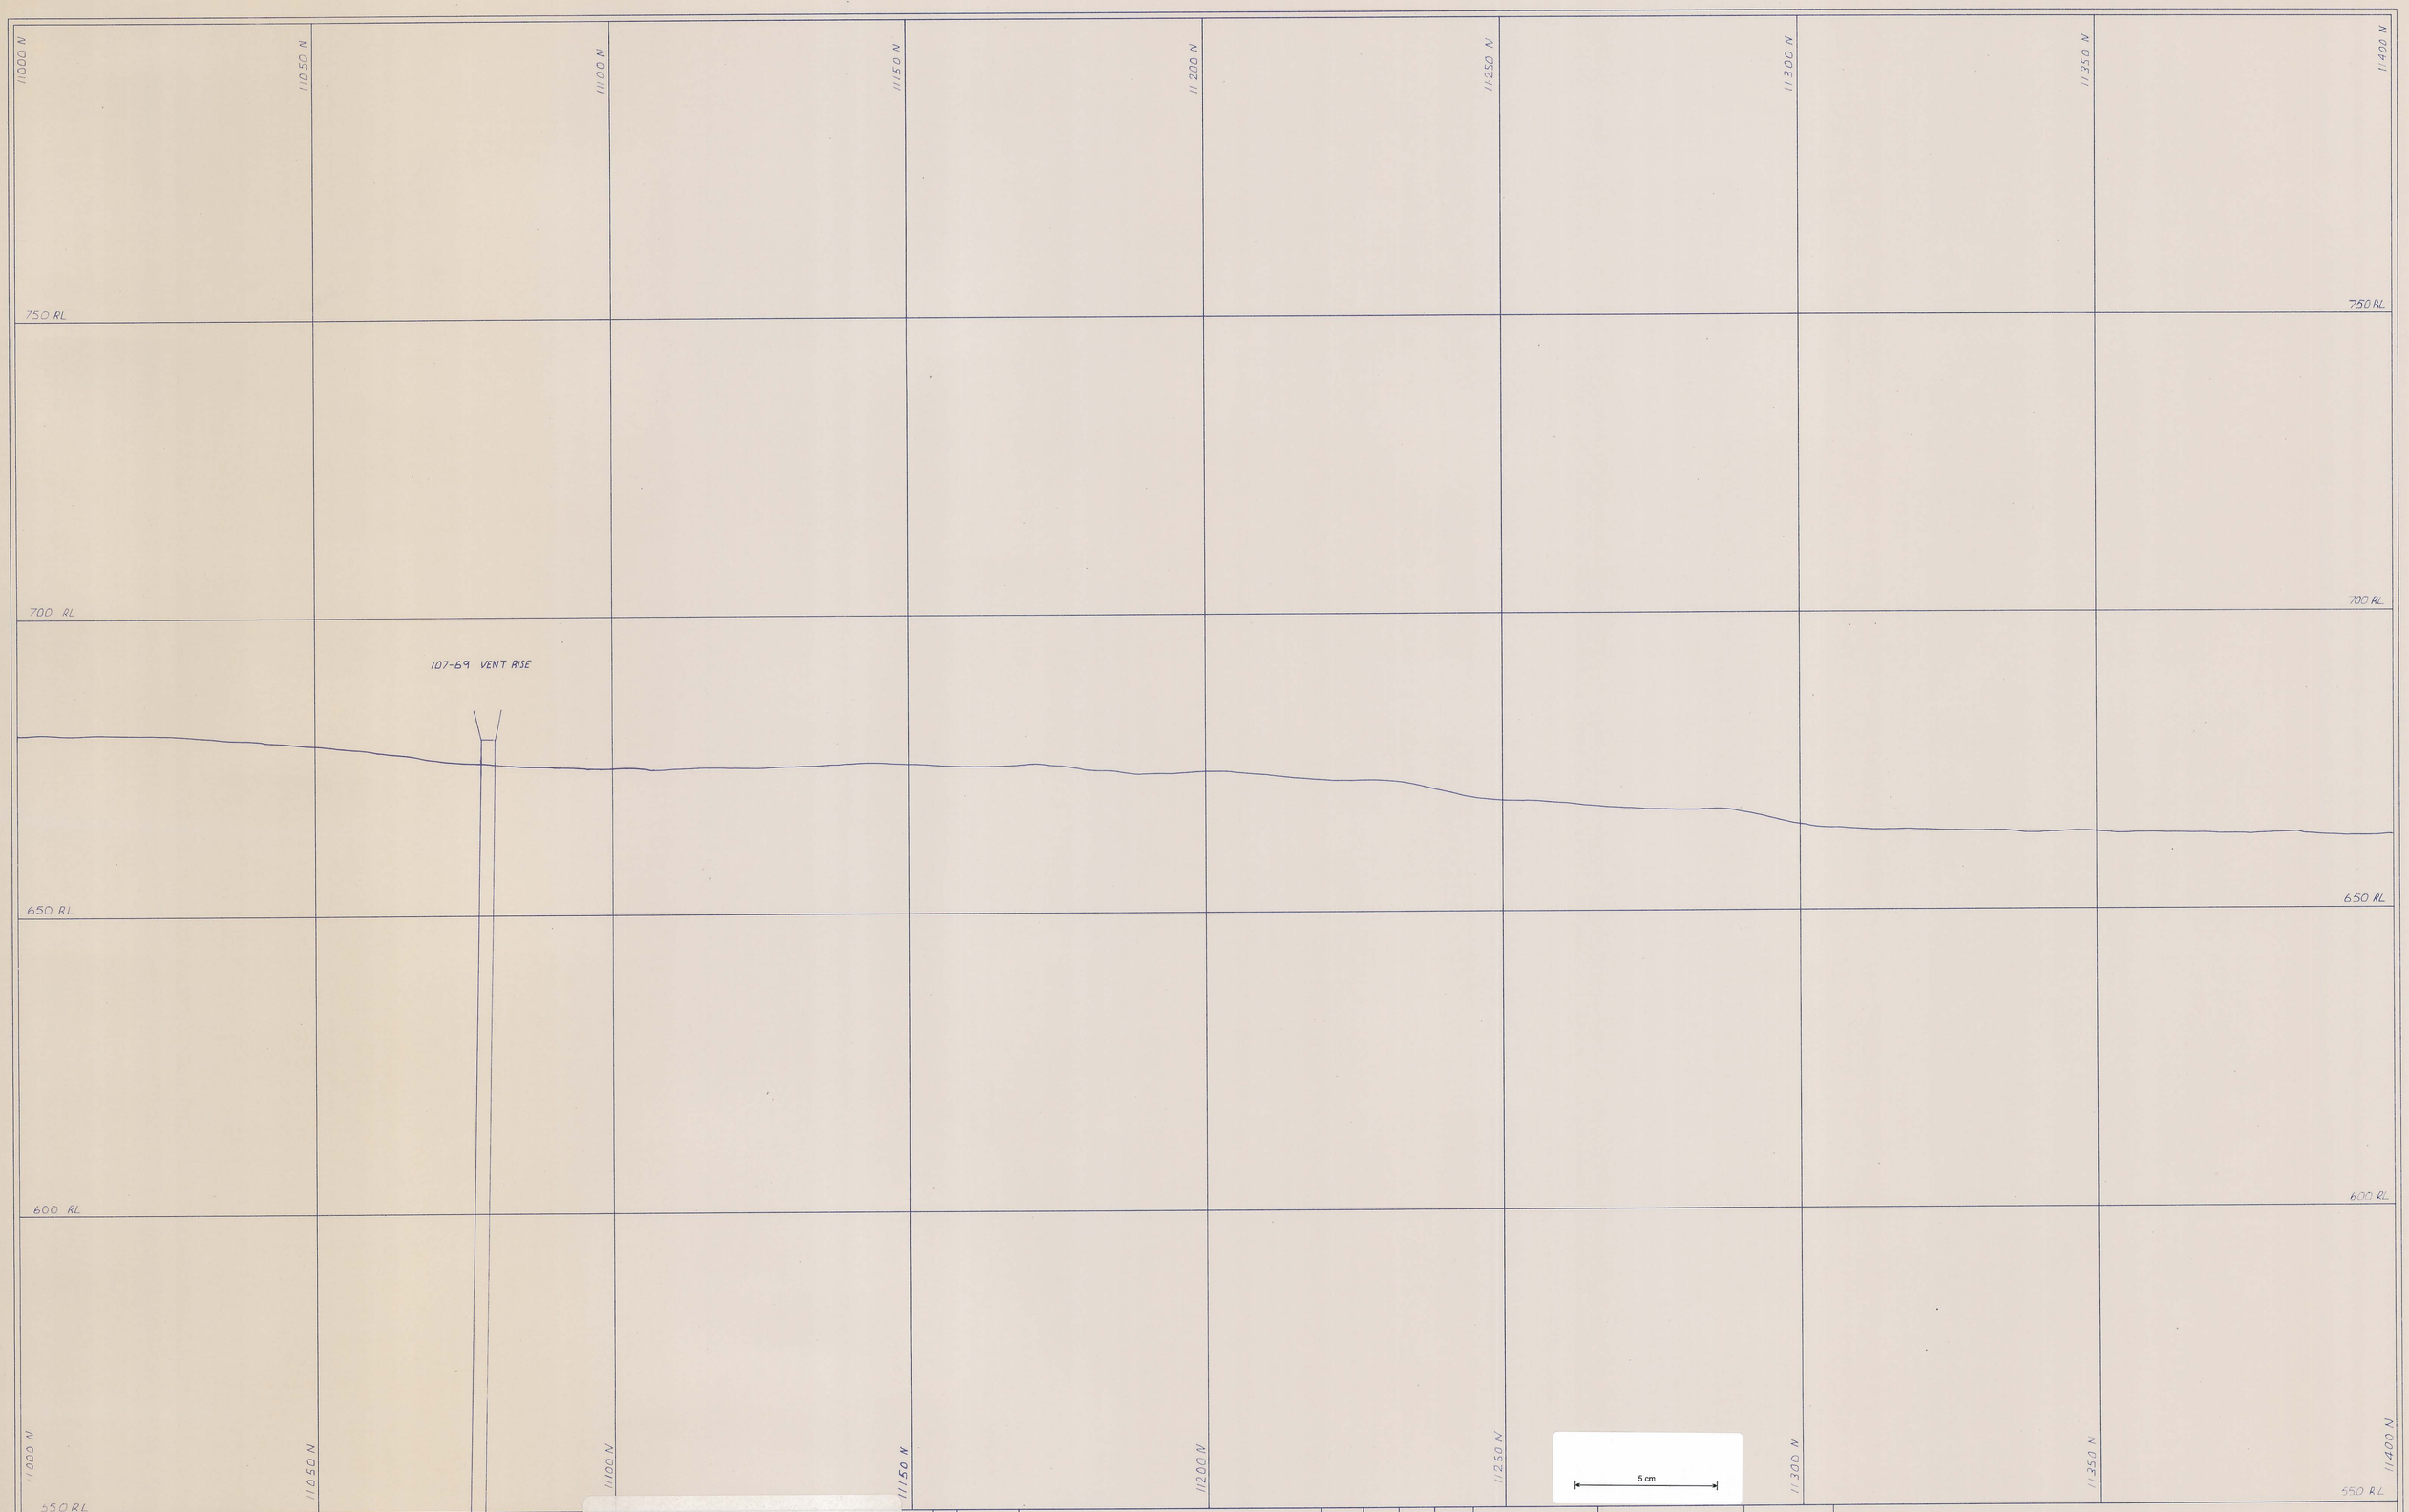

I, Trevor Triffett, hereby certify that this plan/section is a true and fair copy of an original which is maintained in the Survey Office at Hellyer Mine and which was compiled from surveys made in accordance with the Mines Inspection Act 1968 and the Mines Inspection Regulations 1991.

Dated: 26-5-92 Signed: T.L. Triffett
Trevor L Triffett

REV	DATE	REVISION	DRAWN	CKD	APP	APP

NORTH

SCALE 1:500

DRAWN	CP	JAN '88
CHECKED	YY.	5-4-92
DESIGNED		
DESIGN CKD		
DESIGN APP		
PROJECT APP		

Aberfoyle Resources Limited
HELLYER DIVISION

LONGITUDINAL SECTION

DRAWING NO. HEL-010-1147

REVISION