0406 - 135

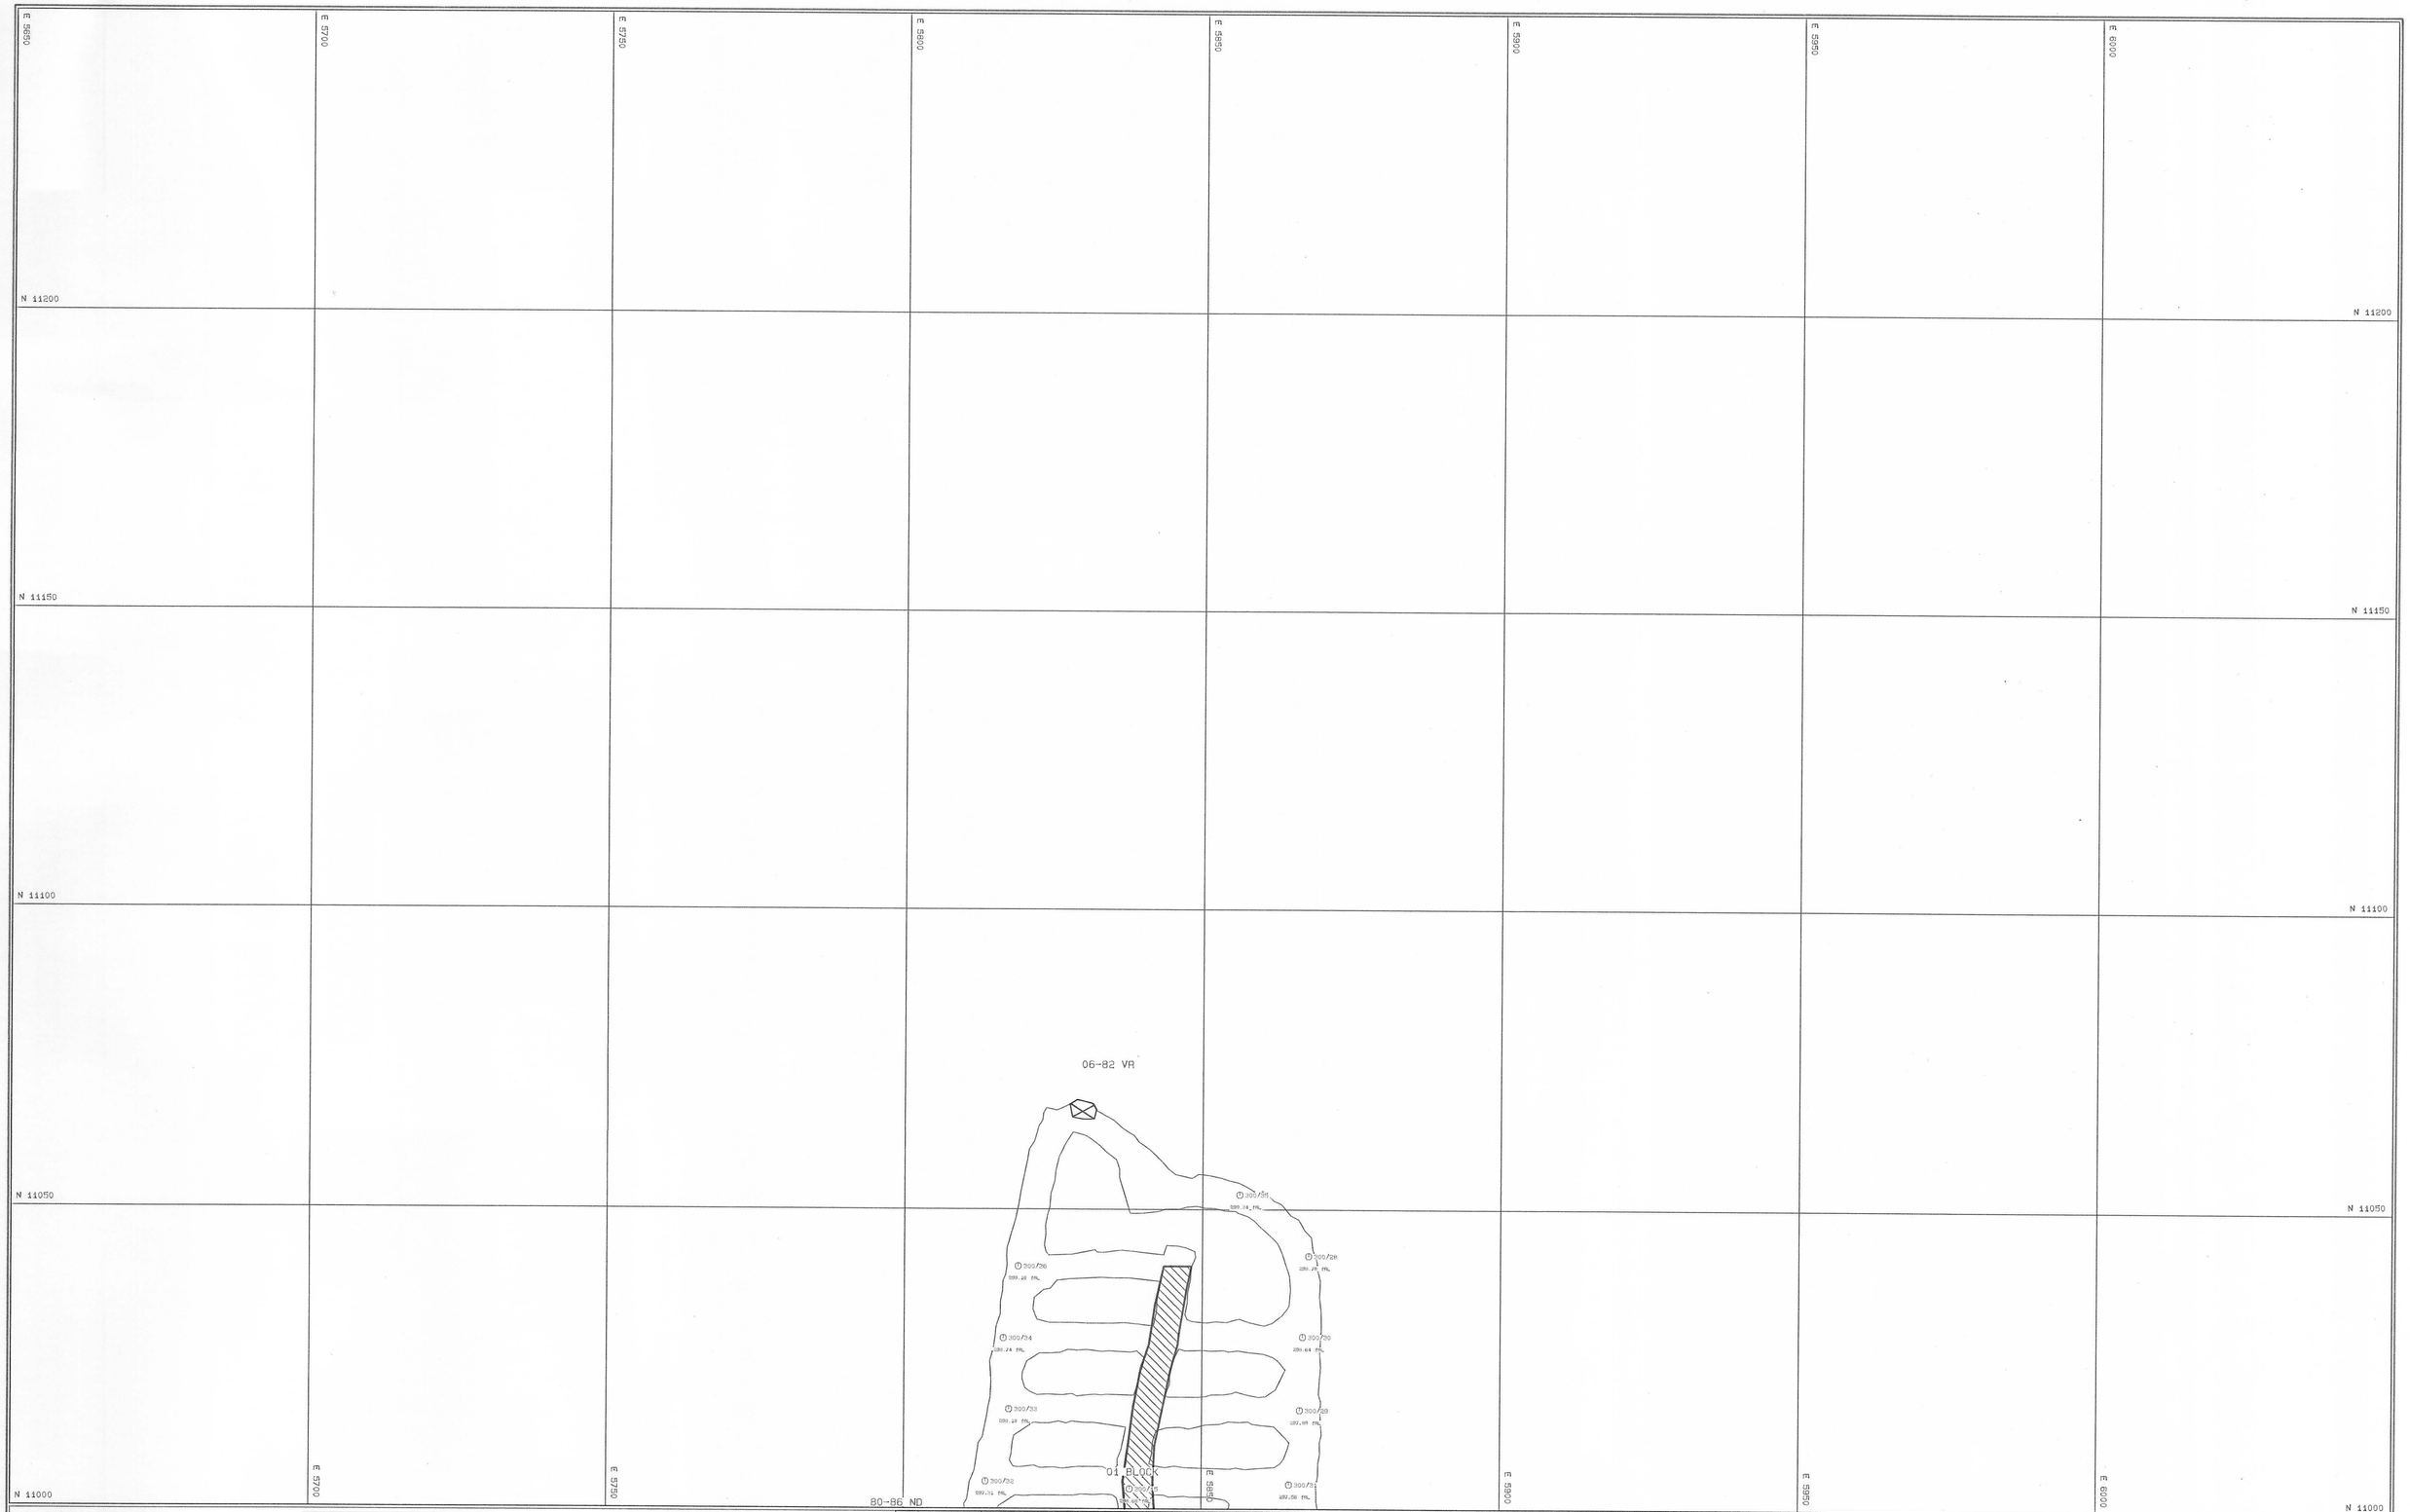

SURPAC SOFTWARE INTERNATIONAL, AUSTRALIA

I, Trevor Triffett, hereby certify that this plan/section is a true and fair copy of an original which is maintained in the Survey Office at Hellyer Mine and which was compiled from surveys made in accordance with the Mines Inspection Act 1968 and the Mines Inspection Regulations 1991.

T.J. Triffett

REV	DATE	REVISION	DRAWN	CKD	APP	APD

NORTH

SCALE 1: 500

DRAWN	DAS	5-FEB-92
CHECKED	TJT.	15-4-92
DESIGNED		
DESIGN CKD.		
DESIGN APP.		
PROJECT APP.		

ABERFOYLE RESOURCES LTD.
HELLYER DIVISION

HELLYER MINE
LEVEL PLAN
300m HORIZON

Drawing No.

REVISION

ZZZA.DF