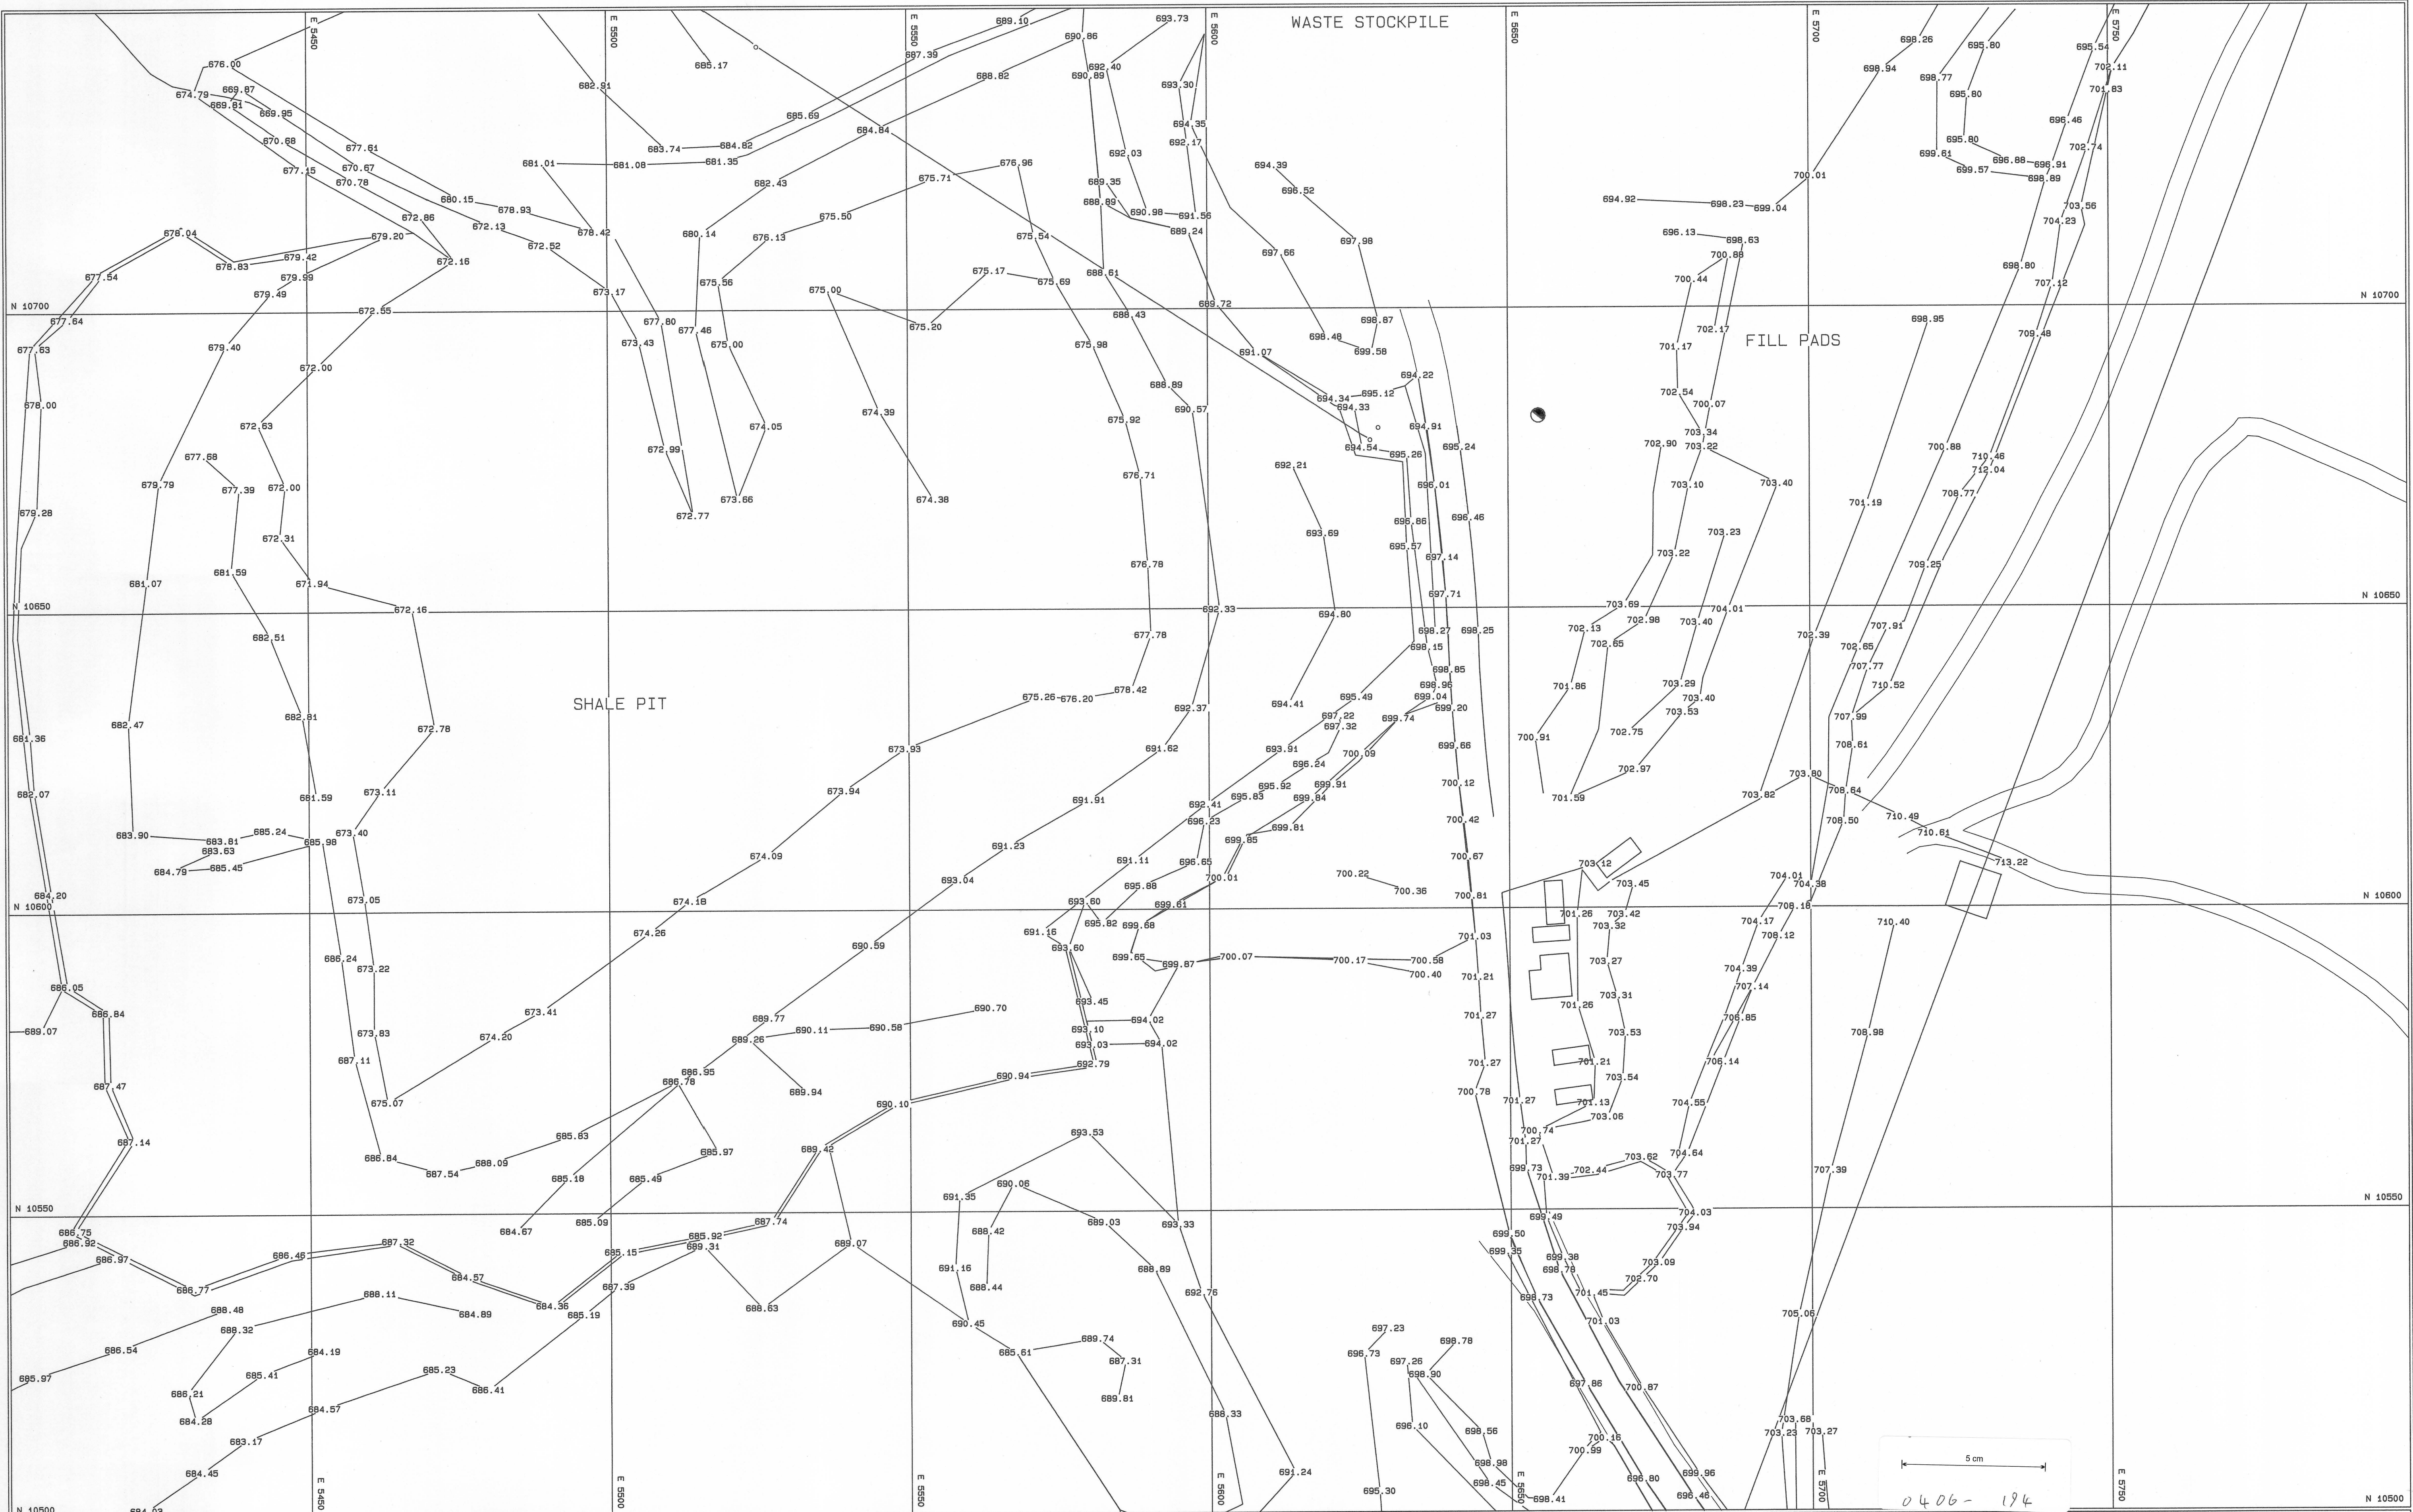


0406 - 194

[illegible]