0406-212

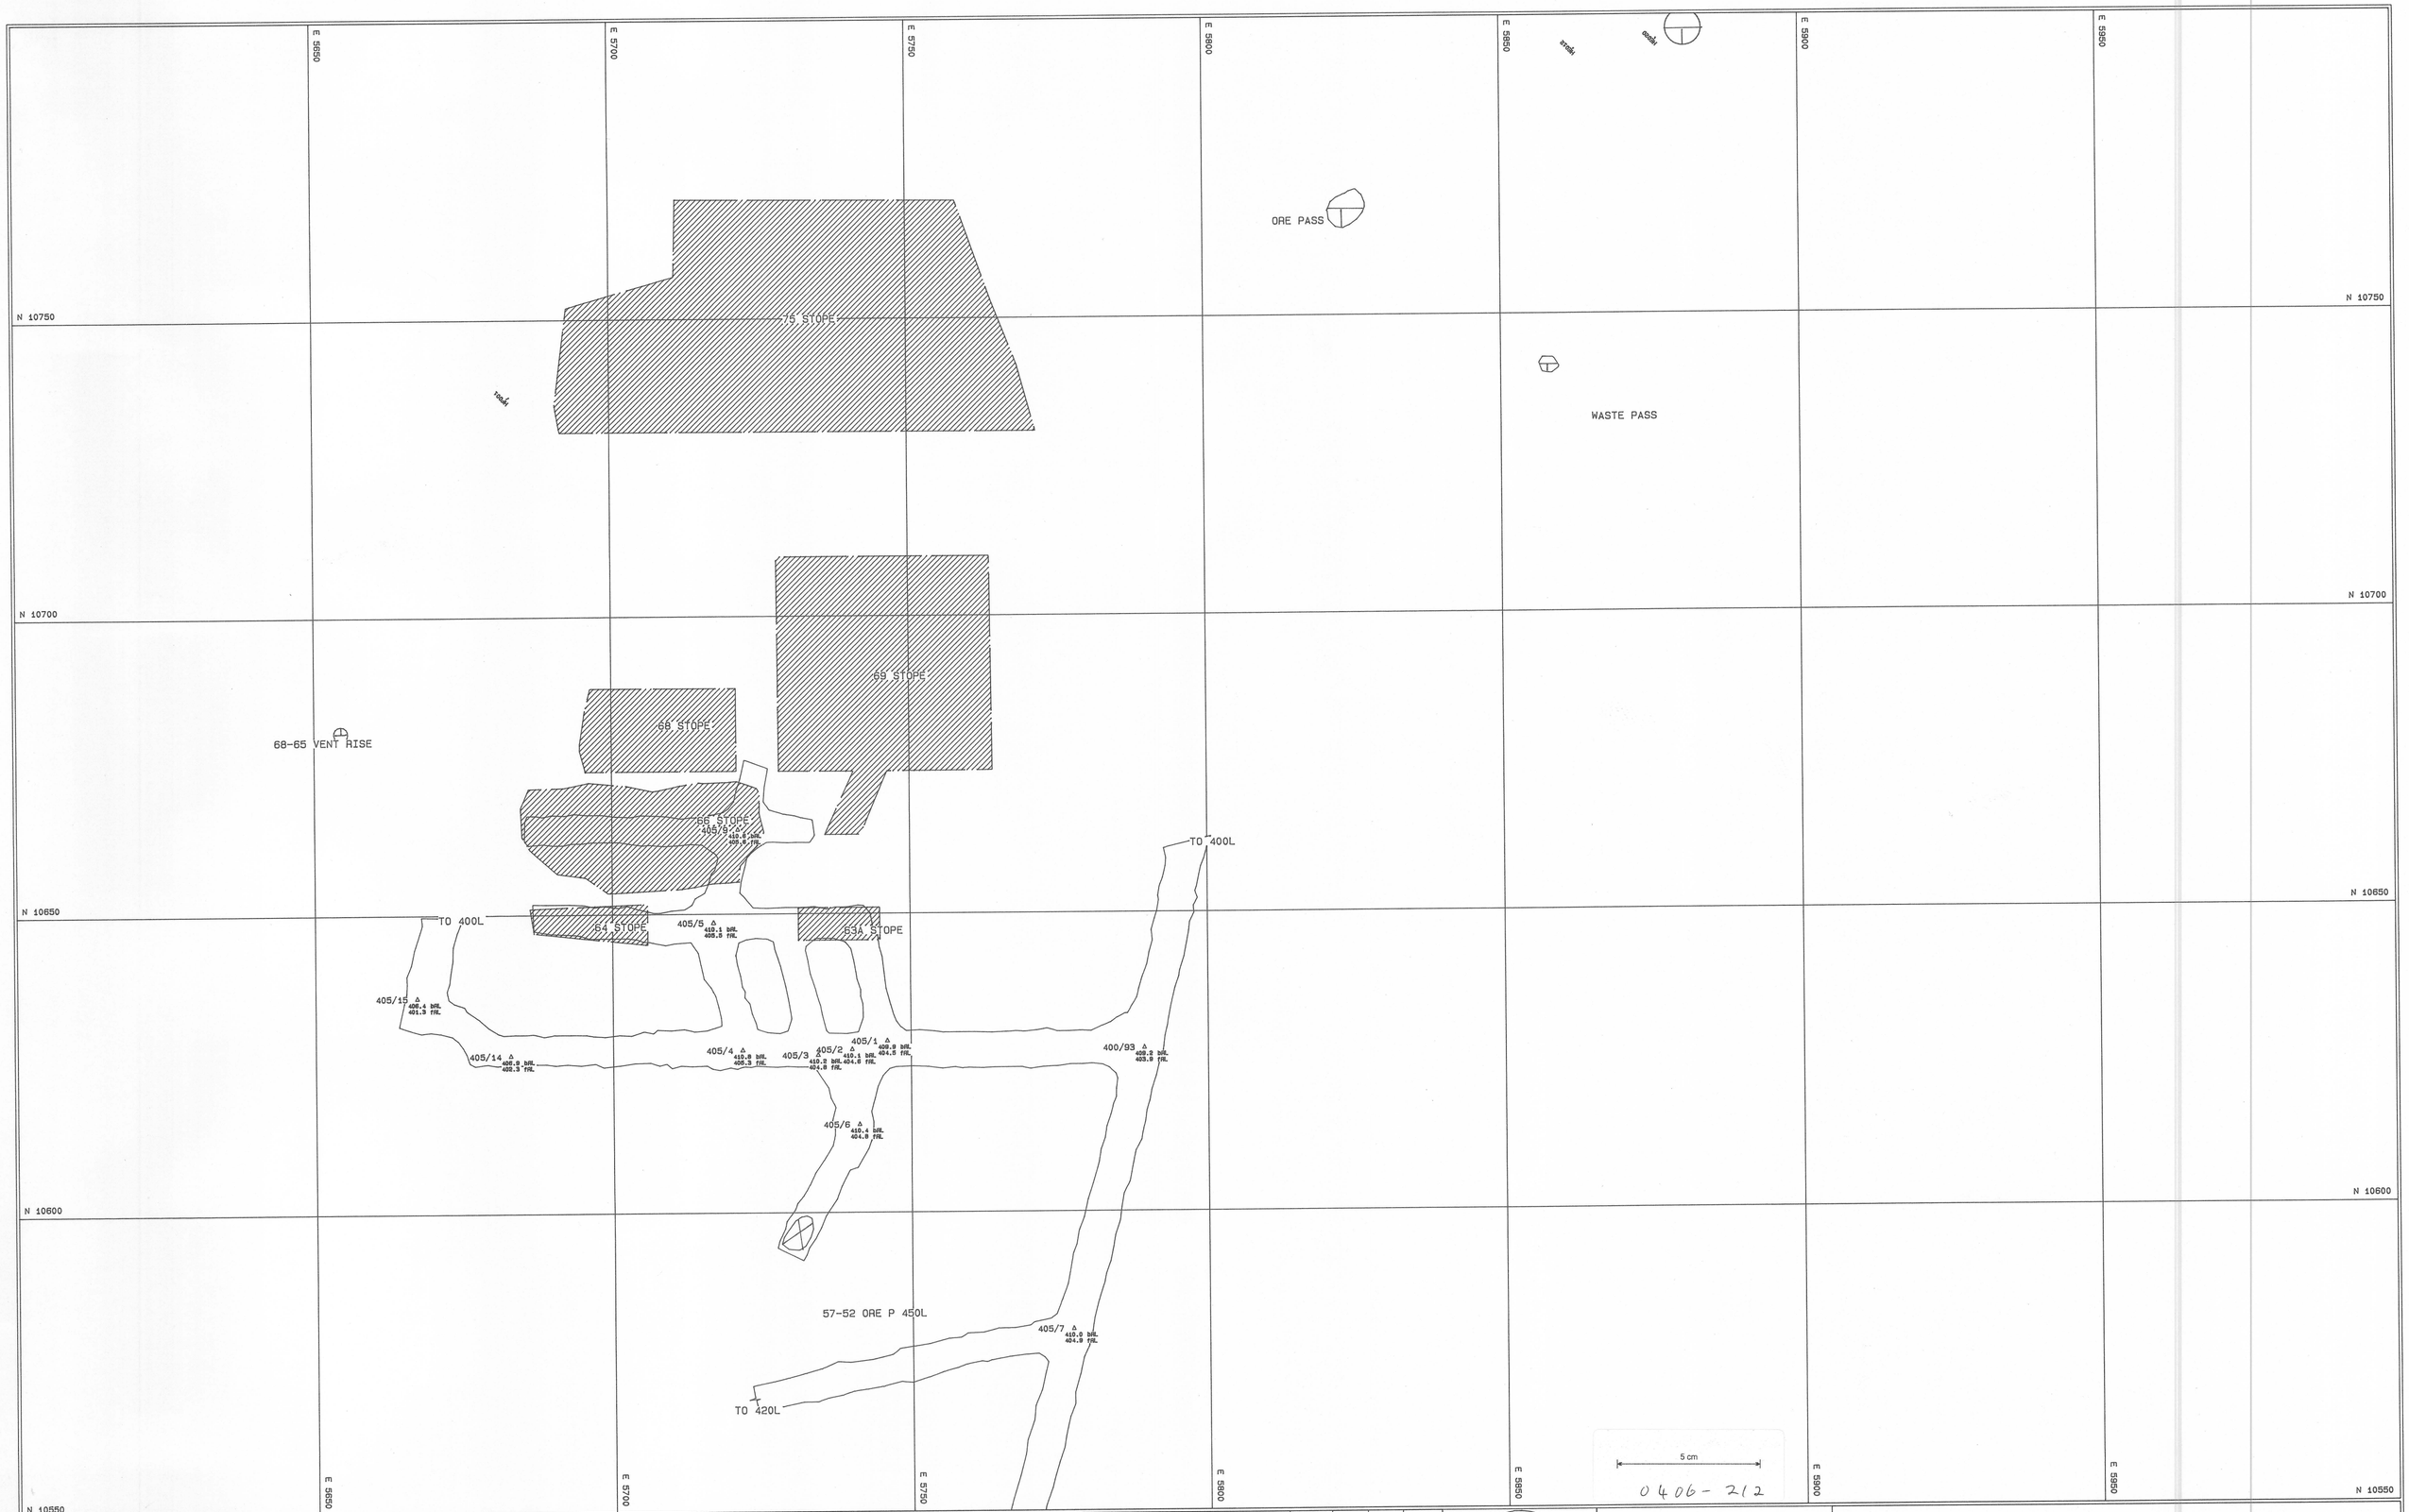

KEY

HP = PROBE HOLE
HA = COMP. AIR HOLE
HV = VENT HOLE
HE = ELECTRICAL HOLE
HW = WATER HOLE
HF = FILL HOLE

REV	DATE	REVISION	DRAWN	CKD	APP	APP

NORTH

SCALE 1:500

DRAWN	DAS	14-Nov-94
CHECKED		18-11-94
DESIGNED		
DESIGN CKD.		
DESIGN APP.		
PROJECT APP.		

ABERFOYLE RESOURCES LTD.
HELLYER DIVISION

HELLYER MINE
LEVEL PLAN
HORIZON 405mRL

Drawing No.

REVISION

zzza.pf

SURPAC SOFTWARE INTERNATIONAL, AUSTRALIA